

9/21/70

70-101-70
10/14/68

PERMIT

P. 15475

A. 13070

SEWAGE DISPOSAL SYSTEM

MARYLAND STATE DEPARTMENT OF HEALTH

HOWARD COUNTY

ELLICOTT CITY

DISTRICT 1

INDEXED

DATE 9/18/70

Robert Dubin Co. IS PERMITTED TO INSTALL 2 ALTER
ADDRESS Route 2, Clarksville, Md. PHONE 285-2432

A SEWAGE DISPOSAL SYSTEM LOCATED AT _____

SUBDIVISION Woodmark, Inc. ROAD Ioka Court LOT 24, Blk. B, No. 3

PROPERTY OWNER M. A. Wakefield

ADDRESS _____

SPECIFICATIONS - 3 OR 4 bedrooms

DRAIN FIELD _____ DEPTH _____ FEET, BOTTOM AREA _____ SQ. FT.

SEEPAGE PITS _____ ABSORBENT SIDE-WALL AREA _____ SQ. FT.

SEPTIC TANK CAPACITY 759 GALLONS for 3 bedrooms
1,000 " " " " " "

FOR GARBAGE GRINDER, INCREASE DISPOSAL AREA 22% & TANK CAPACITY 50%.

OTHER Dry well - 100 sq. ft. absorbent sidewall area per bedroom to begin below

inlet pipe. Max. depth permitted for dry well below original grade is 12 ft.

Place dry well 39 ft. from front lot line and 21 ft. from right side line as seen when

facing lot from Ioka Court.

NOTE: ALL PIPE FROM HOUSE TO SEPTIC TANK MUST BE CAST IRON.


PERMIT VOID AFTER THREE YEARS.

PLANS APPROVED BY D. W. Monaghan DATE 10/14/68

FILL SEPTIC TANK AND DISTRIBUTION BOX WITH WATER BEFORE CALLING FOR AN INSPECTION. COVER NO WORK UNTIL INSPECTED AND APPROVED.

NEITHER THE HOWARD COUNTY COMMISSIONERS NOR THE HEALTH DEPARTMENT IS RESPONSIBLE FOR THE SUCCESSFUL OPERATION OF ANY SYSTEM.

A 13070

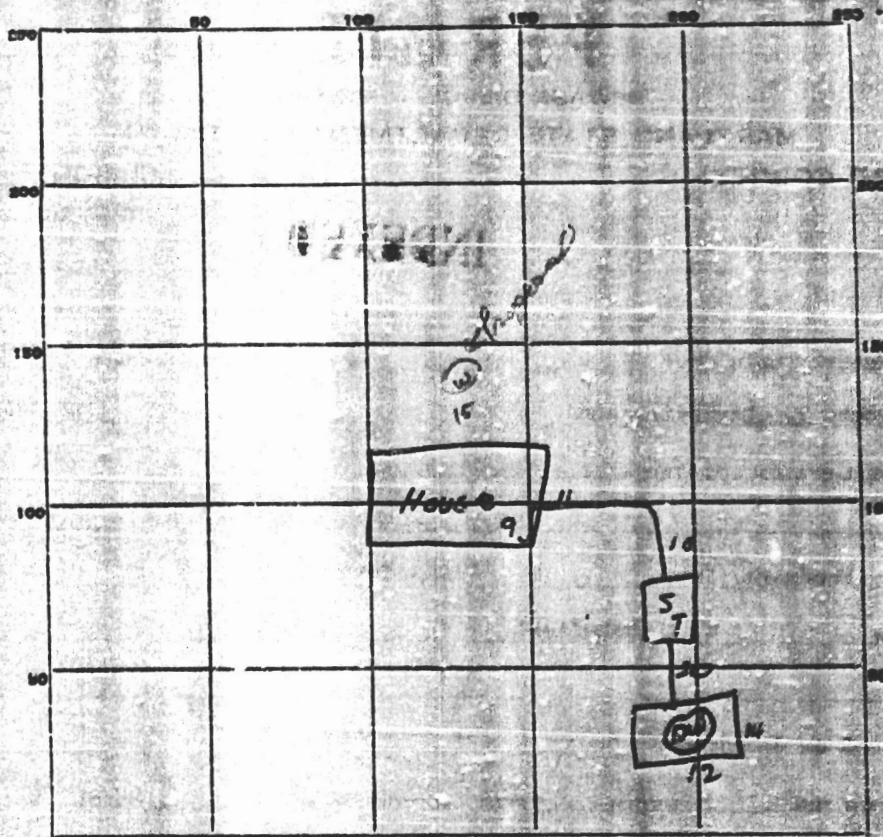

9/21/76
 17

INDICATE NORTH. - NAME ADJOINING ROADWAY AS BASE LINE.

Soka Court

PERMIT CARD _____

SEPTIC TANK, LEVEL _____

CLEANOUTS _____

DISTRIBUTION BOX, LEVEL _____

TILE FIELD, DEPTH _____ FT. TRENCH WIDTH _____ FT.

GRAVEL DEPTH _____ IN. TOTAL LENGTH _____ FT.

NUMBER OF TRENCHES _____ TOTAL BOTTOM AREA _____

SEEPAGE PITS, INSIDE DIAMETER Permits 52 FT. DEPTH BELOW INLET 8 FT.

ABSORBENT AREA 416 SQ. FT.

REMARKS _____

DATE SYSTEM APPROVED 9/21/76 INSPECTOR Quinn

APPLICATION

SEWAGE DISPOSAL TESTING

MARYLAND STATE DEPARTMENT OF HEALTH

HOWARD COUNTY

ELLICOTT CITY

Septic Tank - 3 bedroom - 750 gal
4 " " - 1000 gal.

DISTRICT 3

DATE 9/16/67

Dry Well - 100 sq ft absorbent sidewall one per bedroom
& basin below inlet pipe. Max depth permitted for dry well below orig. grade is
12 ft.

Place Dry Well - 59 ft from front lot line & 21 ft from right side line as seen
when facing lot from Court Ioka Ct.

TO: THE COUNTY HEALTH OFFICER
ELLICOTT CITY, MARYLAND

I, HEREBY, APPLY FOR THE NECESSARY TESTS IN ORDER TO CONSTRUCT (OR RECONSTRUCT) A SEWAGE
DISPOSAL SYSTEM.

PROPERTY OWNER Woodmark, Inc. - M. A. Wakefield

ADDRESS 231 Chatham Rd. PHONE _____

PROPERTY LOCATION:

SUBDIVISION Woodmark, Inc. LOT NO. 54, Blk. 2, Sec. 3

ROAD AND DESCRIPTION Court I

OCCUPANT _____ PHONE _____

PERSON TO CONSTRUCT SYSTEM _____

ADDRESS _____ PHONE _____

SIZE OF LOT 110' x 40' x 74' x 275' x 60' x 185' x 135' TYPE BLDG. 3 or 4
NUMBER OF BEDROOMS

IF NOT SINGLE RESIDENCE DESCRIBE _____

SIGNATURE OF APPLICANT /s/ M. A. Wakefield


APPROVED BY W. Monaghan FOR Drywell DATE 9/14/67
(KIND OF SYSTEM)

REJECTED BY _____ FOR _____ DATE _____
(KIND OF SYSTEM)

HOLD PENDING FURTHER TESTS _____ DATE _____

REASONS FOR REJECTION OR HOLDING _____

THIS IS NOT A PERMIT

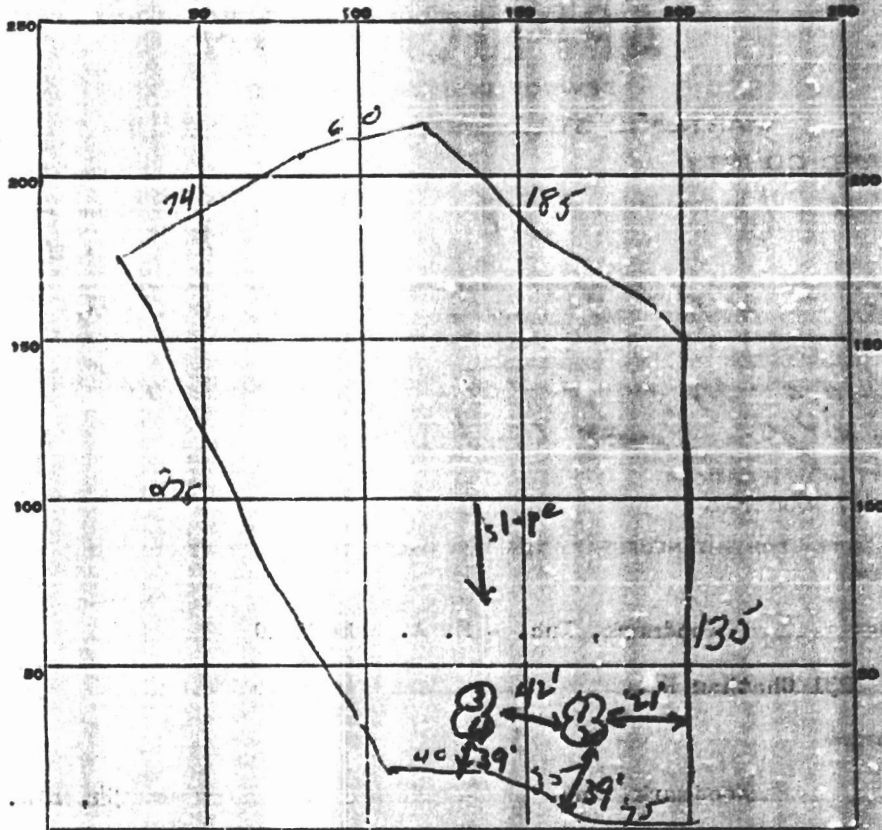

Count I

DATE	TEST NO.	DEPTH	PRE-WET		TEST - 1" DROP		TIME
			START	STOP	START	STOP	
9/7/67	1	4'	1:44	1:44	1:44	1:46	2 min
	2	10'	1:44	1:45	1:45	1:48	3 min
	3	6'	1:44	Overtime			
	4	10'	1:44	1:45	1:45	1:46	1 min

SOIL AUGER FINDING _____
 TESTED BY JKK + DM
 REMARKS _____

54E DC 3