

PERMIT

P 44087
A REPAIR

SEWAGE DISPOSAL SYSTEM

MARYLAND STATE DEPARTMENT OF HEALTH DISTRICT _____

HOWARD COUNTY
BUREAU OF ENVIRONMENTAL HEALTH
461-9933

INDEXED
NO FURTHER
AS OF 8/21/95
INDEX (CW)

DATE 4/25/89
INSPECTOR, NOT APPROVED 4/20/89
DATE SYSTEM APPROVED _____
INSPECTOR CW

IS PERMITTED TO INSTALL _____ ALTER

ADDRESS _____ PHONE _____

SUBDIVISION _____ ROAD 2956 Marriottsville LOT _____

PROPERTY OWNER Mr. and Mrs. John Hengen
ADDRESS 2956 Marriottsville Road
Marriottsville, Maryland

IF GARBAGE GRINDER IS USED INCREASE SEPTIC TANK CAPACITY BY 50% AND ABSORPTION AREA BY 22%.

GARBAGE GRINDER? YES _____ NO _____

SEPTIC TANK CAPACITY _____ GALLONS NUMBER OF BEDROOMS _____

REPAIR - TO ESTABLISH REPAIR CAPACITY TO SUPPORT DEMAND OF PROPOSED ADDITION -
BUILDING PERMIT NUMBER: 24468

PLANS APPROVED BY C. Williams DATE 4/19/89

COVER NO WORK UNTIL INSPECTED AND APPROVED

NEITHER THE HOWARD COUNTY COUNCIL NOR THE HEALTH DEPARTMENT IS RESPONSIBLE FOR THE SUCCESSFUL OPERATION OF ANY SYSTEM


- NOTE: CLEANOUT REQUIRED EVERY 70 FEET OF SEWER LINE AND/OR AT 90° SWEEPS IN LINES FROM HOUSE TO DRAIN FIELDS
- NOTE: ALL PARTS OF SEPTIC SYSTEMS (I.E., TANK, DISTRIBUTION BOX, TRENCHES) TO BE 100 FEET FROM WELL (UNLESS OTHERWISE SPECIFICALLY AUTHORIZED)
- NOTE: IF DEEP TRENCHES ARE USED CALL FOR INSPECTION BEFORE AND AFTER PLACING GRAVEL IN TRENCHES
- NOTE: NO DRY WELL SHALL EXCEED 15 FOOT IN DIAMETER NO ABSORPTION TRENCH TO EXCEED 100 FEET IN LENGTH.
- NOTE: ALL PIPE FROM HOUSE TO SEPTIC TANK MUST BE CAST IRON OR SCHEDULE 40 PVC OR ABS
- PERMIT VOID AFTER TWO YEARS
- NOTE: INSTALL STAND PIPE ON SEPTIC TANK AND DRY WELL. STAND PIPES MUST BE 6 INCHES IN DIAMETER. CAST IRON, CONCRETE OR TERRA COTTA OR PVC OR ABS ACCEPTED. IF TOP OF SEPTIC TANK IS DEEPER THAN 3 FEET, MANHOLE TO GRADE REQUIRED
- NOTE: DISTRIBUTION BOXES MUST HAVE BAFFLES

***INSTALLER IS RESPONSIBLE FOR OBTAINING FINAL APPROVAL ON THIS PERMIT**

*CALL 461-9933 FOR INSPECTION OF SEPTIC SYSTEMS.

13 Bedrooms
B.C. PERMIT SIGNATURE
AND RETURNED 3/11/89
Final # 24468 addition

P44087

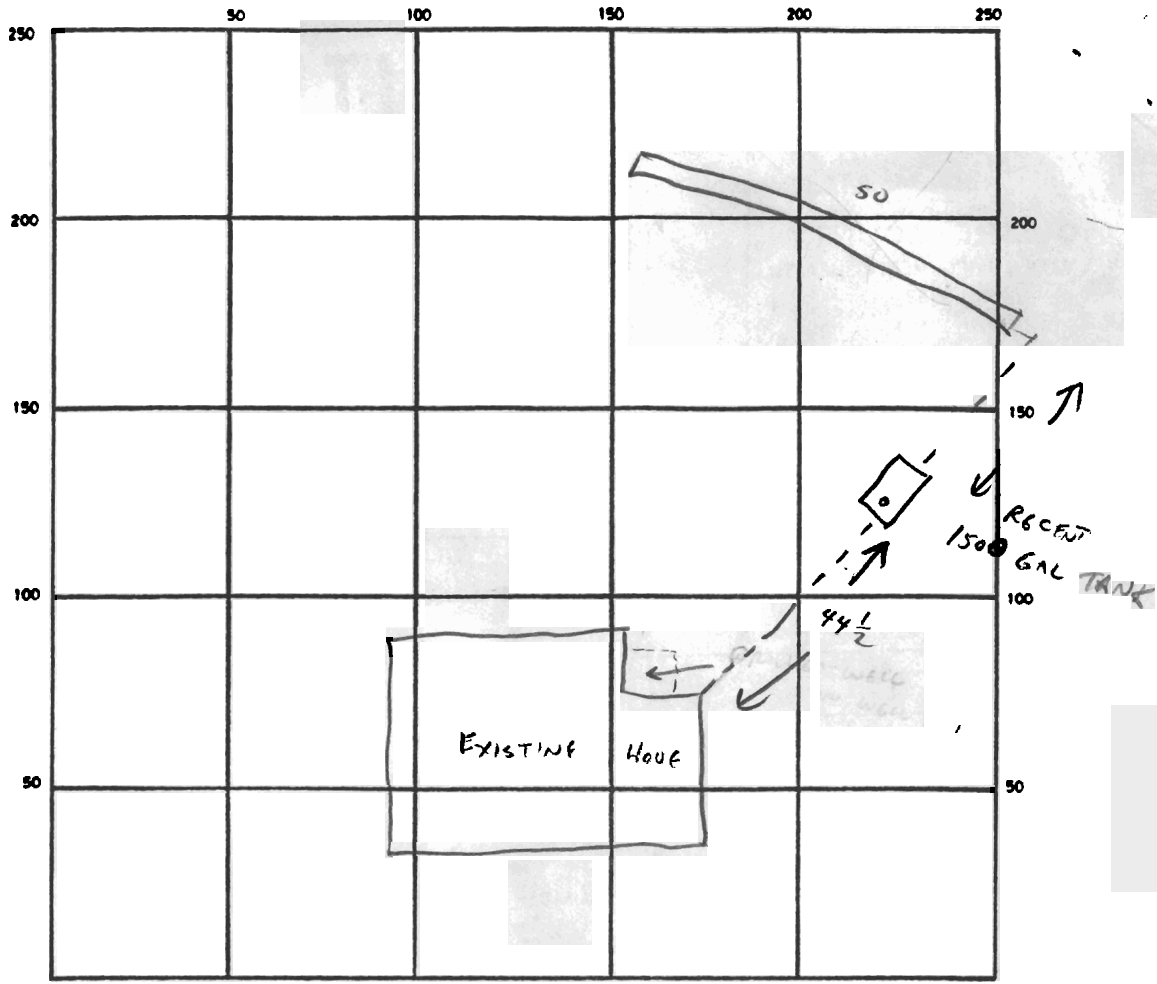

INDICATE NORTH — NAME ADJOINING ROADWAY AS BASE LINE

SEPTIC TANK LEVEL _____ CLEANOUTS _____

DISTRIBUTION BOX LEVEL _____

DRAIN FIELD/TILE FIELD DEPTH _____ FT. TRENCH WIDTH _____ FT. INLET DEPTH _____ FT.

EFFECTIVE GRAVEL DEPTH _____ FT. TOTAL LENGTH _____ FT

NUMBER OF TRENCHES _____ ONE SIDEWALL/BOTTOM AREA _____ SQ FT

DRYWELL INSIDE DIAMETER _____ FT EFFECTIVE DEPTH BELOW INLET _____ FT

ABSORBENT AREA _____ SQ. FT

REMARKS 4/24/88 TANK AND EXISTING 50' TRENCH RECENTLY INSTALLED
CONCRETE PIPE, NO PAPER GUN TRENCH
NOT PERMITTED, LIKELY SHALLOW TRENCH INLET 3' BELOW GRADE, 3' WIDE
SOILS JUDGED ADEQUATE FOR SOME TYPE OF SYSTEM, ADDITIONAL CAPACITY REQUIRED
FOR 4 BR. HOUSE. OK TO ISSUE BP AFTER REVISED DETAILS TO WELL DIMENSIONS
OF TRENCH TO BE DETERMINED AT TIME OF INSTALLATION.

DATE SYSTEM APPROVED _____ INSPECTOR _____