

LAYOUT 11/21/02 10 Am INSP 4 \_\_\_\_\_  
 INSP 2 \_\_\_\_\_ INSP 5 \_\_\_\_\_  
 INSP 3 \_\_\_\_\_ INSP 6 \_\_\_\_\_

ISSUE DATE: 11/22/2002  
 APPROVAL DATE: 11/21/02

# PERMIT

P PAID P518007  
A517353  
 A REPAIR

**INDEXED**  
**ON-SITE SEWAGE DISPOSAL SYSTEM**  
**HOWARD COUNTY HEALTH DEPARTMENT**  
**BUREAU OF ENVIRONMENTAL HEALTH**

03-286673

Jenkins Brothers IS PERMITTED TO INSTALL  ALTER

ADDRESS: 7670 Smith's Private Road PHONE NUMBER: 410-461-9282

SUBDIVISION: \_\_\_\_\_ LOT NUMBER: \_\_\_\_\_

ADDRESS: 2956 Marriottsville Road PROPERTY OWNER: Wieslaw Deka

SEPTIC TANK CAPACITY (GALLONS): ex 1500 ? OUTLET BAFFLE FILTER REQUIRED

PUMP CHAMBER CAPACITY (GALLONS): N/A COMPARTMENTED TANK REQUIRED

NUMBER OF BEDROOMS: 4 total (This repair is for a 2 bedroom addition)

SQUARE FEET PER BEDROOM: 180

LINEAR FEET OF TRENCH REQUIRED: 60 HOUSE SERVED BY PUBLIC WATER

TRENCHES:	Trench to be 2.0 feet wide. Inlet 3.0 feet below original grade. Bottom maximum depth 8.0 feet below original grade. Effective area begins at 3.0 feet below original grade. 5.0 feet of stone below distribution pipe.
LOCATION:	In support of building permit #B00136945, 2 bedroom addition, house is currently a 2 bedroom will be increased to 4 bedrooms.
NOTES:	180 x 4 = 720' wide = 360 x .31, 360 x <del>3.1</del> = 111.6' trench (given credit for 50' of existing trench) <u>.31</u>

PLANS APPROVED: Steven R. Krieg/John Boris DATE: 11/20/2002

NOTES: PERMIT VOID AFTER 2 YEARS  
 CONTRACTOR IS RESPONSIBLE FOR SCHEDULING A PRE-CONSTRUCTION INSPECTION FOR ALL INSTALLATIONS  
 WATERTIGHT SEPTIC TANKS REQUIRED  
 ALL PARTS OF SEPTIC SYSTEM SHALL BE 100 FEET FROM ANY WATER WELL UNLESS SPECIFICALLY AUTHORIZED  
 MANHOLE RISERS REQUIRED ON ALL SEPTIC TANKS AND PUMP CHAMBERS UNLESS SPECIFICALLY AUTHORIZED  
 CONTRACTOR RESPONSIBLE FOR COMPLIANCE WITH APPLICABLE REGULATIONS, GUIDELINES AND THE TERMS OF THIS PERMIT

**NEITHER THE HOWARD COUNTY COUNCIL NOR THE HEALTH DEPARTMENT IS RESPONSIBLE FOR THE SUCCESSFUL OPERATION OF ANY SYSTEM PERMITTEE RESPONSIBLE FOR OBTAINING FINAL APPROVAL ON THIS PERMIT ALL 410-313-2640 FOR INSPECTION OF SEPTIC SYSTEM**


**BUILDING PERMIT SIGNED AND RETURNED**

7-18-02 B00136945- 2 BDRM ADDITION  
3-10-04 B00146899- GARAGE

A517353

LOW

NOT TO SCALE

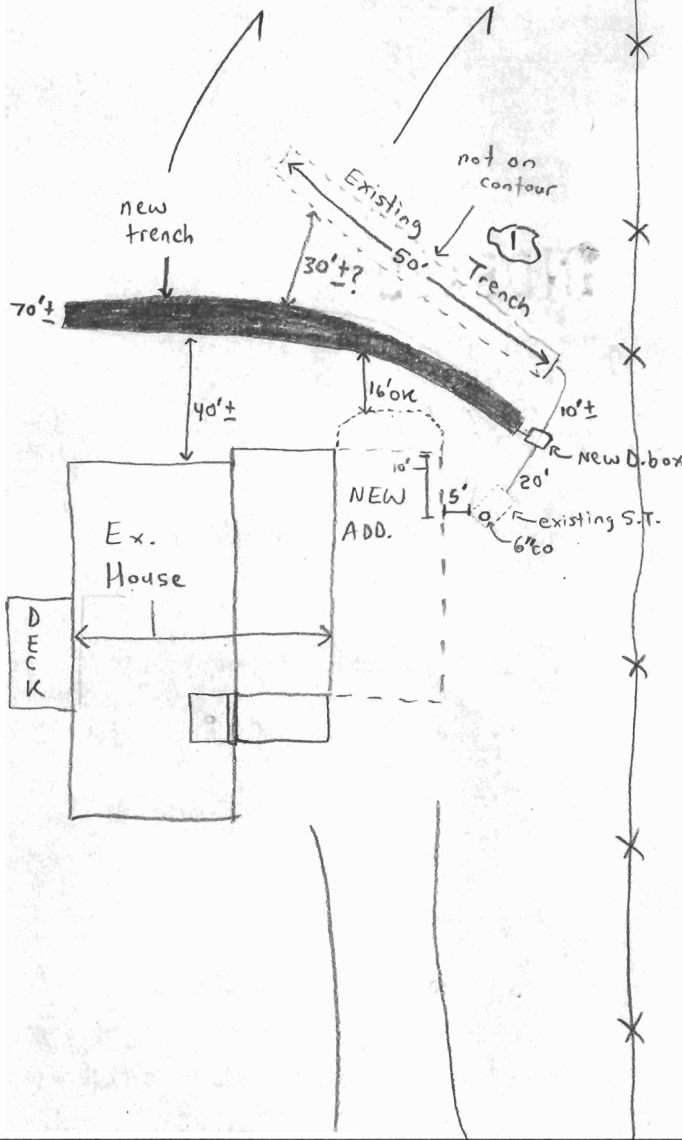

MARRIOTTSVILLE

ROAD

TRENCH/DRAINFIELD DATA					
WIDTH	INLET		BOTTOM		
ex.	new	ex.	new	ex.	new
3	2-3	4	3	?	8
NUMBER OF TRENCHES				1 new	1 existing
TOTAL LENGTH				50' old	70' new
ABSORPTION AREA				360ft <sup>2</sup> (bottom only)	
				(700ft <sup>2</sup> of sidewalk in new trench)	
DISTRIBUTION BOX LEVEL				✓	
DISTRIBUTION BOX BAFFLE				NA	
DISTRIBUTION BOX PORT				NA	

SEPTIC TANK DATA	
SEPTIC TANK 1 LEVEL	✓
CAPACITY	1500? GAL
SEAM LOC	mid
TANK LID DEPTH	3'±
BAFFLES	existing OK
BAFFLE FILTER	NA
MANHOLE LOC	No
6" PORT LOC	Front
WATERTIGHT TEST	NA
SEPTIC TANK 2 LEVEL	NA
CAPACITY	
SEAM LOC	
TANK LID DEPTH	
BAFFLES	
BAFFLE FILTER	
MANHOLE LOC	
6" PORT LOC	
WATERTIGHT TEST	

PRE-CONSTRUCTION 11/21/02 - OK TO INSTALL NEW TRENCH ABOVE EXISTING TRENCH TO PREVENT DAMAGING EXISTING TRENCH, OK TO BE LESS THAN 20' TO FOUNDATION W/ NEW TRENCH (SRK)  
 INSTALLATION 11/21/02 - OK TO COVER ALL WORK (SRK)

FINAL INSPECTOR Steven R. Krieg DATE OF APPROVAL 11/21/02

7/17/02  
10:00

PUB. SEWER STATUS VERIFIED BY N/A/B

ISSUE DATE: 7/8/2002

# PERMIT

P 517353

APPROVAL DATE: \_\_\_\_\_

A REPAIR

## ON-SITE SEWAGE DISPOSAL SYSTEM HOWARD COUNTY HEALTH DEPARTMENT BUREAU OF ENVIRONMENTAL HEALTH

Fogles Septic Clean, Inc IS PERMITTED TO INSTALL  ALTER

ADDRESS: 580 Obrecht Road PHONE NUMBER: 410-795-5670

SUBDIVISION: \_\_\_\_\_ LOT NUMBER: \_\_\_\_\_

ADDRESS: 2956 Marriottsville Road PROPERTY OWNER: Deka

SEPTIC TANK CAPACITY (GALLONS): ext 1000/1500?

PUMP CHAMBER CAPACITY (GALLONS): N/A

NUMBER OF BEDROOMS: 4 total (2 bedroom addition)

SQUARE FEET PER BEDROOM: 180  $180 \times 4 = 720 \div 2'w = 360 \times .31$

LINEAR FEET OF TRENCH REQUIRED: 60  $\div 360 \times .31 = 111.6' \text{ trench}$   
 $5' = \text{Give credit for 50' of ex. trench}$

TRENCHES:	Trench to be <u>2</u> feet wide. Inlet <u>2</u> feet below original grade. Bottom maximum depth <u>8</u> feet below original grade. Effective area begins at <u>3</u> feet below original grade. <u>5</u> feet of stone below distribution pipe.
LOCATION:	In support of building permit (B00136945). Call for inspection when ground is opened.
PURPOSE:	


PLANS APPROVED: SRK/JTB DATE: 7/18/02

- NOTE: PERMIT VOID AFTER 2 YEARS
- NOTE: CONTRACTOR RESPONSIBLE FOR SCHEDULING A PRE-CONSTRUCTION INSPECTION FOR ALL INSTALLATIONS
- NOTE: WATERTIGHT SEPTIC TANKS REQUIRED
- NOTE: ALL PARTS OF SEPTIC SYSTEM SHALL BE 100 FEET FROM ANY WATER WELL
- NOTE: MANHOLE RISERS REQUIRED ON ALL SEPTIC TANKS AND PUMP CHAMBERS

**NEITHER THE HOWARD COUNTY COUNCIL NOR THE HEALTH DEPARTMENT IS RESPONSIBLE FOR THE SUCCESSFUL OPERATION OF ANY SYSTEM PERMITTEE RESPONSIBLE FOR OBTAINING FINAL APPROVAL ON THIS PERMIT CALL 410-313-2640 FOR INSPECTION OF SEPTIC SYSTEM**

Low

NOT TO SCALE

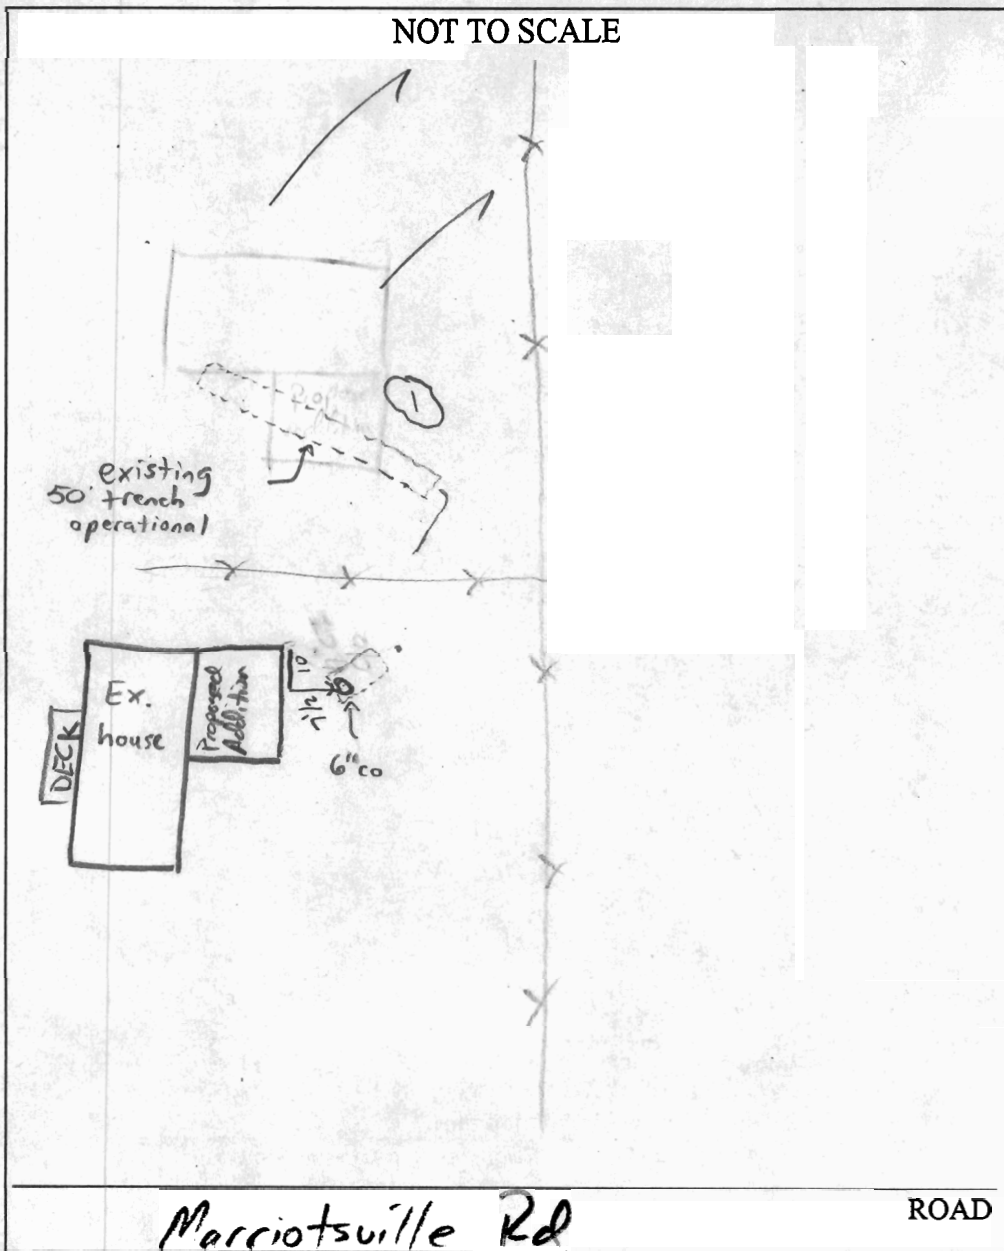

**TRENCH/DRAINFIELD DATA**

WIDTH	INLET	BOTTOM
_____	_____	_____
NUMBER OF TRENCHES _____		
TOTAL LENGTH _____		
ABSORPTION AREA _____		
DISTRIBUTION BOX LEVEL _____		
DISTRIBUTION BOX BAFFLE _____		
DISTRIBUTION BOX PORT _____		

**SEPTIC TANK DATA**

SEPTIC TANK 1 LEVEL \_\_\_\_\_

CAPACITY	_____ GAL
SEAM LOC	_____
TANK LID DEPTH	_____
BAFFLES	_____
BAFFLE FILTER	_____
MANHOLE LOC	_____
6" PORT LOC	_____
WATERTIGHT TEST	_____

SEPTIC TANK 2 LEVEL \_\_\_\_\_

CAPACITY	_____ GAL
SEAM LOC	_____
TANK LID DEPTH	_____
BAFFLES	_____
BAFFLE FILTER	_____
MANHOLE LOC	_____
6" PORT LOC	_____
WATERTIGHT TEST	_____

Marciotsville Rd

ROAD

PRE-CONSTRUCTION 7/17/02 - Met contractor on-site + dug perc hole as

shown; see soil profile, keep existing in trench in service (verified by system exposure). Add D-box + connect existing trench w/new trench

INSTALLATION \_\_\_\_\_  
Install manhole covers on tanks + JB/SRK EX. well unable to be found. INSTALLATION -

FINAL INSPECTOR \_\_\_\_\_ DATE OF APPROVAL \_\_\_\_\_