

STATE RESOURCES ADMINISTRATION
TAYLOR STATE OFFICE BLDG., ANNAPOLIS, MD. 21403
WELL COMPLETION REPORT

FILE IN THIS FORM COMPLETELY
COUNTY NUMBER **A13090**

DATE RECEIVED BY DRILLER **4-5-73** DEPTH OF WELL **120** PERMIT NO. FROM "PERMIT TO DRILL WELL" **HO-73-0340**
DATE WELL COMPLETED **4-5-73** (BY NEAREST FOOT) **28** DRILLER IDENTIFICATION NO. **42**

OWNER **John Patrick** LAST NAME **Patrick** FIRST NAME **John**
STREET OR RFD **10000** POST OFFICE **10000**

WELL LOG
STATE THE KIND OF FORMATIONS PENETRATED, THEIR COLOR, DEPTH, THICKNESS AND IF WATER BEARING

DESCRIPTION (USE ADDITIONAL SHEETS IF NECESSARY)	FEET		NEW
	FROM	TO	
<i>Topsoil</i>	0	3	
<i>Clay</i>	3	7	
<i>Shale</i>	7	20	
<i>Sandstone</i>	20	120	

GROUTING RECORD
WELL HAS BEEN GROUTED (CIRCLE APPROPRIATE BOX) YES NO
TYPE OF GROUTING MATERIAL (CIRCLE ONE) CEMENT BENTONITE CLAY
NO. OF BAGS **5** NO. OF POUNDS **500**
BALLONS OF WATER **35**
DEPTH OF GROUT SEAL (BY NEAREST FOOT)
FROM **0** FT. TO **15** FT.
(ENTER 0 IF FROM SURFACE)

CASING RECORD
CASING TYPES (INSERT APPROPRIATE CODE BELOW)
 ST STEEL CO CONCRETE
 PL PLASTIC OT OTHER
MAIN CASING TYPE **ST** NOMINAL DIAMETER (BY NEAREST INCH) **6** TOTAL DEPTH OF MAIN CASING (BY NEAREST FOOT) **20**

OTHER CASING (IF USED)
DIAMETER (INCH) _____ DEPTH (FEET) FROM _____ TO _____

SCREEN RECORD
SCREEN TYPE (CIRCLE APPROPRIATE CODE BELOW)
 ST STEEL BR BRASS HO OPEN HOLE
 PL PLASTIC OT OTHER

SCREEN
C 2 (SEQ. NO.)
DEPTH (BY NEAREST WHOLE FOOT) FROM _____ TO _____
1 _____ 2 _____ 3 _____
4 _____ 5 _____ 6 _____
7 _____ 8 _____ 9 _____
97 _____ 98 _____ 99 _____
100 _____


PUMPING TEST
HOURS PUMPED (BY NEAREST HOUR) _____
PUMPING RATE (GALLONS PER MINUTE TO NEAREST GALLON) _____
METHOD USED TO MEASURE PUMPING RATE _____
WATER LEVEL (DISTANCE FROM LAND SURFACE)
BEFORE PUMPING _____ FEET
AFTER PUMPING _____ FEET
WHEN PUMPING _____ FEET
TYPE OF PUMP USED (CIRCLE APPROPRIATE BOX FOR PUMPING TEST)
 A AIR P PISTON T TURBINE
 C CENTRIFUGAL R ROTARY O OTHER (DESCRIBE BELOW)
 J JET S SUBMERSIBLE

PUMP INSTALLED
TYPE OF PUMP (WRITE APPROPRIATE LETTER IN BOX - SEE ABOVE: A, C, J, P, R, S, T, O)
DRILLER WILL INSTALL PUMP (CIRCLE APPROPRIATE BOX) YES NO
CAPACITY:
GALLONS PER MINUTE TO NEAREST GALLON _____
PUMP HORSE POWER _____
PUMP COLUMN LENGTH (BY NEAREST FOOT) _____
CASING HEIGHT (CIRCLE APPROPRIATE BOX AND ENTER CASING HEIGHT)
 ABOVE } LAND SURFACE (BY NEAREST FOOT) _____
 BELOW } _____


LOCATION OF WELL ON LOT
SHOW PERMANENT STRUCTURE SUCH AS BUILDING, SEPTIC TANKS, AND/OR OTHER LAND MARKS AND INDICATE NOT LESS THAN TWO DISTANCES (MEASUREMENTS TO WELL).
House
Well

CIRCLE APPROPRIATE BOXES
 A WELL WAS ABANDONED AND SEALED WHEN THIS WELL WAS COMPLETED
 E ELECTRIC LOG OBTAINED
 P TEST WELL CONVERTED TO PRODUCTION WELL
I HEREBY CERTIFY THAT I HAVE COMPLIED WITH ALL CONDITIONS STATED ON THE ABOVE CAPTIONED "PERMIT TO DRILL WELL", AND THAT INFORMATION CONTAINED IN THIS REPORT IS TRUE, ACCURATE, AND COMPLETE TO THE BEST OF MY KNOWLEDGE, INFORMATION AND BELIEF.
DRILLERS NAME _____
PLEASE PRINT _____
SIGNATURE _____

DIAMETER OF SCREEN _____ (BY NEAREST INCH) FROM _____ TO _____
GRAVEL PACK _____
IF WELL DRILLED WAS A FLOWING WELL CIRCLE BOX F
DWR USE ONLY (NOT TO BE FILLED IN BY DRILLER)
TELESCOPE CASING YES NO
LOG INDICATOR YES NO
OTHER DATA AVAILABLE YES NO

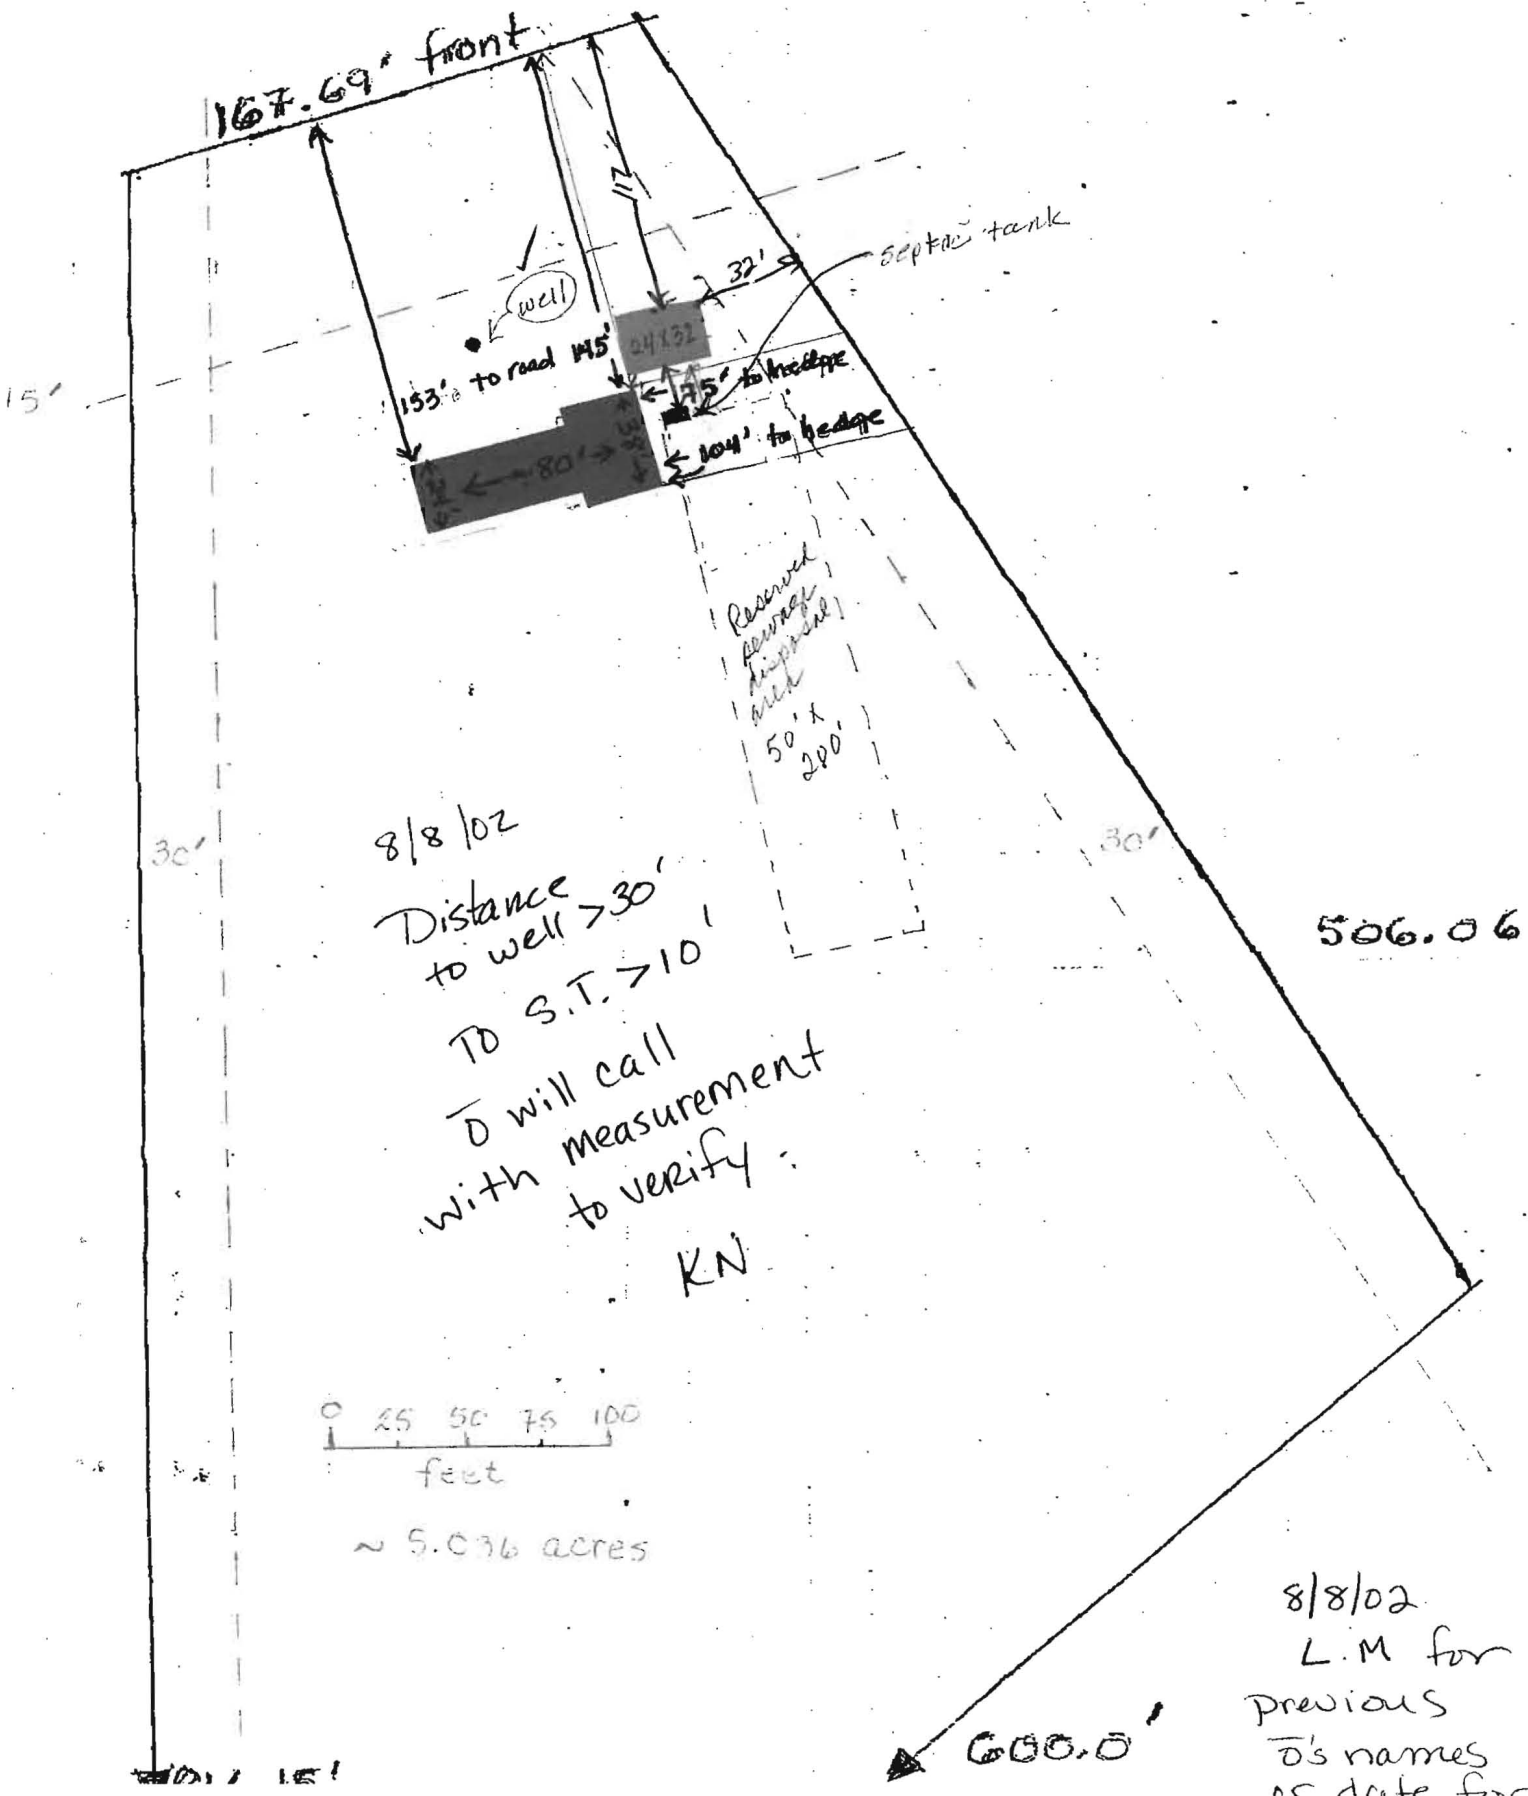

8/8/02
 Distance to well > 30'
 TO S.T. > 10'
 D will call
 with measurement
 to verify
 KN

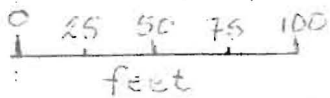


~ 5.036 acres

8/8/02
 L.M for
 previous
 D's names
 or date for
 site insp.


600.0'

BUILDING PERMIT NUMBER B.O.O 137597

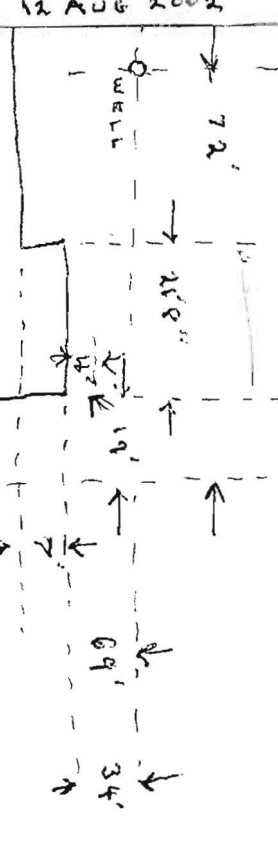

167.69' front 8/12/02

8/8/02 old permit

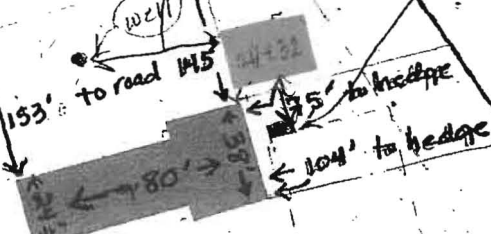

Reserved Area
50' x 200'



506.06

600.0'

15'