

PUB. SEWER STATUS VERIFIED BY _____

ISSUE DATE: _____

PERMIT

P _____

APPROVAL DATE: _____

A 517428-F

INDEXED

ON-SITE SEWAGE DISPOSAL SYSTEM HOWARD COUNTY HEALTH DEPARTMENT BUREAU OF ENVIRONMENTAL HEALTH

03-281744

IS PERMITTED TO INSTALL ALTER

ADDRESS: _____ PHONE NUMBER: _____

SUBDIVISION: Philip Carroll Property LOT NUMBER: 2

ADDRESS: 4420 W. Manor Lane PROPERTY OWNER: Philip Carroll

SEPTIC TANK CAPACITY (GALLONS): _____

PUMP CHAMBER CAPACITY (GALLONS): _____

NUMBER OF BEDROOMS: _____

SQUARE FEET PER BEDROOM: _____

LINEAR FEET OF TRENCH REQUIRED: _____

TRENCHES:	Trench to be _____ feet wide. Inlet _____ feet below original grade. Bottom maximum depth _____ feet below original grade. Effective area begins at _____ feet below original grade. _____ feet of stone below distribution pipe.
LOCATION:	_____
PURPOSE:	_____

PLANS APPROVED: _____ DATE: 12/2/1969

- NOTE: PERMIT VOID AFTER 2 YEARS
- NOTE: CONTRACTOR RESPONSIBLE FOR SCHEDULING A PRE-CONSTRUCTION INSPECTION FOR ALL INSTALLATIONS
- NOTE: WATERTIGHT SEPTIC TANKS REQUIRED
- NOTE: ALL PARTS OF SEPTIC SYSTEM SHALL BE 100 FEET FROM ANY WATER WELL
- NOTE: MANHOLE RISERS REQUIRED ON ALL SEPTIC TANKS AND PUMP CHAMBERS

NEITHER THE HOWARD COUNTY COUNCIL NOR THE HEALTH DEPARTMENT IS RESPONSIBLE FOR THE SUCCESSFUL OPERATION OF ANY SYSTEM PERMITTEE RESPONSIBLE FOR OBTAINING FINAL APPROVAL ON THIS PERMIT CALL 410-313-2640 FOR INSPECTION OF SEPTIC SYSTEM

A517428-F

12/2/69

PERMIT

SEWAGE DISPOSAL SYSTEM

P. 10598

A. 14460

MARYLAND STATE DEPARTMENT OF HEALTH

HOWARD COUNTY

ELLICOTT CITY

INDEXED

DISTRICT 3

DATE 12/2/69

Phillip Carroll IS PERMITTED TO INSTALL X ALTER

ADDRESS Doughoregan Manor, Ellicott City, Md. PHONE 465-3536

A SEWAGE DISPOSAL SYSTEM LOCATED AT _____

SUBDIVISION _____ ROAD Manor Lane LOT _____

PROPERTY OWNER Phillip Carroll

ADDRESS _____

SPECIFICATIONS - 3 bedrooms

DRAIN FIELD _____ DEPTH _____ FEET, BOTTOM AREA _____ SQ. FT.

SEEPAGE PITS _____ ABSORBENT SIDE-WALL AREA _____ SQ. FT.

SEPTIC TANK CAPACITY 750 GALLONS

FOR GARBAGE GRINDER, INCREASE DISPOSAL AREA 22% & TANK CAPACITY 50%.

OTHER Dry well to be 525 sq. ft. of absorbent sidewall area below the inlet pipe. Maximum depth of dry well to be 12 ft. deep from original grade. Locate dry well 65 ft. from front property line and between 115 and 145 ft. from road on right hand side of property as property is seen standing on Manor Lane facing lot.

PERMIT VOID AFTER THREE YEARS.

NOTE: ALL PIPE FROM HOUSE TO SEPTIC TANK MUST BE CAST IRON.


PLANS APPROVED BY James T. Wright DATE 11/29/69

FILL SEPTIC TANK AND DISTRIBUTION BOX WITH WATER BEFORE CALLING FOR AN INSPECTION. COVER NO WORK UNTIL INSPECTED AND APPROVED.

NEITHER THE HOWARD COUNTY COMMISSIONERS NOR THE HEALTH DEPARTMENT IS RESPONSIBLE FOR THE SUCCESSFUL OPERATION OF ANY SYSTEM.

NOTIFY THE HEALTH DEPARTMENT 48 HOURS BEFORE EXCAVATIONS ARE TO BE BACK FILLED.

119460

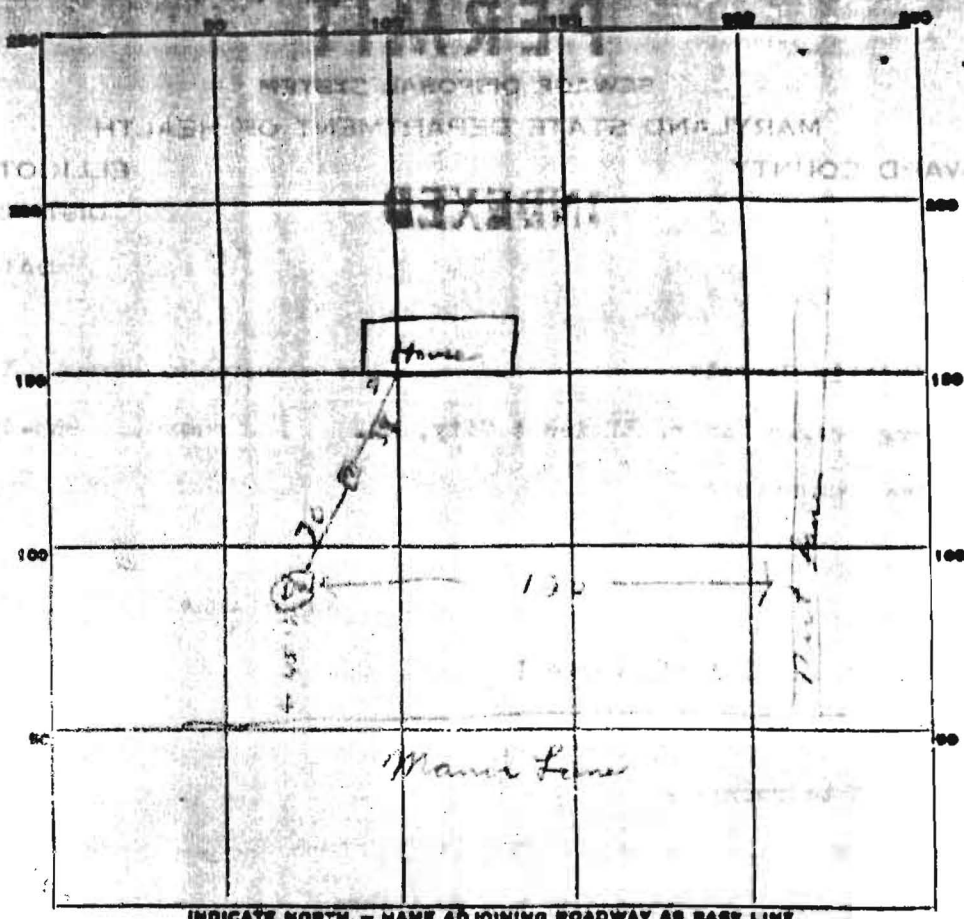

PERMIT CARD Signed

SEPTIC TANK, LEVEL 750 CLEAN CUTS OK

DISTRIBUTION BOX, LEVEL _____

TILE FIELD, DEPTH _____ FT. TRENCH WIDTH _____ FT.

GRAVEL DEPTH _____ IN. TOTAL LENGTH _____ FT.

NUMBER OF TRENCHES _____ TOTAL BOTTOM AREA _____

SEEPAGE PITS, INCH DIAMETER 14 1/2 FT. DEPTH BELOW INLET 12 1/2 FT.

ABSORBENT AREA 695 SQ. FT.

REMARKS _____

DATE SYSTEM APPROVED 12/2/69 INSPECTOR R. T. ...

APPLICATION

A 2460

P _____

SEWAGE DISPOSAL TESTING

MARYLAND STATE DEPARTMENT OF HEALTH

HOWARD COUNTY Septic tank to be 750 gallons ELLICOTT CITY

Dry Well: to be 325 sq ft of absorption district 3
Area below the inlet pipe. 112 ft diam. Depth of dry well DATE 4/25/69
to be 12 ft deep from ground level well 65 ft from front property line
and between 115 and 145 ft from road on right hand side of property
as property is also a stand on Manor Lane facing lot.

TO: THE COUNTY HEALTH OFFICER
ELLICOTT CITY, MARYLAND

I, HEREBY, APPLY FOR THE NECESSARY TESTS IN ORDER TO CONSTRUCT (OR RECONSTRUCT) A SEWAGE DISPOSAL SYSTEM.

PROPERTY OWNER Phillip Carroll

ADDRESS Doughorsan Manor, Ellicott City, Md. PHONE 465-3536

PROPERTY LOCATION:

SUBDIVISION _____ LOT NO. _____

ROAD AND DESCRIPTION Manor Lane

OCCUPANT _____ PHONE _____

PERSON TO CONSTRUCT SYSTEM _____

ADDRESS _____ PHONE _____

SIZE OF LOT 2800 sq ft TYPE BLDG. House to be moved to this 3 site
NUMBER OF BEDROOMS

IF NOT SINGLE RESIDENCE DESCRIBE _____

SIGNATURE OF APPLICANT Phillip Carroll

APPROVED BY James F. Wright FOR Septic Well DATE 4/24/69

REJECTED BY _____ FOR _____ DATE _____

HOLD PENDING FURTHER TESTS _____ DATE _____

REASONS FOR REJECTION OR HOLDING _____

THIS IS NOT A PERMIT

APPLICATION

SEWAGE DISPOSAL TESTING
MARYLAND STATE DEPARTMENT OF HEALTH



INDICATE NORTH. - NAME ADJOINING ROADWAY AS BASE LINE.

NINET LANE

DATE	TEST NO.	DEPTH	PRE-WET		TEST - 1" DROP		TIME
			START	STOP	START	STOP	
4/29/69	1	9'	9:45				30.
	2	5'	9:45				25
	3	9'	9:45	9:52	9:52	9:52	14.00
	4	5'	9:55	10:05	10:05	10:20	25.00

84
21m AV

SOIL AUGER FINDING: *no water to 13' depth*

TESTED BY: *[Signature]*

REMARKS:

A TOWN CI