

**THIS REPORT  
MUST BE SUBMITTED  
WITHIN 30 DAYS  
AFTER COMPLETION  
OF THE WELL**

**WELL COMPLETION REPORT**

**WELL DESCRIPTION**

**WELL LOG**

State the kind of formations penetrated, their color, their depth, their thickness, and if water-bearing

**CASING AND SCREEN RECORD**

State the kind and size and position of casing, liner, shoe, screen, and other accessories (if no casing used, give diameter of well).

FEET from ___ to ___	DIAM. (inches)	FEET from ___ to ___
0-32 Sand & gravel	6 1/4"	35'
34 Shale Rock 81 Granite Rock	Pipe	
WELL 150		

Permit Number Hy-61-W-153  
Owner D. J. ...  
Address ...  
Subdivision \_\_\_\_\_  
Section \_\_\_\_\_ Lot \_\_\_\_\_

**PUMPING TEST**

Hours Pumped 2  
Type of Pump Used ...  
Pumping Rate \_\_\_\_\_  
Gallons per Minute 3 1/2

**WATER LEVEL**

(Distance from land surface to water)  
Before Pumping 36 Ft.  
When Pumping \_\_\_\_\_ Ft.

**APPEARANCE OF WATER**

Clear  Cloudy \_\_\_\_\_  
Taste \_\_\_\_\_  
Oder ...


Height of Casing Above Land  
Surface 2 Ft.

**PUMP INSTALLED**

Type \_\_\_\_\_  
Capacity \_\_\_\_\_  
Gallons per Minute \_\_\_\_\_  
Gallons per Hour \_\_\_\_\_  
Pump Column Length \_\_\_\_\_ Ft.

**LOCATION OF WELL ON LOT**

Show permanent structures such as building(s), septic tank, and/or other landmarks and indicate not less than 2 distances (measurements) to well.

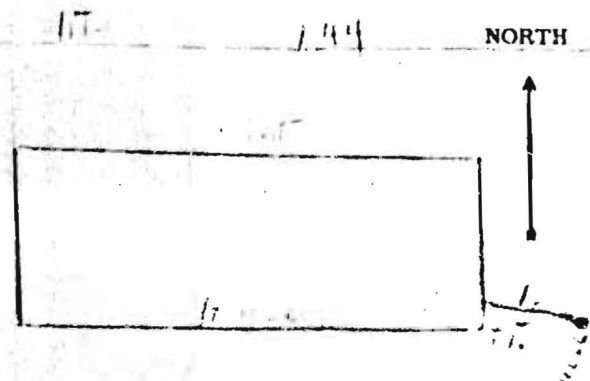

**DATE  
WELL WAS  
COMPLETED**

1/2/66

I hereby affirm that this report contains no willful misrepresentations or falsifications and that information given in this report is true, accurate and complete to the best of my knowledge and belief.

Ed. Brown, Well Driller

Well Driller License No.: 81