

**THIS REPORT  
MUST BE SUBMITTED  
WITHIN 30 DAYS  
AFTER COMPLETION  
OF THE WELL**

**WELL COMPLETION REPORT**

**WELL DESCRIPTION**

Permit Number 19-67-W94  
Owner Dougherty  
Address Chico Ave  
Subdivision \_\_\_\_\_  
Section \_\_\_\_\_ Lot \_\_\_\_\_

**WELL LOG**

State the kind of formations penetrated, their color, their depth, their thickness, and if water-bearing

**CASING AND SCREEN RECORD**

State the kind and size and position of casing, liner, shoe, screen, and other accessories (if no casing used, give diameter of well).

FEET from _____ to _____		DIAM. (inches)	FEET from _____ to _____
7 clay 34 sand gravel		6 1/2" Pipe	38
8 Shale Rock 49 Mica Rock			
95			

**PUMPING TEST**  
Hours Pumped 2  
Type of Pump Used air  
Pumping Rate  
Gallons per Minute 70

**WATER LEVEL**  
Distance from land surface to water)  
Before Pumping 35  
When Pumping \_\_\_\_\_


**APPEARANCE OF WATER**  
Clear  Cloudy \_\_\_\_\_  
Taste \_\_\_\_\_  
Color Turquoise

Height of Casing Above Land Surface 2

**PUMP INSTALLED**  
Type \_\_\_\_\_  
Capacity \_\_\_\_\_  
Gallons per Minute \_\_\_\_\_  
Gallons per Hour \_\_\_\_\_  
Pump Column Length \_\_\_\_\_

WELL 95  
EQUIPED  
JAN 31 8 00 AM '61  
RECEIVED  
MEXICO CITY, MD  
MAY 11 1961

**LOCATION OF WELL ON LOT**  
Show permanent structures such as building(s), septic tank, and/or other landmarks and indicate not less than 20 distances (measurements) to well.

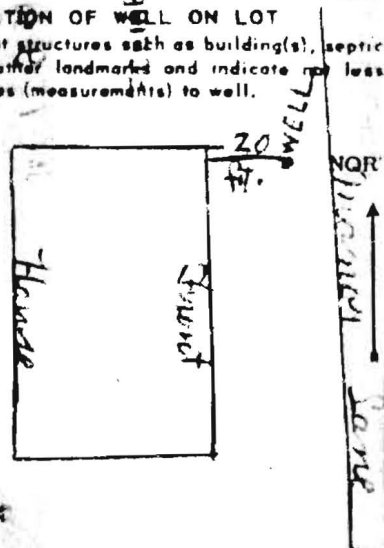

DATE WELL WAS COMPLETED

1/7/61

I hereby affirm that this report contains no willful misrepresentations or falsifications and that information given in this report is true, accurate and complete to the best of my knowledge and belief.

Ed. Brown Well Driller

Well Driller License No.: 81