

THIS REPORT  
MUST BE SUBMITTED  
WITHIN 30 DAYS  
AFTER COMPLETION  
OF THE WELL

### WELL COMPLETION REPORT

#### WELL DESCRIPTION

Permit Number Ho 190195  
Owner Dougherty  
Address Chesapeake  
Subdivision \_\_\_\_\_

Section \_\_\_\_\_ Lot \_\_\_\_\_  
County Permit Number \_\_\_\_\_  
**PUMPING TEST**  
Hours Pumped 1  
Type of Pump Used air  
Pumping Rate \_\_\_\_\_  
Gallons per Minute 10

**WATER LEVEL**  
Distance from land surface to water \_\_\_\_\_  
Before Pumping 3.5 Ft.  
When Pumping 120 Ft.

**APPEARANCE OF WATER**  
Clear \_\_\_\_\_ Cloudy \_\_\_\_\_  
Taste \_\_\_\_\_  
Odor \_\_\_\_\_

Height of Casing Above Land Surface 2 Ft.


**PUMP INSTALLED**  
Type \_\_\_\_\_  
Capacity \_\_\_\_\_  
Gallons per Minute \_\_\_\_\_  
Gallons per Hour \_\_\_\_\_  
Pump Column Length \_\_\_\_\_ Ft.

**A WELL LOG**  
State the kind of formations penetrated, their color, their depth, their thickness, and if water-bearing

**B CASING AND SCREEN RECORD**  
State the kind and size and position of casing, liner, shoe, screen, and other accessories (if no casing used, give diameter of well).

	FEEET from ___ to ___
<u>Soil</u>	<u>0-3</u>
<u>Loam</u>	<u>3-35</u>
<u>Sand</u>	<u>35-120</u>
<u>water</u>	<u>95</u>

DIAM (inches)	FEEET from ___ to ___
<u>Steel 6</u>	<u>0-41</u>

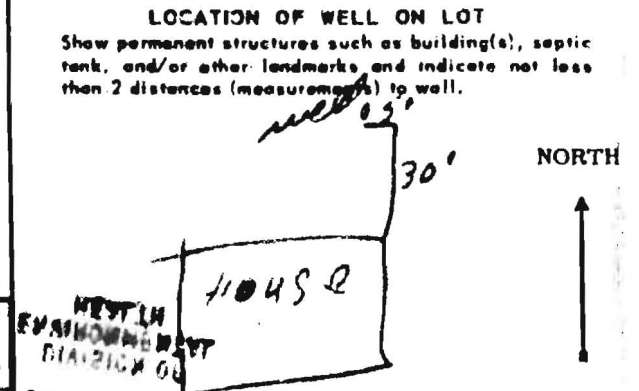

DATE WELL WAS COMPLETED

I hereby affirm that this report contains no willful misrepresentations or falsifications and that information given in this report is true, accurate and complete to the best of my knowledge and belief.

WESTIN ENVIRONMENTAL CONSULTANTS  
DIARRICH G...

NOV 30 3 03 PM '69

WESTIN DEPT. ENVIRONMENTAL RECEIVED

J. P. Eastman, Well Driller

Well Driller License No.: 472

Oct 14-69