

WELL COMPLETION REPORT

DATE: 10-4-73  
WELL NO.: 47

DEPTH OF WELL: 160  
 TYPE OF WELL: Drilled  
 DRAFTER: Drayton Rd

**WELL LOG**

THE KIND OF FORMATION PENETRATED, THICKNESS, DEPTH, THICKNESS AND OF WATER BEARING

DESCRIPTION OF FORMATION (IF MATERIALS)	FEET	
	FROM	TO
<u>Sand</u>	0	2
<u>Clay</u>	2	30
<u>Sand</u>	30	50
<u>Clay</u>	50	160

**GROUT RECORD**

WELL HAS BEEN GRouted (CIRCLE APPROPRIATE BOX)  YES  NO

TYPE OF GROUT MATERIAL (CIRCLE ONE)  PORTLAND CEMENT  OTHER

NO. OF BAGS: 12 NO. OF POUNDS: 1200

CALLING OF WATER: 72

DEPTH OF GROUT SEAL (TO NEAREST FOOT): FROM 0 FT. TO 43 FT.

**CASING RECORD**

CASING TYPE:  STEEL  CONCRETE  PLASTIC  OTHER

MAIN CASING TYPE:  S  T

NOMINAL DIAMETER TOP (INCH): 6

TOTAL DEPTH OF MAIN CASING (NEAREST FOOT): 47

**OTHER CASING (IF USED)**

DIAMETER (INCH)	DEPTH (FEET)

**SCREEN RECORD**

SCREEN TYPE (CIRCLE ONE):  STEEL  BRASS OR COPPER  PLASTIC  OTHER

DIAMETER OF SCREEN: 55 (NEAREST INCH)

**DEPTH (NEAREST WHOLE FOOT)**

DEPTH	1	2	3	4	5
1					
2					
3					

**PUMPING TEST**

HOURS PUMPED (TO NEAREST HOUR): 1

PUMPING RATE (GALLONS PER MINUTE TO NEAREST GALLON): 15

METHOD USED TO MEASURE PUMPING RATE: bucket

WATER LEVEL (DISTANCE FROM LAND SURFACE) BEFORE PUMPING: 40 (NEAREST FOOT)

WATER LEVEL (DISTANCE FROM LAND SURFACE) DURING PUMPING: 160 (NEAREST FOOT)

TYPE OF PUMP USED (CIRCLE APPROPRIATE BOX):  A  P  T  C  R  O  J  S

**PUMP INSTALLED**

TYPE OF PUMP (WRITE APPROPRIATE LETTER IN BOX):  A  C  J  P  R  S  T  O


DRILLED WELL INSTALL PUMP (CIRCLE APPROPRIATE BOX):  YES  NO

CAPACITY: GALLONS PER MINUTE (TO NEAREST GALLON):  

PUMP HORSE POWER:  

PUMP COLUMN LENGTH (NEAREST FOOT):  

CASING HEIGHT (CIRCLE APPROPRIATE BOX AND ENTER CASING HEIGHT):  ABOVE  BELOW

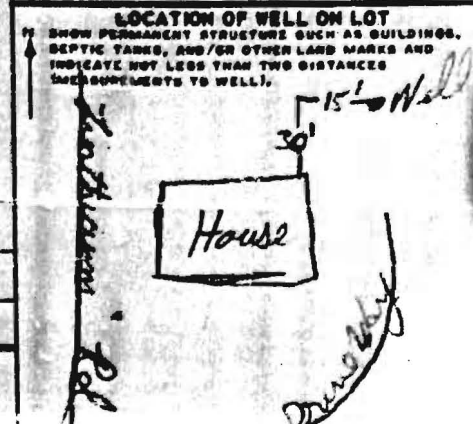

**CIRCLE APPROPRIATE BOXES**

A A WELL WAS ABANDONED AND SEALED WHEN THIS WELL WAS COMPLETED

E ELECTRIC LOG OBTAINED

P TEST WELL CONVERTED TO PRODUCTION WELL

I HEREBY CERTIFY THAT I HAVE COMPLIED WITH ALL CONDITIONS STATED ON THE ABOVE-CAPTIONED "PERMIT TO DRILL WELL", AND THAT INFORMATION CONTAINED IN THIS REPORT IS TRUE, ACCURATE, AND COMPLETE TO THE BEST OF MY KNOWLEDGE, INFORMATION AND BELIEF.

DRAFTER'S NAME: Drayton Rd

10-4-73  
Case 47,  
Open 40,  
Count 8 logs  
R.D. Drayton