


APPLICATION

MARYLAND STATE DEPARTMENT OF HEALTH  
 BUREAU OF PUBLIC HEALTH

BLADDER CITY HOWARD COUNTY

A00556

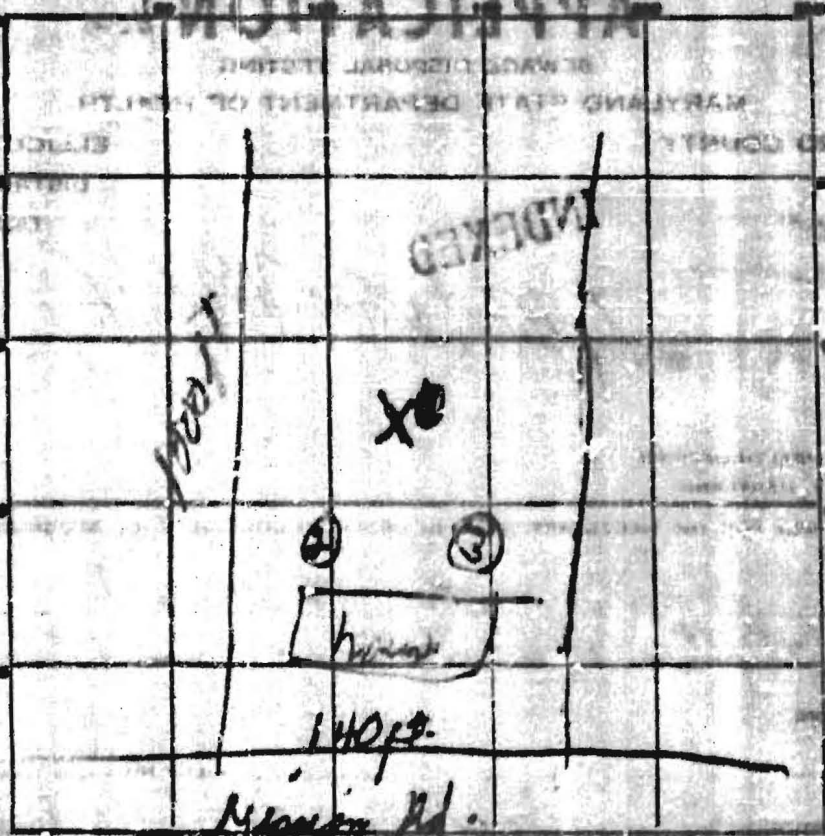

INDEXED

House

140 ft.

Main Rd.

MEASURE NORTH - FROM ADJOINING ROADWAY AS BASE LINE.

DATE	TEST NO.	DEPTH	PRE-TEST		TEST - 1" DROP		TIME
			START	STOP	START	STOP	
3/2/57	1 <sup>st</sup>	2 1/2	10:49	11:00			

SOIL AUGER FINDS: clay

TESTED BY: P. W.

THIS IS NOT A PERMIT  
 ALSO PRESENT