

PERMIT

SEWAGE DISPOSAL SYSTEM

MARYLAND STATE DEPARTMENT OF HEALTH

HOWARD COUNTY

INDEXED

ELLICOTT CITY

DISTRICT 151

DATE 4/22/59

*P-01172
A-00555*

Charles Conrad IS PERMITTED TO INSTALL ALTER

ADDRESS _____ PHONE _____

A SEWAGE DISPOSAL SYSTEM LOCATED AT John Hoffman Road

SUBDIVISION _____ ROAD _____ LOT _____

PROPERTY OWNER John Hoffman

ADDRESS 1046 Huntley Ave. Silver Spring Md

SPECIFICATIONS

DRAIN FIELD _____ DEPTH _____ FEET, BOTTOM AREA _____ SQ. FT.

SEWAGE PITS 1 PERGMENT SIDE-WALL AREA 7X 12' long wall SQ. FT.

SEPTIC TANK CAPACITY 750 GALLONS

FOR BARRAGE BORDER, INCREASE DISPOSAL AREA OR TANK CAPACITY FOR

OTHER _____

*may refer to A-01083
please attach to 00556 permit
paid for*


PLANS APPROVED BY Paul F. Wain DATE 4/22/59

FILL SEPTIC TANK AND DISTRIBUTION BOX WITH WATER BEFORE CALLING FOR AN INSPECTION. COVER RO-WORK UNTIL INSPECTED AND APPROVED.

NEITHER THE HOWARD COUNTY COMMISSIONERS NOR THE HEALTH DEPARTMENT IS RESPONSIBLE FOR THE SUCCESSFUL OPERATION OF ANY SYSTEM.

A00556

DW. in area total
 00555 3-2-59 148 2 1/2' 210-22 200-40 150-15 1/2' 1/2' 1/2'

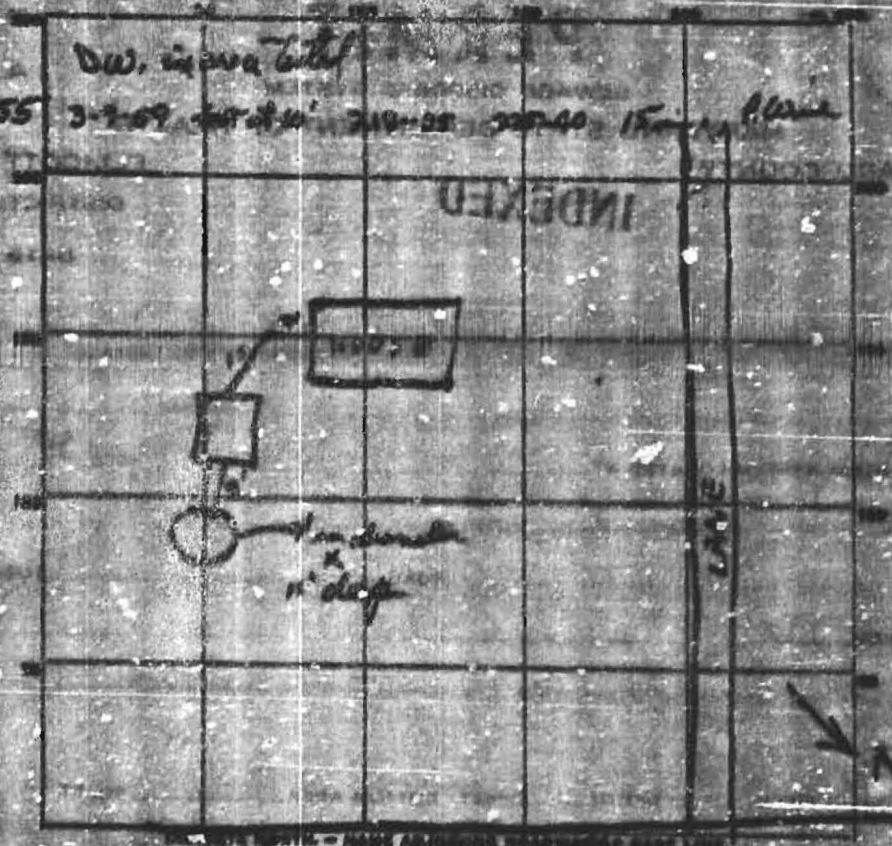

PERMIT CARD _____
 SEPTIC TANK, LENS 24 1100 gal. CEMENTS 1/4" diameter in wall
 DISTRIBUTION BOG, LENS _____ and dry well
 TILE FIELD, DEPTH _____ FT. THICK WIDEN _____ FT.
 GRAVEL DEPTH _____ IN. TOTAL LENGTH _____ FT.
 NUMBER OF TRENCHES _____ TOTAL BOTTOM AREA _____
 SUBPACK PYS, INSIDE DIAMETER 9 FT. DEPTH BELOW INLET 11 FT.
 ABSORBENT AREA 308 sq. ft. (should be 326 sq. ft.)

REMARKS _____

DATE SYSTEM APPROVED 9/15/59 INSPECTOR Raymond Hodge