

THIS REPORT
MUST BE SUBMITTED
WITHIN 30 DAYS
AFTER COMPLETION
OF THE WELL

WELL COMPLETION REPORT

Jessie Hill

WELL DESCRIPTION

WELL LOG

State the kind of formations penetrated, their color, their depth, their thickness, and if water-bearing

CASING AND SCREEN RECORD

State the kind and size and position of casing, liner, shoe, screen, and other accessories (if no casing used, give diameter of well).

Permit Number No. 66-11-214
Owner Jessie McCranken
Address Cyberville Md.
Subdivision _____
Section _____ Lot _____

	FEET		DIAM. (inches)	FEET	
	from	to		from	to
Top Soil	0-3		6 1/2"	0-88	
Sandy	3-80				
Granit	80-120				

PUMPING TEST

Hours Pumped 1
Type of Pump Used MP
Pumping Rate _____
Gallons per Minute 4

WATER LEVEL

Distance from land surface to water:
Before Pumping 45 Ft.
When Pumping 120 Ft.

APPEARANCE OF WATER

Clear _____ Cloudy _____
Taste _____
Odor _____


Height of Casing Above Land
Surface 2 Ft.

PUMP INSTALLED

Type _____
Capacity _____
Gallons per Minute _____
Gallons per Hour _____
Pump Column Length _____ Ft.

LOCATION OF WELL ON LOT

Show permanent structures such as building(s), septic tank, and/or other landmarks and indicate not less than 2 distances (measurements) to well.

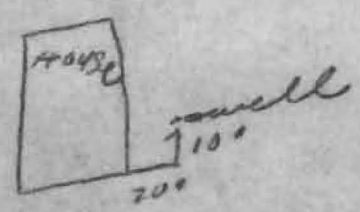

Date Well Was Completed Jan 17.66
Well Driller _____
Signature *[Signature]*

State Office Building
ANNAPOLIS, MARYLAND 21401

DEPARTMENT OF
WATER RESOURCES

APPLICATION MUST BE SUBMITTED AND PERMIT RECEIVED BEFORE DRILLING IS STARTED.
542

Fred Day Job. A 10586

APPLICATION FOR PERMIT TO DRILL WELL

Owner Jessy Mc. Crankin
Street or R. F. D. _____
Post Office Sykesville md.

Driller J. F. Castney License Number 140
Street or R. F. D. _____
Post Office mt. airy md.
Date Dec 27/65

Quantity of Water to be Produced 5 G.P.M.
Total Quantity Needed For Use _____ G.P.D.
Use for Water new house
Approximate Depth of Well (feet) 100
Method of Drilling to be used Rotary

Location of Well
Subdivision Ches. Hills
Section _____ Lot 1
County Howard
Nearest Town Sykesville
Distance from Town 3 mile
Direction from Town S

Is this a Replacement Well? Yes - No
If YES, indicate date abandoned well is to be sealed: _____
and by whom: _____

Description of Location of Well
(This information should be definite enough to permit locating well on a county map).
Near what road R 32
On which side of road _____
(North, East, South, West)
Distance from road 100 ft

PERMIT TO DRILL WELL
(Not To Be Filled In By Driller)

Well Permit No. Ho-bb-w-214

Samples of Cuttings Required by Department: Yes No
Owner Requires Permit to Appropriate Water: Yes No
Owner Has Permit to Appropriate Water: Yes No

Appropriation Permit No. _____
The applicant is herewith granted a permit to drill this well subject to the conditions stipulated.
Paul W. McKee
Director Date 1-3-66

THIS PERMIT IS NOT TRANSFERABLE
WITHOUT WRITTEN PERMISSION FROM THE DEPARTMENT
Special conditions that must be observed: _____

Health Department Approval of Application
Howard County Department of Health
or State Department of Health
Approved by Ronald P. Blatter
Title Superintendent
Date 12/30/65

Draw a sketch below showing location of well in relation to nearby towns, roads and streams with north in the direction of the arrow, and give distance from well to nearest road junction or stream crossing shown on the sketch.

