

APPLICATION

A 10586

SEWAGE DISPOSAL TESTING

P _____

MARYLAND STATE DEPARTMENT OF HEALTH

HOWARD COUNTY

ELLICOTT CITY

Septic Tank - 3 bedroom - 750 gal.
4 " " " 1000 gal.

DISTRICT 3

DATE 7/14/65

Dry Well - 100 sq. ft. sidewalk area below inlet pipe
per bedroom. Inlet pipe no deeper than 4 ft below
original grade.

Place Dry Well 4 ft from line parallel with Indian Way
and 60 ft from line parallel with Rt. 32.

TO: THE COUNTY HEALTH OFFICER
ELLICOTT CITY, MARYLAND

I, HEREBY, APPLY FOR THE NECESSARY TESTS IN ORDER TO CONSTRUCT (OR RECONSTRUCT) A SEWAGE DISPOSAL SYSTEM.

PROPERTY OWNER COUNTRY HOMES LTD.

ADDRESS 925 Rambling Drive, Baltimore 21228 PHONE _____

PROPERTY LOCATION:

SUBDIVISION INDIAN HILL LOT NO. One Block A

ROAD AND DESCRIPTION Cor. Route 32 and Indian Way

OCCUPANT Vacant PHONE _____

PERSON TO CONSTRUCT SYSTEM _____

ADDRESS _____ PHONE _____

SIZE OF LOT 1-1/2 A. TYPE BLDG. 3-4 B.R.

IF NOT SINGLE RESIDENCE DESCRIBE R. E. Canada

COUNTRY HOMES, LTD.

SIGNATURE OF APPLICANT 925 RAMBLING DRIVE


APPROVED BY [Signature] FOR Dry Well DATE 7/21/65

REJECTED BY _____ FOR _____ DATE _____

HOLD PENDING FURTHER TESTS _____ DATE _____

REASONS FOR REJECTION OR HOLDING _____

THIS IS NOT A PERMIT

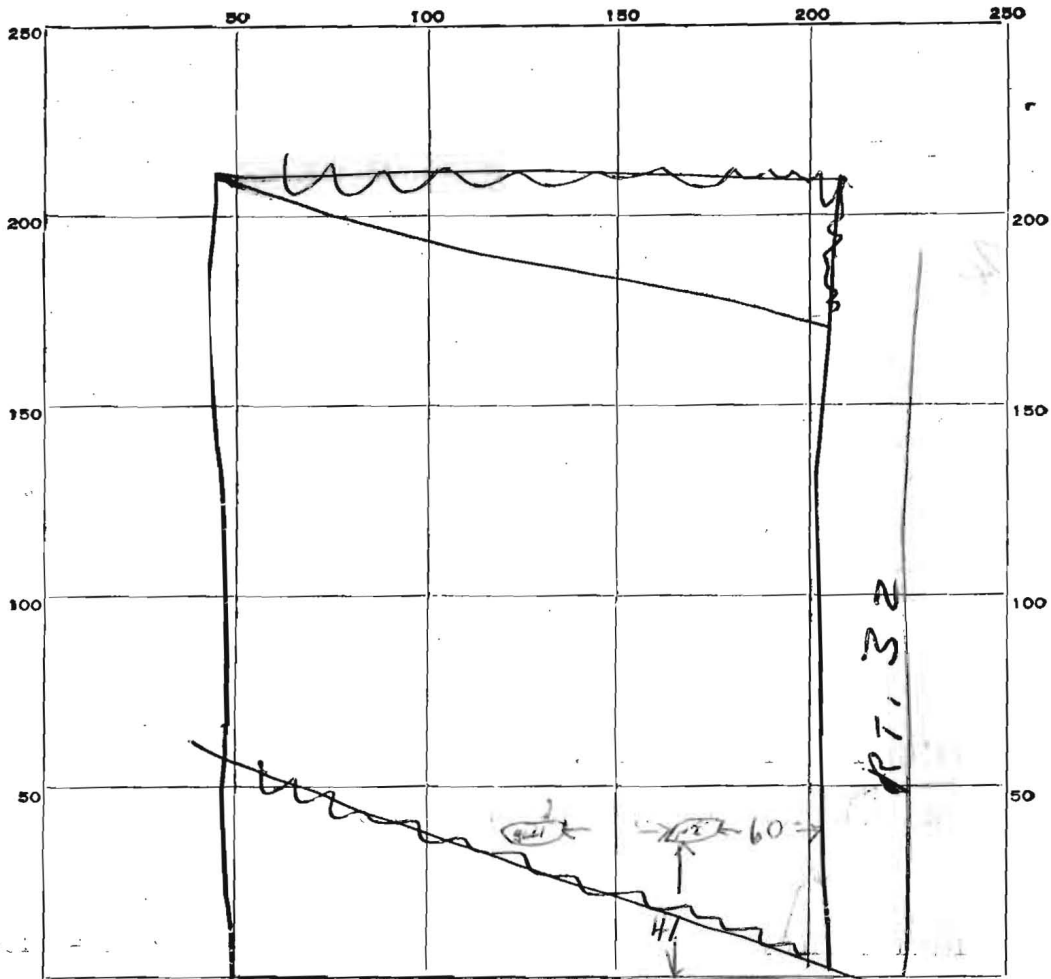

INDICATE NORTH. - NAME ADJOINING ROADWAY AS BASE LINE.

Indian Way

DATE	TEST NO.	DEPTH	PRE-WET		TEST - 1" DROP		TIME
			START	STOP	START	STOP	
7/28/60	1	4ft	9 44	9 47	9 47	9 52	5 min
	2	9ft	9 46	9 47	9 47	9 49	2 min
	3	4ft	9 52	9 54	9 54	10 20	6 min
	4 - 11	9ft	9 54	9 55	9 55	9 57	2 min

SOIL AUGER FINDING _____

TESTED BY lum

REMARKS _____

align C Smith/cur

LOT 1 B.R.A