

3/18/03 10 AM 3/24/03 final 10:30

PUB. SEWER STATUS VERIFIED BY NA (SRK)

ISSUE DATE: 3/14/03

P 518574

PERMIT

APPROVAL DATE: 3/24/03

INDEXED

A REPAIR

ON-SITE SEWAGE DISPOSAL SYSTEM HOWARD COUNTY HEALTH DEPARTMENT BUREAU OF ENVIRONMENTAL HEALTH

05-346983

Jenkins Bros. Septic Service IS PERMITTED TO INSTALL ALTER

ADDRESS: 7670 Smith's Private Rd., 2178 PHONE NUMBER: 410-461-9282

SUBDIVISION: Cabin Hill LOT NUMBER: 11

ADDRESS: 12934 Kentbury Drive PROPERTY OWNER: Robert Cornelius

SEPTIC TANK CAPACITY (GALLONS): 1250 (h) 301-854-9881

PUMP CHAMBER CAPACITY (GALLONS): N/A (w) 410-313-5520
Nancy Cornelius

NUMBER OF BEDROOMS: 4

SQUARE FEET PER BEDROOM: (210 x 4) / 2 x .62 = 174

LINEAR FEET OF TRENCH REQUIRED: 174; (3) 57' trenches

TRENCHES:	Trench to be <u>3</u> feet wide. Inlet <u>4</u> feet below original grade. Bottom maximum depth <u>6</u> feet below original grade. Effective area begins at <u>4</u> feet below original grade. <u>2</u> feet of stone below distribution pipe.
LOCATION:	<u>Existing septic tank & dry well to be properly abandoned.</u>
PURPOSE:	Existing septic system has failed. Call for inspection when ground is opened so sanitarian can recommend repair.

PLANS APPROVED: Steven Knes / F. Alfonso DATE: 3/18/03

- NOTE: PERMIT VOID AFTER 2 YEARS
- NOTE: CONTRACTOR RESPONSIBLE FOR SCHEDULING A PRE-CONSTRUCTION INSPECTION FOR ALL INSTALLATIONS
- NOTE: WATERTIGHT SEPTIC TANKS REQUIRED
- NOTE: ALL PARTS OF SEPTIC SYSTEM SHALL BE 100 FEET FROM ANY WATER WELL
- NOTE: MANHOLE RISERS REQUIRED ON ALL SEPTIC TANKS AND PUMP CHAMBERS

NEITHER THE HOWARD COUNTY COUNCIL NOR THE HEALTH DEPARTMENT IS RESPONSIBLE FOR THE SUCCESSFUL OPERATION OF ANY SYSTEM PERMITTEE RESPONSIBLE FOR OBTAINING FINAL APPROVAL ON THIS PERMIT CALL 410-313-2640 FOR INSPECTION OF SEPTIC SYSTEM


P518574

NOT TO SCALE

INDEXED

TRENCH/DRAINFIELD DATA		
WIDTH	INLET	BOTTOM
_____	_____	_____
NUMBER OF TRENCHES _____		
TOTAL LENGTH _____		
ABSORPTION AREA _____		
DISTRIBUTION BOX LEVEL _____		
DISTRIBUTION BOX BAFFLE <u>Yes</u>		
DISTRIBUTION BOX PORT <u>No</u>		

SEPTIC TANK DATA	
SEPTIC TANK 1 LEVEL	<u>✓</u>
CAPACITY	<u>1250</u> GAL
SEAM LOC	<u>TS.</u>
TANK LID DEPTH	<u>2'±</u>
BAFFLES	<u>✓</u>
BAFFLE FILTER	_____
MANHOLE LOC	<u>✓</u>
6" PORT LOC	_____
WATERTIGHT TEST	<u>NA</u>
SEPTIC TANK 2 LEVEL	<u>NA</u>
CAPACITY	_____ GAL
SEAM LOC	_____
TANK LID DEPTH	_____
BAFFLES	_____
BAFFLE FILTER	_____
MANHOLE LOC	_____
6" PORT LOC	_____
WATERTIGHT TEST	<u>↓</u>

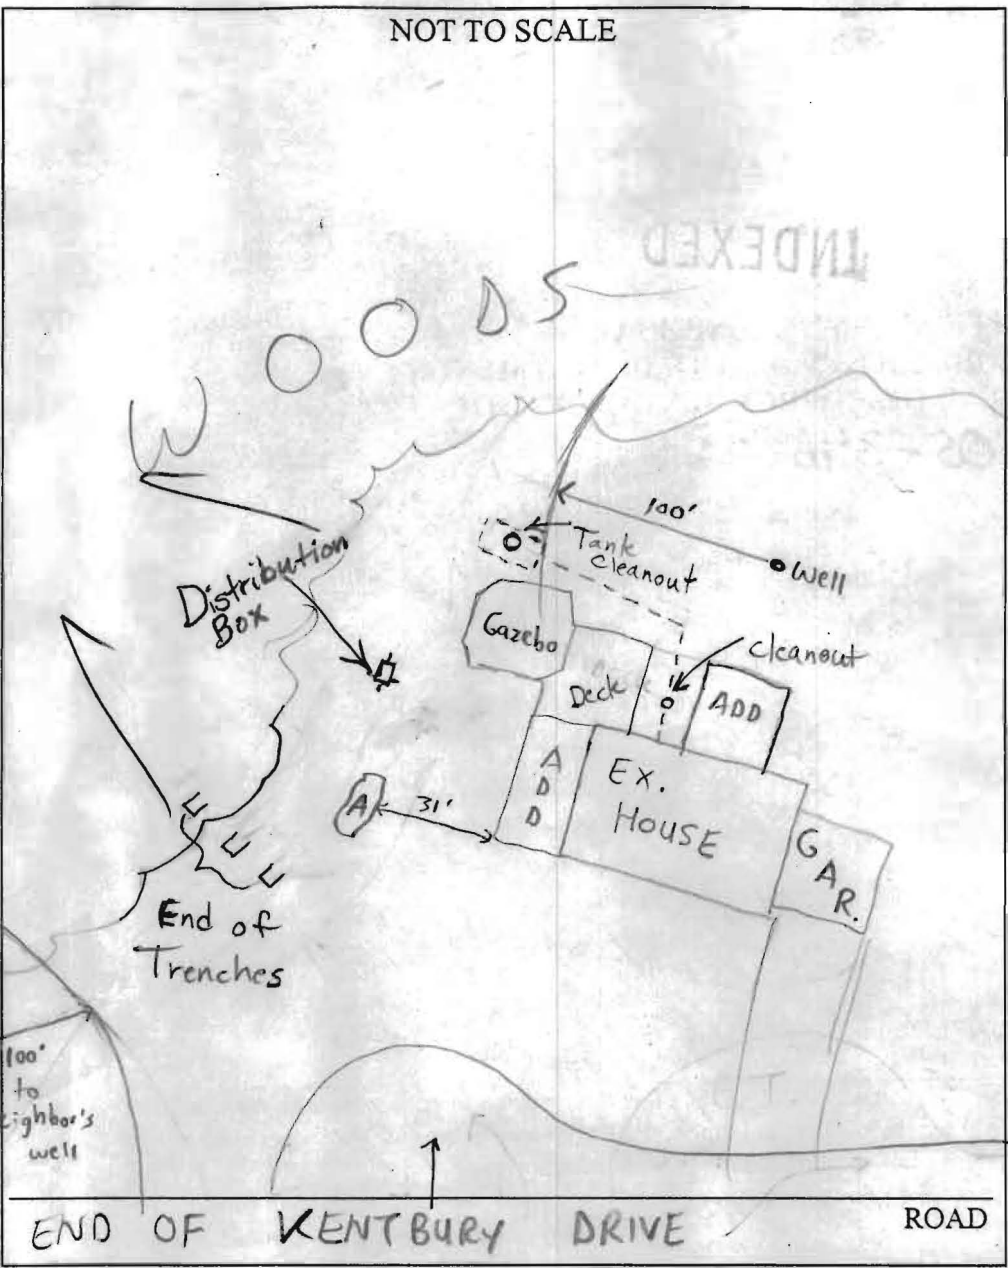

PRE-CONSTRUCTION 3/18/03 - DUG PERC HOLE IN LOCATION (A) SEE SOIL PROFILE, INSTALL

AS PER DISCUSSED IN FIELD (ON REVERSE), EX. ST & D.W. UNDER EXISTING DECK & GAZEBO TO BE PROPERLY ABANDONED (SRV, FA, SO) INSTALLATION

3/24/03 Everything covered, except distribution box and end of trenches, because of rain. Reminded Jenkins to keep open until inspected. Saw stone and tank receipts. 67 tons of stone and a 1250 top seam were delivered to site.

Jenkins said old septic tank pumped out and filled. Drywell supposedly had one more truckload of sewage before it could be collapsed and filled. A hose was running

FINAL INSPECTOR B. Baker DATE OF APPROVAL 3/24/03

from the drywell to the street.