

12/2/76
After lunch please

PERMIT

SEWAGE DISPOSAL SYSTEM

MARYLAND STATE DEPARTMENT OF HEALTH

HOWARD COUNTY

ELLICOTT CITY

DISTRICT 5th

INDEXED

DATE 11/1/76

Emerson Pease

IS PERMITTED TO INSTALL ALTER

ADDRESS Old Frederick Road, Woodstock, Md. 21163

PHONE 328-2481

A SEWAGE DISPOSAL SYSTEM LOCATED AT

SUBDIVISION Cabin Hill

ROAD 12934 Kenbury Drive

LOT 11, Blk. A, Sec. 2

PROPERTY OWNER Mr. & Mrs. Robert Cornelius

ADDRESS

SPECIFICATIONS 3 bedrooms

DRAIN FIELD _____ DEPTH _____ FEET, BOTTOM AREA _____ SQ. FT.

SEEPAGE PITS _____ ABSORBENT SIDE-WALL AREA _____ SQ. FT.

SEPTIC TANK CAPACITY 1000 GALLONS

FOR GARBAGE GRINDER, INCREASE DISPOSAL AREA 25% & TANK CAPACITY 50%.

OTHER 12/1/76 DRY WELL To have 125 sq. ft. effective absorbent sidewall area per bedroom below first floor ft. of original soil. Install tank same in at 4 ft. and maximum depth 11 1/2 ft. below original grade. Locate dry well 20-25 ft. from left rear corner of property line along back property line and 12-15 ft. from back property line.

NOTE! ALL PIPE FROM HOUSE TO DISPOSAL AREA MUST BE CAST IRON.

PERMIT VOID AFTER THREE YEARS.

NOTE! INSTALL STAND PIPE ON SEPTIC TANK AND DRY WELL. STAND PIPES MUST BE 4-6 INCHES IN DIAMETER. CAST IRON, CONCRETE OR TERRA COTTA ACCEPTED.

PLANS APPROVED BY Charles E. Streaker

DATE 9/28/75


FILL SEPTIC TANK AND DISTRIBUTION BOX WITH WATER BEFORE CALLING FOR AN INSPECTION. COVER NO WORK UNTIL INSPECTED AND APPROVED.

NEITHER THE HOWARD COUNTY COMMISSIONERS NOR THE HEALTH DEPARTMENT IS RESPONSIBLE FOR THE SUCCESSFUL OPERATION OF ANY SYSTEM.

BLDG. PERMIT SIGNED AND RETURNED 7/31/92 Serial # 44794 enclosed photo

BLDG. PERMIT SIGNED AND RETURNED 11/1/76 Serial # 4476 addition - plumbing room in Bedroom

11676

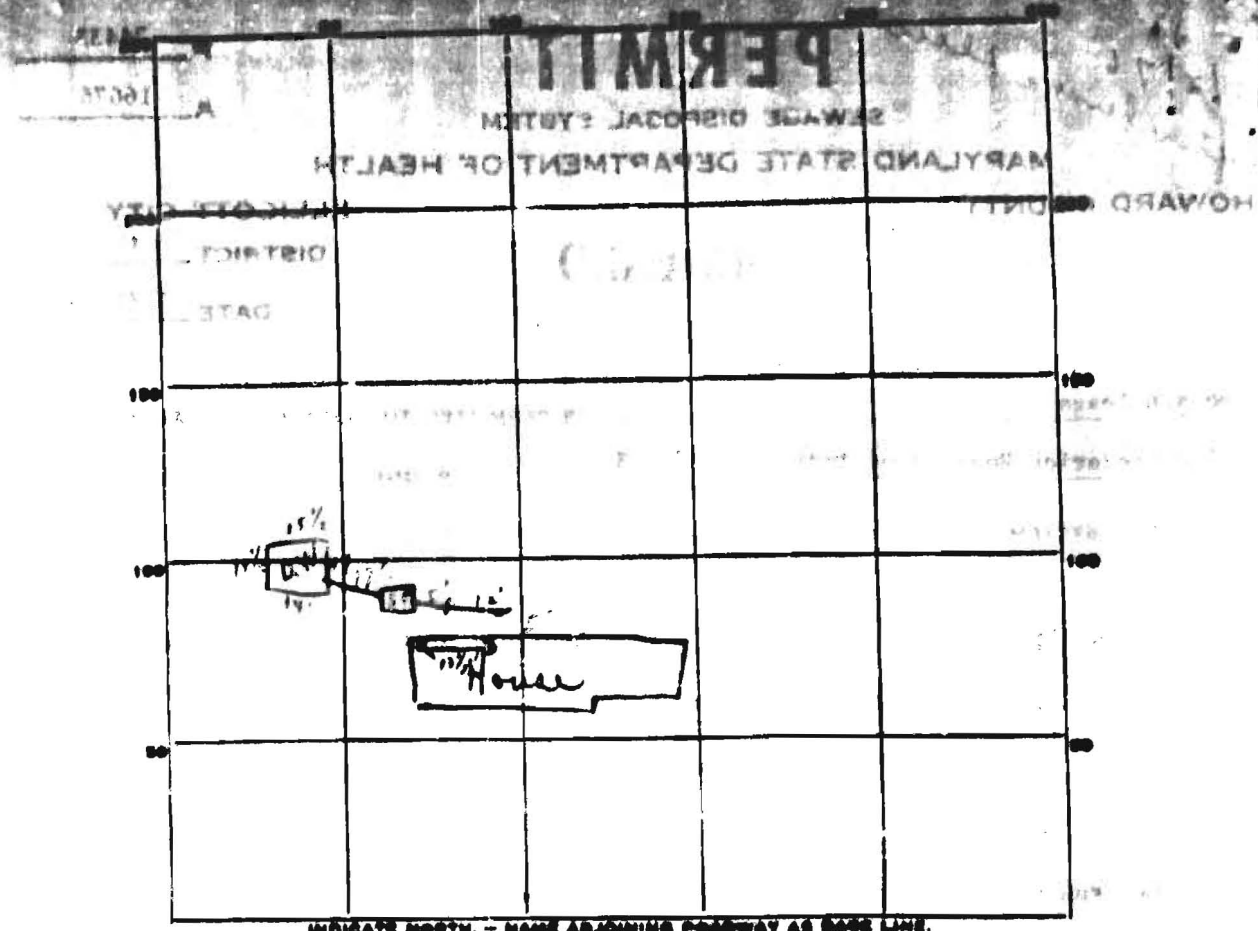

PERMIT CARD for Not seen Arthur Prince S.T D.W

SEPTIC TANK, LEVEL ok CLEANOUTS 1

DISTRIBUTION BOX, LEVEL ↔

TILE FIELD, DEPTH Trench FT. TRENCH WIDTH 1 FT.

GRAVEL DEPTH 1 IN. TOTAL LENGTH 1 FT.

NUMBER OF TRENCHES 1 TOTAL BOTTOM AREA 1

SEEPAGE PITS, INSIDE DIAMETER outside diameter 59 FT. DEPTH BELOW INLET 1 FT.

ABSORBENT AREA 402 SQ. FT.

REMARKS 12/2/76 not seen all to be replaced
work done by D.W.N

DATE SYSTEM APPROVED 12/2/76 INSPECTOR C. B. Tucker



I CERTIFY the above measurements
 + ELEVATIONS are correct & correct
 for this property
 Nancy Hedy
 Charles W. Hedy
 6/9/76

KENTBURY DRIVE

CABIN HILL Sub. Div.
 Lot. 11
 BLK. A
 SEC. 2
 OWNER:
 MR + MRS ROBERT CORNELIUS
 SCALE: 1" = 50'