

APPLICATION

PERCOLATION TESTING

A REPAIR
P 518574

HOWARD COUNTY HEALTH DEPARTMENT
BUREAU OF ENVIRONMENTAL HEALTH
3525-H ELLICOTT MILLS DRIVE/ELLICOTT CITY, MARYLAND 21043
TELEPHONE: 313-2640

DISTRICT _____

DATE 3/14/03

TO: THE COUNTY HEALTH OFFICER
ELLICOTT CITY, MARYLAND

I HEREBY APPLY FOR THE NECESSARY TEST PRIOR TO APPLICATION FOR PERMIT TO CONSTRUCT (OR RECONSTRUCT) A SEWAGE DISPOSAL SYSTEM.

PROPERTY OWNER _____

ADDRESS 12936 Kentbury Drive PHONE _____

AGENT OR PROSPECTIVE BUYER _____

ADDRESS _____ PHONE _____

PROPERTY LOCATION:

SUBDIVISION Cabin Hill LOT NO. 11

ROAD AND DESCRIPTION 12934 Kentbury Drive

TAX MAP 34 PARCEL # 300

SIZE OF LOT _____ TYPE BLDG. _____
(SINGLE FAMILY DWELLING OR COMMERCIAL)

THE SYSTEM INSTALLED UNDER THIS APPLICATION IS ACCEPTABLE ONLY UNTIL PUBLIC FACILITIES BECOME AVAILABLE. I FULLY UNDERSTAND THE FEE CONNECTED WITH THE FILING OF THIS PERC TEST APPLICATION IS NON-REFUNDABLE UNDER ANY CIRCUMSTANCES. I ALSO AGREE TO COMPLY WITH ALL M.O.S.H.A. REQUIREMENTS IN TESTING THIS LOT.
(SIGNATURE OF APPLICANT)

APPROVED BY _____ FOR _____ DATE _____

DISAPPROVED BY _____ FOR _____ DATE _____

HOLD PENDING FURTHER TESTS _____

REASONS FOR REJECTION OR HOLDING _____

PERCOLATION TEST PLAT/PRELIMINARY PLAT - TITLE OR I.D. # _____ DATE _____

SITE DEVELOPMENT PLAN/FINAL PLAT - TITLE OR I.D. # _____ DATE _____

THIS IS NOT A PERMIT

518574

12936 KENTUCKY DRIVE

COUNTY #

SOIL PROFILE

0' **A**

DK BROWN TO BLACK TOPSOIL 8"

Light Brown Silty loam 2'

Red Brown Sandy Clay loam 3'


Red Yellow Brown Variegated Colors Micaceous Silty loam

20% Degraded Saprolite

SEEPAGE @ 14' @ 10' Bright Orange matrix color (Potential redoximorphic feature)

SOIL PROFILE

0'

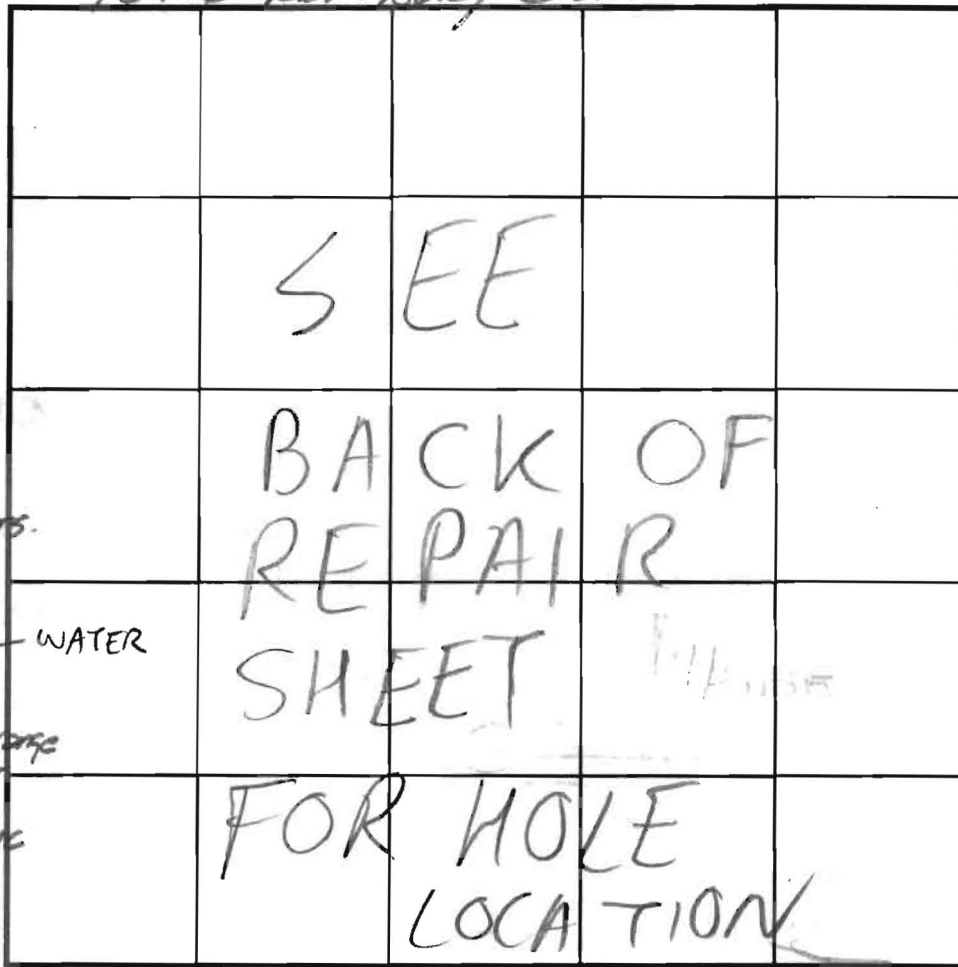

INDICATE NORTH - NAME ADJOINING ROADWAY AS BASE LINE.

DATE	TEST NO.	DEPTH	PRE-WET		TEST - 1" DROP		TIME
			START	STOP	START	STOP	
3/18/03	A	4 1/2' / 14'	11:58	12:07	12:07	12:21	14 min

REMARKS _____

TYPE OF SOIL Mixture - Glenelg, Manor

TESTED BY SRK / PA / SO ALSO PRESENT Mike Jenkins Ron Heaps

TRENCH DESIGN DATA: AVERAGE PERCOLATION TIME 9 min est. TRENCH WIDTH 3'

INLET DEPTH 4 MAXIMUM BOTTOM DEPTH 6 SQ. FT/BEDROOM 210

APPLICATION

A 16676

P _____

SEWAGE DISPOSAL TESTING

MARYLAND STATE DEPARTMENT OF HEALTH

HOWARD COUNTY

ELLICOTT CITY

DISTRICT 3

DATE 1/24/72

TO: THE COUNTY HEALTH OFFICER
ELLICOTT CITY, MARYLAND

I, HEREBY, APPLY FOR THE NECESSARY TESTS IN ORDER TO CONSTRUCT OR RECONSTRUCT A SEWAGE DISPOSAL SYSTEM.

PROPERTY OWNER Cabin Hill Corp.

ADDRESS Sharp Rd., Glenwood, Md. PHONE 489-4304

PROPERTY LOCATION:

SUBDIVISION Cabin Hill LOT NO. 11, Blk. A, Sect. 2

ROAD AND DESCRIPTION Unnamed Road,

OCCUPANT _____ PHONE _____

PERSON TO CONSTRUCT SYSTEM _____

ADDRESS _____ PHONE _____

SIZE OF LOT 317' x 250' x 252' TYPE BLDG. 3 or 4 bedroom
NUMBER OF BEDROOMS

IF NOT SINGLE RESIDENCE DESCRIBE _____

SIGNATURE OF APPLICANT /s/ Jack DEVERNEUX


APPROVED BY _____ FOR _____ DATE _____
(NAME OF OFFICER)

REJECTED BY _____ FOR _____ DATE _____
(NAME OF OFFICER)

HOLD PENDING FURTHER TESTS _____ DATE _____

REASONS FOR REJECTION OR HOLDING _____

THIS IS NOT A DEEDMIT

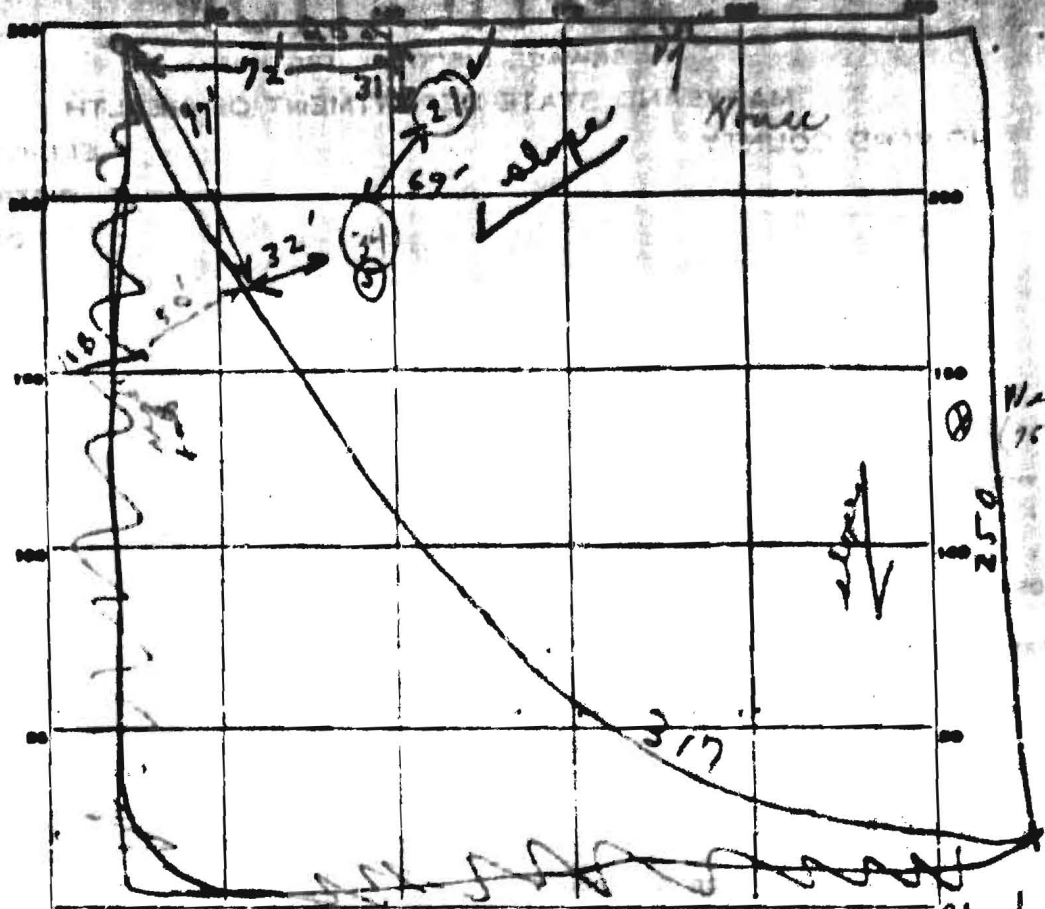

INDICATE NORTH. - NAME ADJOINING ROADWAY AS BASE LINE.

clock Lot 11 B

DATE	TEST NO.	DEPTH	PRE-WET		TEST - 1" DROP		TIME
			START	STOP	START	STOP	
8/15/62	1	5'	3:45	3:47	3:47	3:50	3 min
	2	11 1/2'	3:45	3:51	3:51	4:00	9 min
	3	5'	3:47	Pulled to slow down shell			
	4	12 1/2'	3:47	3:50	3:50	3:57	9 min
8/15/62	5	4 1/2'	10:09	10:10	10:10	10:12	2 min
						4:21	

SOIL AUGER FINDING

TESTED BY B.S. Use 1+2

REMARKS Lower ground