

STATE OF MARYLAND WATER RESOURCES ADMINISTRATION
TAKES STATE OFFICE BLDG., ANNAPOLIS, MD. 21401
WELL COMPLETION REPORT

WELL NO. 3315 DEPTH OF WELL 300
 DATE WELL COMPLETED 10/2/76

OWNER Verant, Helen STREET OR RFD 261 1/2 St. Rd. POST OFFICE Woodstock

PERMIT NO. FROM "PERMIT TO DRILL WELL" HO-73-13178

WELL LOG

STATE THE KIND OF FORMATIONS PENETRATED, THEIR COLOR, DEPTH, THICKNESS AND IF WATER BEARING

DEPTH (FEET)	DESCRIPTION	PERM	WATER
0-2	...		
2-50	...		
50-55	...		
55-58	...		
58-60	...		
60-300	...		

GROUTING RECORD

WELL HAS BEEN GRouted (CHECK APPROPRIATE BOX) Y N

TYPE OF GRouting MATERIAL (CHECK ALL THAT APPLY)

CEMENT CM DEBRITE SLAY BC

NO. OF BAGS 10 NO. OF POUNDS 1000

GALLONS OF WATER 50

DEPTH OF GROUT SEAL (TO NEAREST FOOT)

FROM 0 FT. TO 40 FT.

ENTERED IF FROM SURFACE: YES NO

CASING RECORD

CASING TYPES (CHECK ALL THAT APPLY)

INSERT APPROPRIATE CODE BELOW

STEEL S1 CONCRETE C2

PLASTIC PL OTHER O1

MAIN CASING TYPE S1 TOP NOMINAL DIAMETER OF MAIN CASING (NEAREST INCH) 6

TOTAL DEPTH OF MAIN CASING (NEAREST FOOT) 300

OTHER CASING (IF USED)

DIAMETER (INCH) _____ DEPTH (FEET) _____

SCREEN RECORD

SCREEN TYPE (CHECK ALL THAT APPLY)

INSERT APPROPRIATE CODE BELOW

STEEL S1 BRASS OR COPPER BR OPEN HOLE HO

PLASTIC PL OTHER O1

SCREEN LOCATION

DEPTH (NEAREST WHOLE FOOT)

1 40 2 58 3 300

DIAMETER OF SCREEN _____ INCHES

GRAVEL PACK _____

IF WELL DRILLED WAS A FLOWING WELL (CIRCLE BOX) F

WHA USE ONLY (NOT TO BE FILLED IN BY DRILLER)

TELESCOPE CASING T1 LOG INDICATOR L2 OTHER DATA AVAILABLE O1 O2 O3

PUMPING TEST

HOURS PUMPED (TO NEAREST HOUR) 3

PUMPING RATE (GALLONS PER MINUTE TO NEAREST GALLON) 2

METHOD USED TO MEASURE PUMPING RATE ...

WATER LEVEL (MEASURED FROM LAND SURFACE)

BEFORE PUMPING 50 INCHES DEEP

DURING PUMPING 300 INCHES DEEP

TYPE OF PUMPER USED (CHECK ALL THAT APPLY)

A ALF P PISTON Y YODDING

C CENTRIFUGAL R ROTARY O OTHER (DESCRIBE BELOW)

J JET S SUBMERSIBLE

PUMP INSTALLED

TYPE OF PUMP (WRITE APPROPRIATE LETTER IN BOX - SEE ABOVE: A, C, J, P, S, Y, O)

DRILLER WILL INSTALL PUMP (CHECK APPROPRIATE BOX) Y N

CAPACITY: _____ GALLONS PER MINUTE (TO NEAREST GALLON)


PUMP HORSE POWER _____

PUMP COLUMN LENGTH (NEAREST FOOT) _____

CASING HEIGHT (CHECK APPROPRIATE BOX AND ENTER CASING HEIGHT)

A ABOVE BELOW

LAND SURFACE _____ NEAREST FOOT

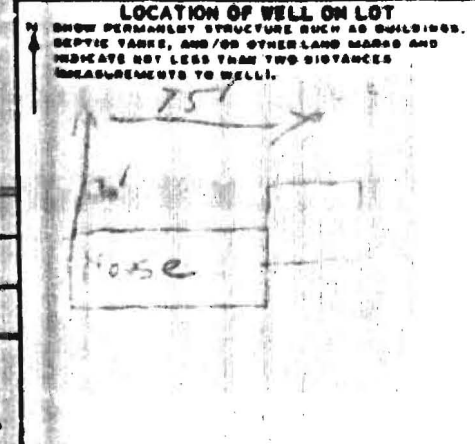

CIRCLE APPROPRIATE BOXES

A WELL WAS ABANDONED AND STAGED WHEN THIS WELL WAS COMPLETED

E ELECTRIC LOG OBTAINED

B TEST WELL SUBJECT TO REVISION WITH

I HEREBY CERTIFY THAT I HAVE COMPLIED WITH ALL CONDITIONS STATED ON THE ABOVE-CAPTIONED "PERMIT TO DRILL WELL", AND THAT INFORMATION CONTAINED IN THIS REPORT IS TRUE, ACCURATE, AND COMPLETE TO THE BEST OF MY KNOWLEDGE, INFORMATION AND BELIEF.

DRILLER'S NAME _____

(IN INK OR PRINT) _____

SIGNATURE _____