

PUB. SEWER STATUS VERIFIED BY _____

ISSUE DATE: _____

APPROVAL DATE: _____

PERMIT INDEXED

P 518621-C

A Re-indexed

ON-SITE SEWAGE DISPOSAL SYSTEM HOWARD COUNTY HEALTH DEPARTMENT BUREAU OF ENVIRONMENTAL HEALTH

04-308891

_____ IS PERMITTED TO INSTALL ALTER

ADDRESS: _____ PHONE NUMBER: _____

SUBDIVISION: Rob Johnsen LOT NUMBER: 4

ADDRESS: 3245 Jennings Chapel Road PROPERTY OWNER: Herbert Atwell

SEPTIC TANK CAPACITY (GALLONS): _____

PUMP CHAMBER CAPACITY (GALLONS): _____

NUMBER OF BEDROOMS: _____

SQUARE FEET PER BEDROOM: _____

LINEAR FEET OF TRENCH REQUIRED: _____

TRENCHES:	Trench to be _____ feet wide. Inlet _____ feet below original grade. Bottom maximum depth _____ feet below original grade. Effective area begins at _____ feet below original grade. _____ feet of stone below distribution pipe.
LOCATION:	_____
PURPOSE:	_____

PLANS APPROVED: _____ DATE: _____

- NOTE: PERMIT VOID AFTER 2 YEARS
- NOTE: CONTRACTOR RESPONSIBLE FOR SCHEDULING A PRE-CONSTRUCTION INSPECTION FOR ALL INSTALLATIONS
- NOTE: WATERTIGHT SEPTIC TANKS REQUIRED
- NOTE: ALL PARTS OF SEPTIC SYSTEM SHALL BE 100 FEET FROM ANY WATER WELL
- NOTE: MANHOLE RISERS REQUIRED ON ALL SEPTIC TANKS AND PUMP CHAMBERS

**NEITHER THE HOWARD COUNTY COUNCIL NOR THE HEALTH DEPARTMENT IS
RESPONSIBLE FOR THE SUCCESSFUL OPERATION OF ANY SYSTEM
PERMITTEE RESPONSIBLE FOR OBTAINING FINAL APPROVAL ON THIS PERMIT
CALL 410-313-2640 FOR INSPECTION OF SEPTIC SYSTEM**

P 518621-C

PERMIT

SEWAGE DISPOSAL SYSTEM

MARYLAND STATE DEPARTMENT OF HEALTH

HOWARD COUNTY

ELLICOTT CITY

DISTRICT 4th

DATE 6-16-71

INDEXED

P 16029
A 10929

47 7.8-71
DWH

7/2/71
mcm
DWH

William Hopkins IS PERMITTED TO INSTALL ALTER

ADDRESS Woodbine, Maryland PHONE _____

A SEWAGE DISPOSAL SYSTEM LOCATED AT _____

SUBDIVISION _____ ROAD Jennings Chapel Rd. LOT 4

PROPERTY OWNER Herbert C. Atwell

ADDRESS 6400 9th Avenue, Chillum, Maryland 559-2000

SPECIFICATIONS 4 - Bedrooms

DRAIN FIELD _____ DEPTH _____ FEET, BOTTOM AREA _____ SQ. FT. *Serial No. 39587*

SEEPAGE PITS _____ ABSORBENT SIDE-WALL AREA _____ SQ. FT.

SEPTIC TANK CAPACITY 1200 GALLONS *BLDG. PERMIT SIGNED AND RETURNED 6/17/79 Pool Permit*

FOR GARBAGE GRINDER, INCREASE DISPOSAL AREA 25% & TANK CAPACITY 50%.

OTHER DRY WELL -- 17 ft. square (sit block and top for 12 ft. and fill in rest of pit with gravel) and 8 ft. deep below inlet pipe. Or 2 Dry Wells 225 sq. ft. of absorbent area each.

Place Dry Well 26 1/2 ft. from front lot line and 13 1/2 ft. from left sideline as seen when facing lot from Jennings Chapel Road. Maximum depth permitted for dry wells is 12 ft. below original grade -- if water is encountered call this department.


NOTE: ALL PIPE FROM HOUSE TO TANK MUST BE CAST IRON.
PERMIT VOID AFTER THREE YEARS.

PLANS APPROVED BY Donald W. Monaghan DATE 9-23-65

FILL SEPTIC TANK AND DISTRIBUTION BOX WITH WATER BEFORE CALLING FOR AN INSPECTION. COVER NO WORK UNTIL INSPECTED AND APPROVED.

NEITHER THE HOWARD COUNTY COMMISSIONERS NOR THE HEALTH DEPARTMENT IS RESPONSIBLE FOR THE SUCCESSFUL OPERATION OF ANY SYSTEM.

10929

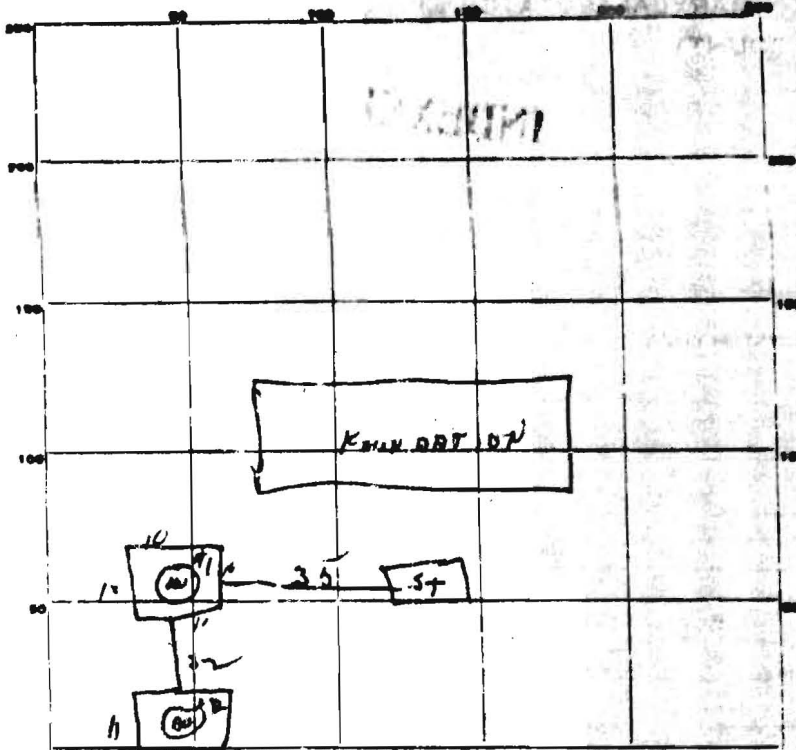

INDICATE NORTH. NAME ADJOINING ROADWAY AS BASE LINE

Jennings Chapel Rd

PERMIT CARD OK

SEPTIC TANK, LEVEL OK CLEANOUTS OK

DISTRIBUTION BOX, LEVEL _____

TILE FIELD, DEPTH _____ FT. TRENCH WIDTH _____ FT.

GRAVEL DEPTH _____ IN. TOTAL LENGTH _____ FT.

NUMBER OF TRENCHES _____ TOTAL BOTTOM AREA _____

SEEPAGE PITS, INSIDE DIAM. IN _____ FT. DEPTH BELOW EJECT _____ FT.

ABSORBENT AREA _____ SQ. FT.

REMARKS
 Dry Well #1 - granite 40' x 6ft = 240' 7480'
 Dry Well #2 - granite 40ft x 6ft + labor = 2407 sqft 99'

Plugs must be removed from Dry Well so depth can be measured.
 inside 8" diameter steel pipe on tank - must call for
 final inspection when above is done + when final permit tank is done

DATE SYSTEM APPROVED 7-8-71 INSPECTOR W. M. M...