

C 1 7614

SEQUENCE NO. (DWR USE ONLY)

STATE OF MARYLAND DEPARTMENT OF WATER RESOURCES STATE OFFICE BLDG., ANNAPOLIS, MARYLAND 21401

THIS REPORT MUST BE SUBMITTED WITHIN 30 DAYS AFTER WELL COMPLETION

FILL IN THIS FORM COMPLETELY

WELL COMPLETION REPORT

(THIS NUMBER IS TO BE PUNCHED IN COLS. 3-6 ON ALL CARDS)

DATE RECEIVED (DWR USE ONLY)

DATE WELL COMPLETED

DEPTH OF WELL

22 (TO NEAREST FOOT) 26

PERMIT NO. FROM "PERMIT TO DRILL WELL"

HO-TI-0167

DRILLERS IDENTIFICATION NO.

OWNER LAST NAME

FIRST NAME

STREET OR RFD

POST OFFICE

WELL LOG STATE THE KIND OF FORMATIONS PENETRATED, THEIR COLOR, DEPTH, THICKNESS AND IF WATER BEARING

Table with columns: DESCRIPTION (USE ADDITIONAL SHEETS IF NECESSARY), FEET (FROM, TO), CHECK IF WATER BEARING

Yellow shale 0-42 60 90 Gray Brown 72 60 90 70 90 60 90 70 90

GROUTING RECORD

WELL HAS BEEN GROUTED (CIRCLE APPROPRIATE BOX) YES [Y] NO [N] TYPE OF GROUTING MATERIAL (CIRCLE BOX) CEMENT [C] M BENTONITE CLAY [B] C 45 46 45 46

DEPTH OF GROUT SEAL (TO NEAREST FOOT) FROM 48 FT. TO 54 FT. (ENTER 0 IF FROM SURFACE)

CASING RECORD INSERT APPROPRIATE CODE BELOW [S] T [C] O [P] L [O] T STEEL CONCRETE PLASTIC OTHER

MAIN CASING TYPE [S] T NOMINAL DIAMETER TOP (MAIN) CASING (NEAREST INCH) 60 61 63 64 66 70 TOTAL DEPTH OF MAIN CASING (NEAREST FOOT) 50

OTHER CASING (IF USED) DIAMETER (INCH) DEPTH (FEET) FROM TO

SCREEN RECORD SCREEN TYPE OR OPEN HOLE INSERT APPROPRIATE CODE BELOW [S] T [B] R [H] O [P] L [O] T STEEL BRASS OR BRONZE OPEN HOLE PLASTIC OTHER

DEPTH (NEAREST WHOLE FOOT) FROM 11 TO 15 17 21 23 24 26 30 32 36 38 39 41 45 47 51

PUMPING TEST

HOURS PUMPED (TO NEAREST HOUR) 8 9 PUMPING RATE (GALLONS PER MINUTE TO NEAREST GALLON) 11 15 WATER LEVEL: (DISTANCE FROM LAND SURFACE) BEFORE PUMPING 17 20 (NEAREST FOOT) WHEN PUMPING 22 25 (NEAREST FOOT) TYPE OF PUMP USED (CIRCLE APPROPRIATE BOX) [A] AIR [P] PISTON [T] TURBINE [C] CENTRIFUGAL [R] ROTARY [O] OTHER [J] JET [S] SUBMERSIBLE

PUMP INSTALLED

DRILLER WILL INSTALL PUMP (CIRCLE APPROPRIATE BOX) YES [Y] NO [N] CAPACITY: GALLONS PER MINUTE (TO NEAREST GALLON) 31 35 PUMP HORSE POWER 37 41 PUMP COLUMN LENGTH (NEAREST FOOT) 43 47

CASING HEIGHT (CIRCLE APPROPRIATE BOX AND ENTER CASING HEIGHT) [+] ABOVE [-] BELOW LAND SURFACE (NEAREST FOOT) 49 50 51

LOCATION OF WELL ON LOT SHOW PERMANENT STRUCTURE SUCH AS BUILDINGS, SEPTIC TANKS, AND/OR OTHER LAND MARKS AND INDICATE NOT LESS THAN TWO DISTANCES (MEASUREMENTS TO WELL).

CIRCLE APPROPRIATE BOXES [A] A WELL WAS ABANDONED AND SEALED WHEN THIS WELL WAS COMPLETED [E] ELECTRIC LOG OBTAINED [C] COPY OF ELECTRIC LOG ATTACHED

I HEREBY CERTIFY THAT I HAVE COMPLIED WITH ALL CONDITIONS STATED ON THE ABOVE-CAPTIONED "PERMIT TO DRILL WELL", AND THAT INFORMATION CONTAINED IN THIS REPORT IS TRUE, ACCURATE, AND COMPLETE TO THE BEST OF MY KNOWLEDGE, INFORMATION AND BELIEF.

DRILLERS NAME (PLEASE PRINT) SIGNATURE

DIAMETER OF SCREEN 56 60 (NEAREST INCH) FROM TO

GRAVEL PACK IF WELL DRILLED WAS A FLOWING WELL CIRCLE BOX 68 [F]

DWR USE ONLY (NOT TO BE FILLED IN BY DRILLER) (E.R.O.S.) [T] 70 [W] 72 [Q] 74 75 76 LOG INDICATOR OTHER DATA AVAILABLE

4498 (SEQ. NO.)
 STATE OF MARYLAND
 DEPARTMENT OF WATER RESOURCES
 STATE OFFICE BLDG., ANNAPOLIS, MARYLAND 21401
 APPLICATION FOR PERMIT TO DRILL WELL
 FILL IN THIS FORM COMPLETELY

OWNER: AT well Herbert C.
 STREET OR RFD: 3245 Jennings Chapel RD
 POST OFFICE: Wood Pine MD

B 1 CONTINUED DRILLER INFORMATION
 DATE: June 8 1971
 LICENSE NUMBER: 601
 SIGNATURE: Harry Green

B 2 WELL INFORMATION
 MAXIMUM PUMPING RATE (GALLONS PER MINUTE): 5
 AVERAGE DAILY QUANTITY NEEDED (GALLONS PER DAY): 600
 USE FOR WATER (CIRCLE APPROPRIATE BOX):
 DOMESTIC, HOME (SINGLE OR DOUBLE HOUSEHOLD USE ONLY)
 FARMING, AGRICULTURE, IRRIGATION
 INDUSTRIAL, COMMERCIAL, STATE AND FEDERAL GOVERNMENT
 MUNICIPAL WATER SUPPLY
 PRIVATE WATER COMPANY
 TEST

APPROXIMATE DEPTH OF WELL: 136 FEET
 APPROXIMATE DIAMETER OF WELL: 6 INCHES

DRIVE (CIRCLE APPROPRIATE BOX):
 AIR PERCUSSION
 ROTARY (HYDRAULIC ROTARY)
 DRIVE-POINT

REPLACEMENT OR DEEPENED WELLS (CIRCLE APPROPRIATE BOX):
 THIS WELL WILL NOT REPLACE AN EXISTING WELL
 THIS WELL WILL REPLACE A WELL THAT WILL BE ABANDONED AND SEALED
 THIS WELL WILL REPLACE A WELL THAT WILL BE USED AS A STANDBY
 THIS WELL WILL DEEPEN AN EXISTING WELL


NOT TO BE FILLED IN BY DRILLER (DWR USE ONLY)
 APPROPRIATION PERMIT NUMBER: [] [] [] [] [] [] [] [] [] [] [] [] [] [] [] []
 ENGINEER REVIEW DISTRICT NO.: [] [] [] [] [] [] [] [] [] [] [] [] [] [] [] []
 CONDITIONS: [] [] [] [] [] [] [] [] [] [] [] [] [] [] [] []

B 4 HEALTH DEPARTMENT APPROVAL
 COUNTY NAME: HOWARD
 COUNTY NO.: 2683
 DATE: 611071
 APPROVED BY: Palmer F. King, Director

B 3 LOCATION OF WELL
 COUNTY: Howard
 SUBDIVISION: Watnetfield Prop
 NEAREST TOWN: Florence
 MILES FROM TOWN (ENTER 0 IF IN TOWN): 2

B 4 DIRECTION FROM TOWN
 NORTH, EAST, SOUTH, WEST, NE, SE, SW, NW
 BEAR WHAT: South Chible
 ON WHICH SIDE OF ROAD (CIRCLE APPROPRIATE BOX): N
 DISTANCE FROM ROAD (ENTER DISTANCE AND CIRCLE APPROPRIATE BOX): 150

DRAW A SKETCH BELOW SHOWING LOCATION OF WELL IN RELATION TO NEARBY TOWNS, ROADS AND STREAMS WITH NORTH IN THE DIRECTION OF THE ARROW, AND GIVE DISTANCE FROM WELL TO NEAREST ROAD JUNCTION OR STREAM CROSSING SHOWN ON THE SKETCH. ALSO SHOW, BY MEANS OF AN 'X', THE WELL LOCATION IN THE BOX BELOW, AND THE BOX NUMBER FROM THE WELL LOCATION MAP.

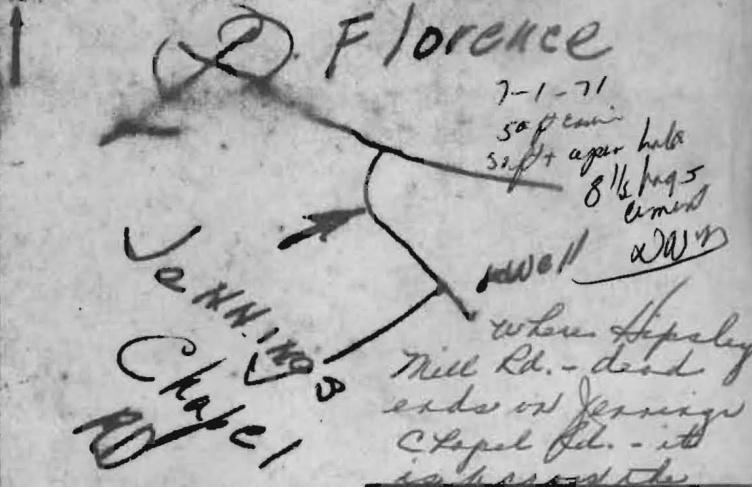


BOX NUMBER E: 770
 BOX NUMBER N: 520
 NORTH COORDINATE: [] [] [] [] [] [] [] [] [] [] [] [] [] [] [] []
 EAST COORDINATE: [] [] [] [] [] [] [] [] [] [] [] [] [] [] [] []
 ELEVATION AT WELL HEAD (FEET): [] [] [] [] [] [] [] [] [] [] [] [] [] [] [] []

B 8 SPECIAL CONDITIONS (DWR USE ONLY)
 [] [] [] [] [] [] [] [] [] [] [] [] [] [] [] []

A10929

Click here for a plain text ADA compliant screen.

	Maryland Department of Assessments and Taxation HOWARD COUNTY Real Property Data Search	Go Back View Map New Search
---	--	---

Account Identifier: District - 04 Account Number - 308891

Owner Information

Owner Name:	ATWELL HERBERT C & WF	Use:	RESIDENTIAL
		Principal Residence:	YES
Mailing Address:	3245 JENNINGS CHAPEL RD WOODBINE MD 21797-7513	Deed Reference:	1) / 443/ 629 2)

Location & Structure Information

Premises Address	Zoning	Legal Description
3245 JENNINGS CHAPEL RD WOODBINE 21797	RCDEO	5.006 A LOT 4 3245 JENNINGS CHAPEL RD ROB JOHNSEN SUB

Map	Grid	Parcel	Sub District	Subdivision	Section	Block	Lot	Group	Plat No:
13	22	111					4	81	Plat Ref:

Special Tax Areas	Town Ad Valorem Tax Class	NO A/V, NO M/P, RURAL FIRE TAX
--------------------------	----------------------------------	--------------------------------

Primary Structure Built	Enclosed Area	Property Land Area	County Use
1973	2,322 SF	5.00 AC	

Stories	Basement	Type	Exterior
1 1/2	YES	STANDARD UNIT	BRICK

Value Information

	Base Value	Value As Of	Phase-in Assessments	
			As Of	As Of
Land:	115,000	01/01/2002	07/01/2002	07/01/2003
Improvements:	209,500	135,000		
Total:	324,500	241,900	341,966	359,432
Preferential Land:	0	0	0	0

Transfer Information

Seller:	Date:	Price:
Type:	Deed1:	Deed2:
Seller:	Date:	Price:
Type:	Deed1:	Deed2:
Seller:	Date:	Price:
Type:	Deed1:	Deed2:

Exemption Information

Partial Exempt Assessments	Class	07/01/2002	07/01/2003
County	000	0	0
State	000	0	0
Municipal	000	0	0

Tax Exempt: NO **Special Tax Recapture:**
Exempt Class: * NONE *