

Fill out in triplicate.
With \$15.00 check payable to:
Howard County Health Dept. - Sanitation

APPLICATION

SEWAGE DISPOSAL TESTING

Robert C. Atwell

A 10929

P _____

MARYLAND STATE DEPARTMENT OF HEALTH

HOWARD COUNTY

ELLICOTT CITY

DISTRICT 4th

DATE 9-16-1965

*Septic tank - 1000 gal.
Dry Well - 12 ft diameter (20 ft out lip and 12 ft for fill and rest of pit covered gravel)
12 ft and has 2 ft of absorbent area (dry well) and 6 ft deep below inlet pipe.
or 2 dry wells at 20 ft 22 ft height of absorbent area each.
Place Dry Well 26.5 ft from front lot line and 139 ft from left sideline as seen when facing lot from Jennings Chapel Road. Max depth permitted for dry wells is 12 ft below orig. grade if water is encountered call this department.*

TO: THE COUNTY HEALTH OFFICER
ELLICOTT CITY, MARYLAND

I, HEREBY, APPLY FOR THE NECESSARY TESTS IN ORDER TO CONSTRUCT (OR RECONSTRUCT) A SEWAGE DISPOSAL SYSTEM.

✓ PROPERTY OWNER Robert Johnson

✓ ADDRESS Brinklow, Md. PHONE 774-9100

PROPERTY LOCATION:

SUBDIVISION _____ LOT NO. H

✓ ROAD AND DESCRIPTION 5.006 acres on Jennings Chapel Road near Intersection of Hipsley Mill Rd, Lot 304.38 front 630 ft. 550 ft. 480 rear

OCCUPANT _____ PHONE _____

PERSON TO CONSTRUCT SYSTEM _____

ADDRESS _____ PHONE _____

✓ SIZE OF LOT 5.006 acres TYPE BLDG. A NUMBER OF BEDROOMS _____

IF NOT SINGLE RESIDENCE DESCRIBE _____

✓ SIGNATURE OF APPLICANT Robert Johnson

✓ APPROVED BY [Signature] FOR Dry Well DATE 9-13-65


REJECTED BY _____ FOR _____ DATE _____

HOLD PENDING FURTHER TESTS _____ DATE _____

REASONS FOR REJECTION OR HOLDING _____

THIS IS NOT A PERMIT

157
110

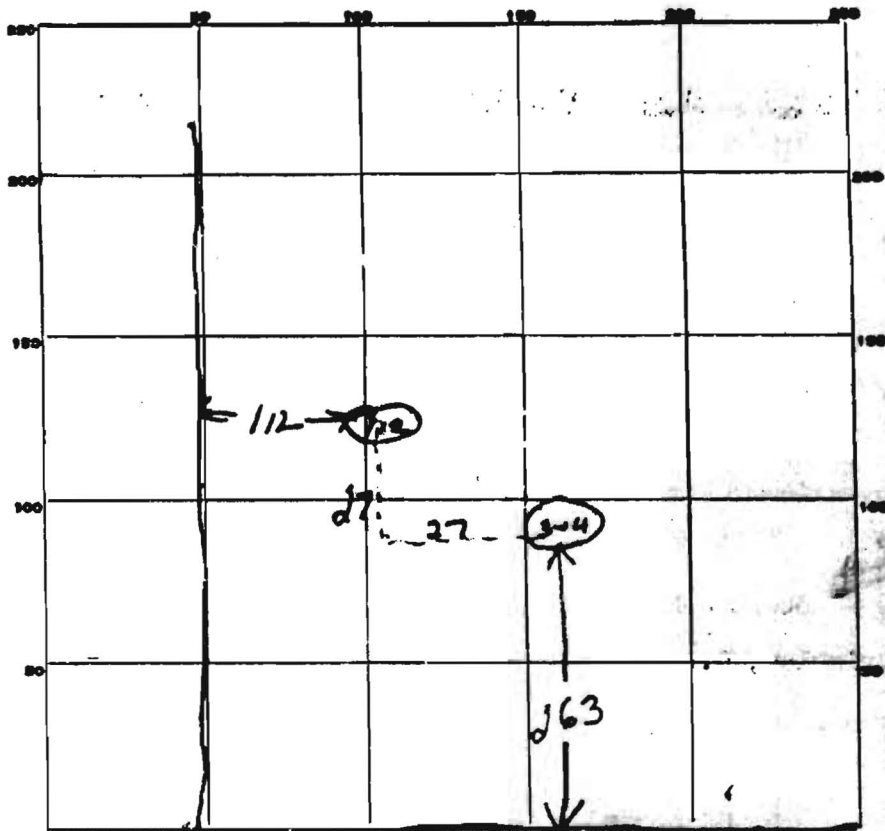

INDICATE NORTH - NAME ADJOINING ROADWAY AS BASE LINE

Jennings Chapel Rd.

DATE	TEST NO.	DEPTH	PRE-WET		TEST - 1" DROP		TIME
			START	STOP	START	STOP	
9/22/68	1	4 1/2 ft	9 26	9 30	9 30	9 32	12 min
	2	5 ft	9 29	9 30	9 30	9 35	5 min
	3	10 ft	9 53	9 52	9 52	10 02	6 min
	4	5 ft	9 55	10 14	10 14	10 47	33 min

SOIL AUGER FINDING first stage clay

TESTED BY SWM, 9/22/68

REMARKS also per 9/23/68 - Robert W. Dahi