


Faramarz & Sandra J. Fergollotti

LIBER 0822 FOLIO 347

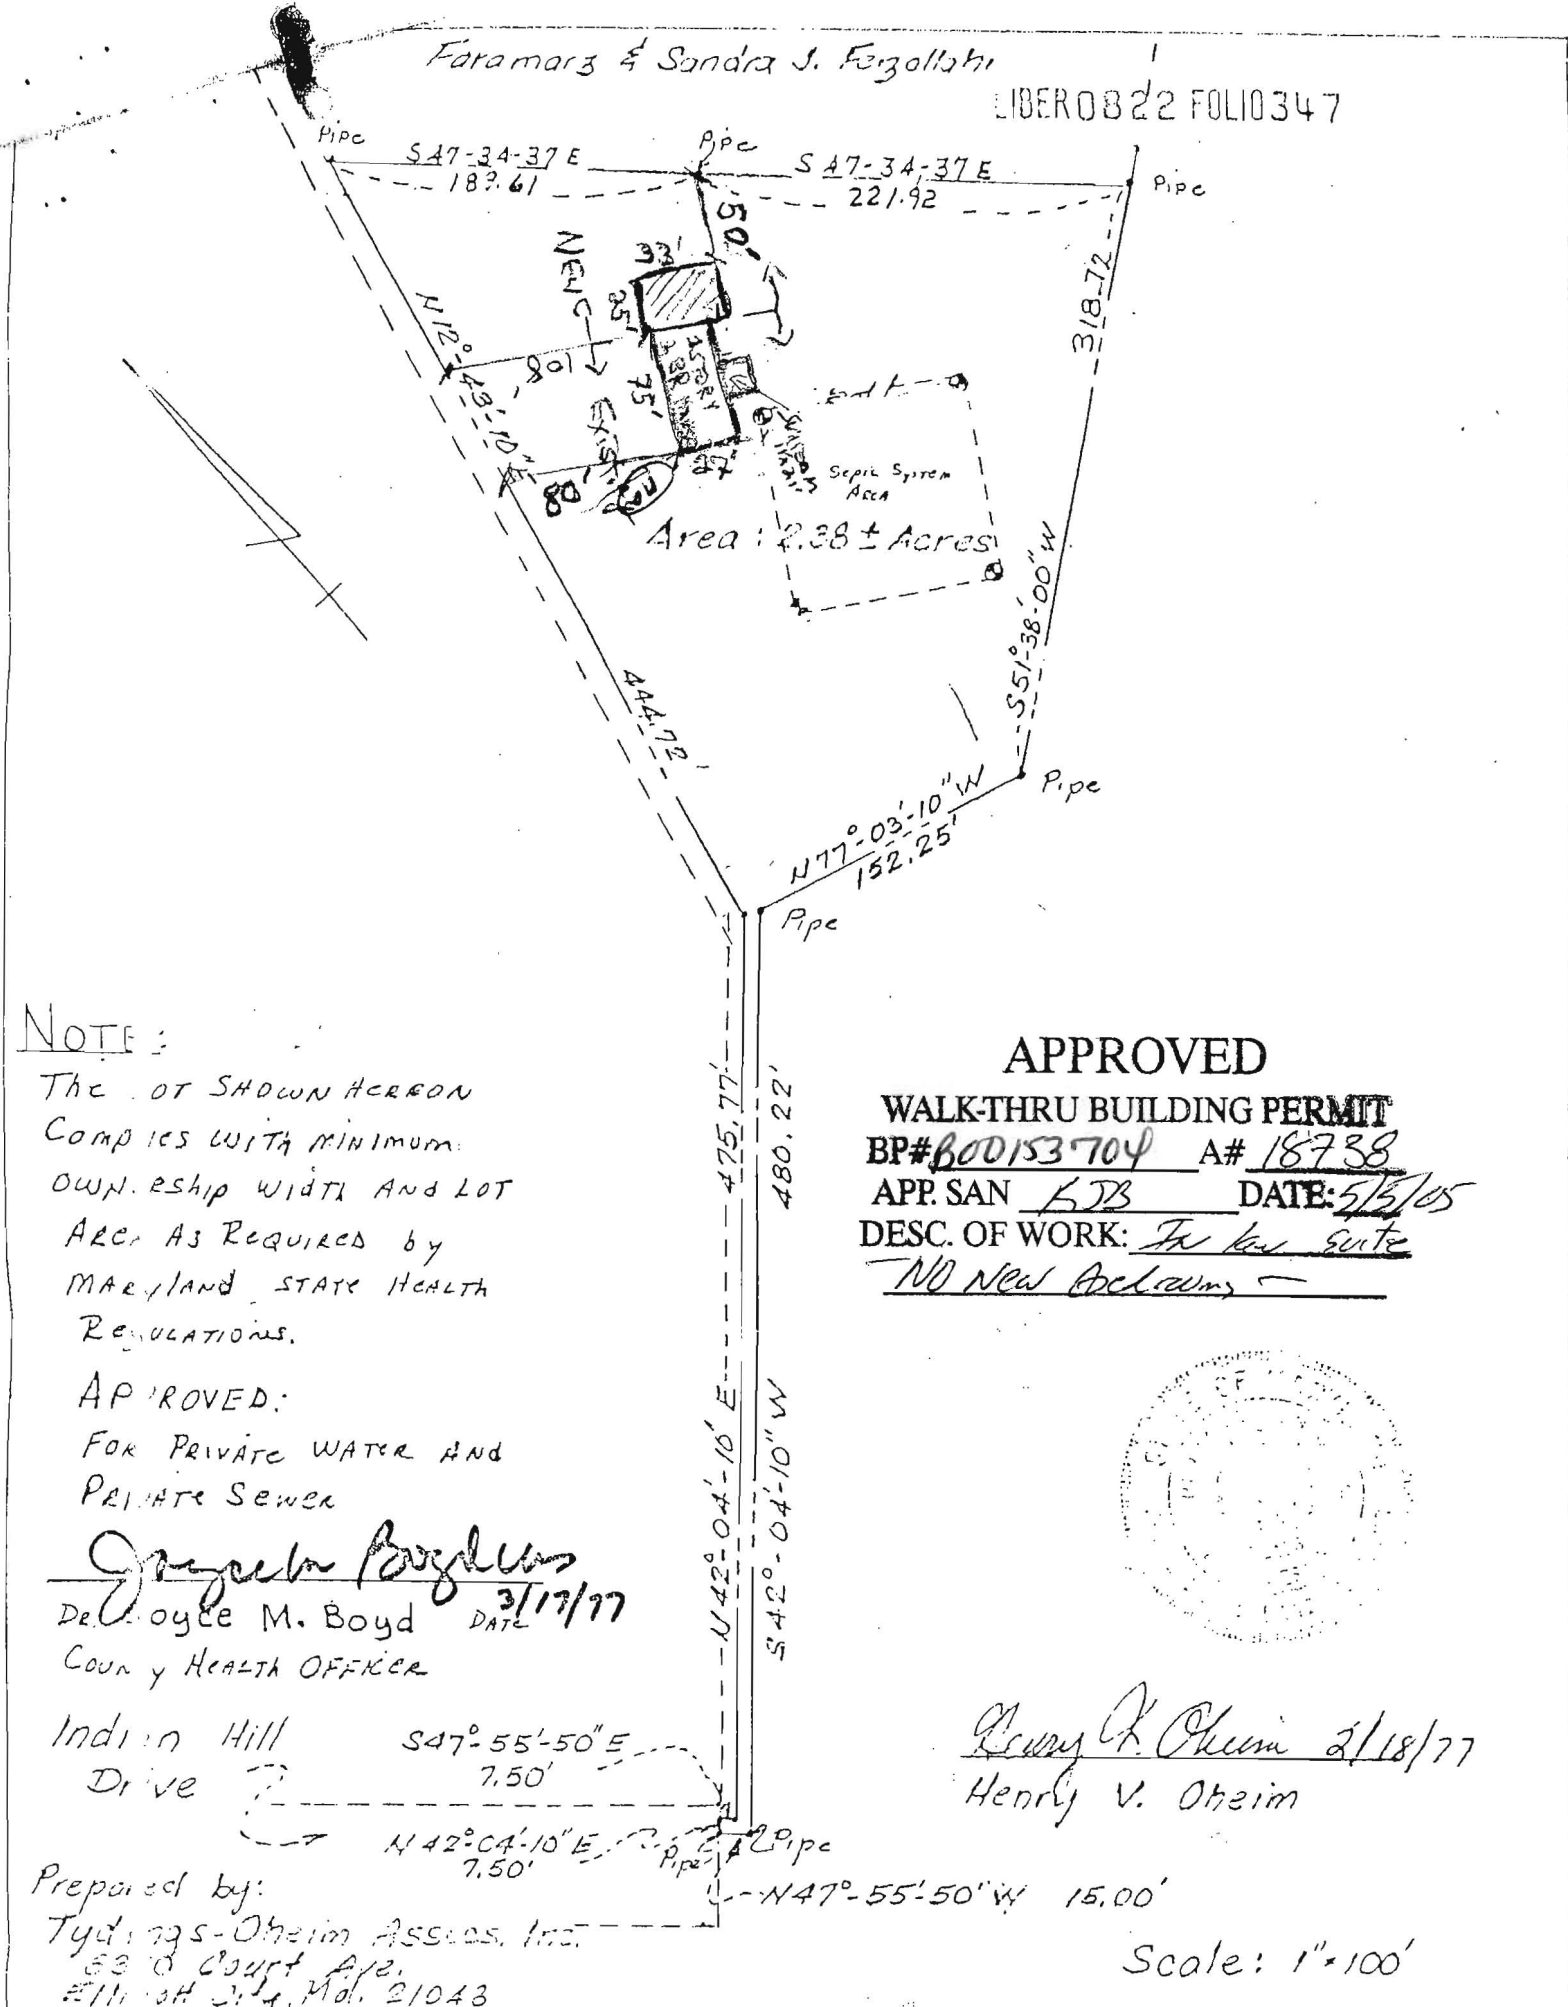

**NOTE:**

The LOT SHOWN HEREON COMPLIES WITH MINIMUM OWNERSHIP WIDTH AND LOT AREA AS REQUIRED BY MARYLAND STATE HEALTH REGULATIONS.

**APPROVED:**

FOR PRIVATE WATER AND PRIVATE SEWER

*Doyce M. Boyd*  
Dr. Doyce M. Boyd DATE 3/17/77  
COUNTY HEALTH OFFICER

Indian Hill Drive

Prepared by:  
Tydings-Oheim Assoc., Inc.  
630 Court Ave.  
Ellicott City, Md. 21043

**APPROVED**

**WALK-THRU BUILDING PERMIT**

BP# 600153704 A# 18738

APP. SAN KJB DATE: 5/5/05

DESC. OF WORK: In law suite

NO New Bedrooms




*Henry V. Oheim*  
Henry V. Oheim 2/18/77

Scale: 1"=100'

Faramarz & Sandra J. Fugallo

LIBER 0822 FOLIO 347

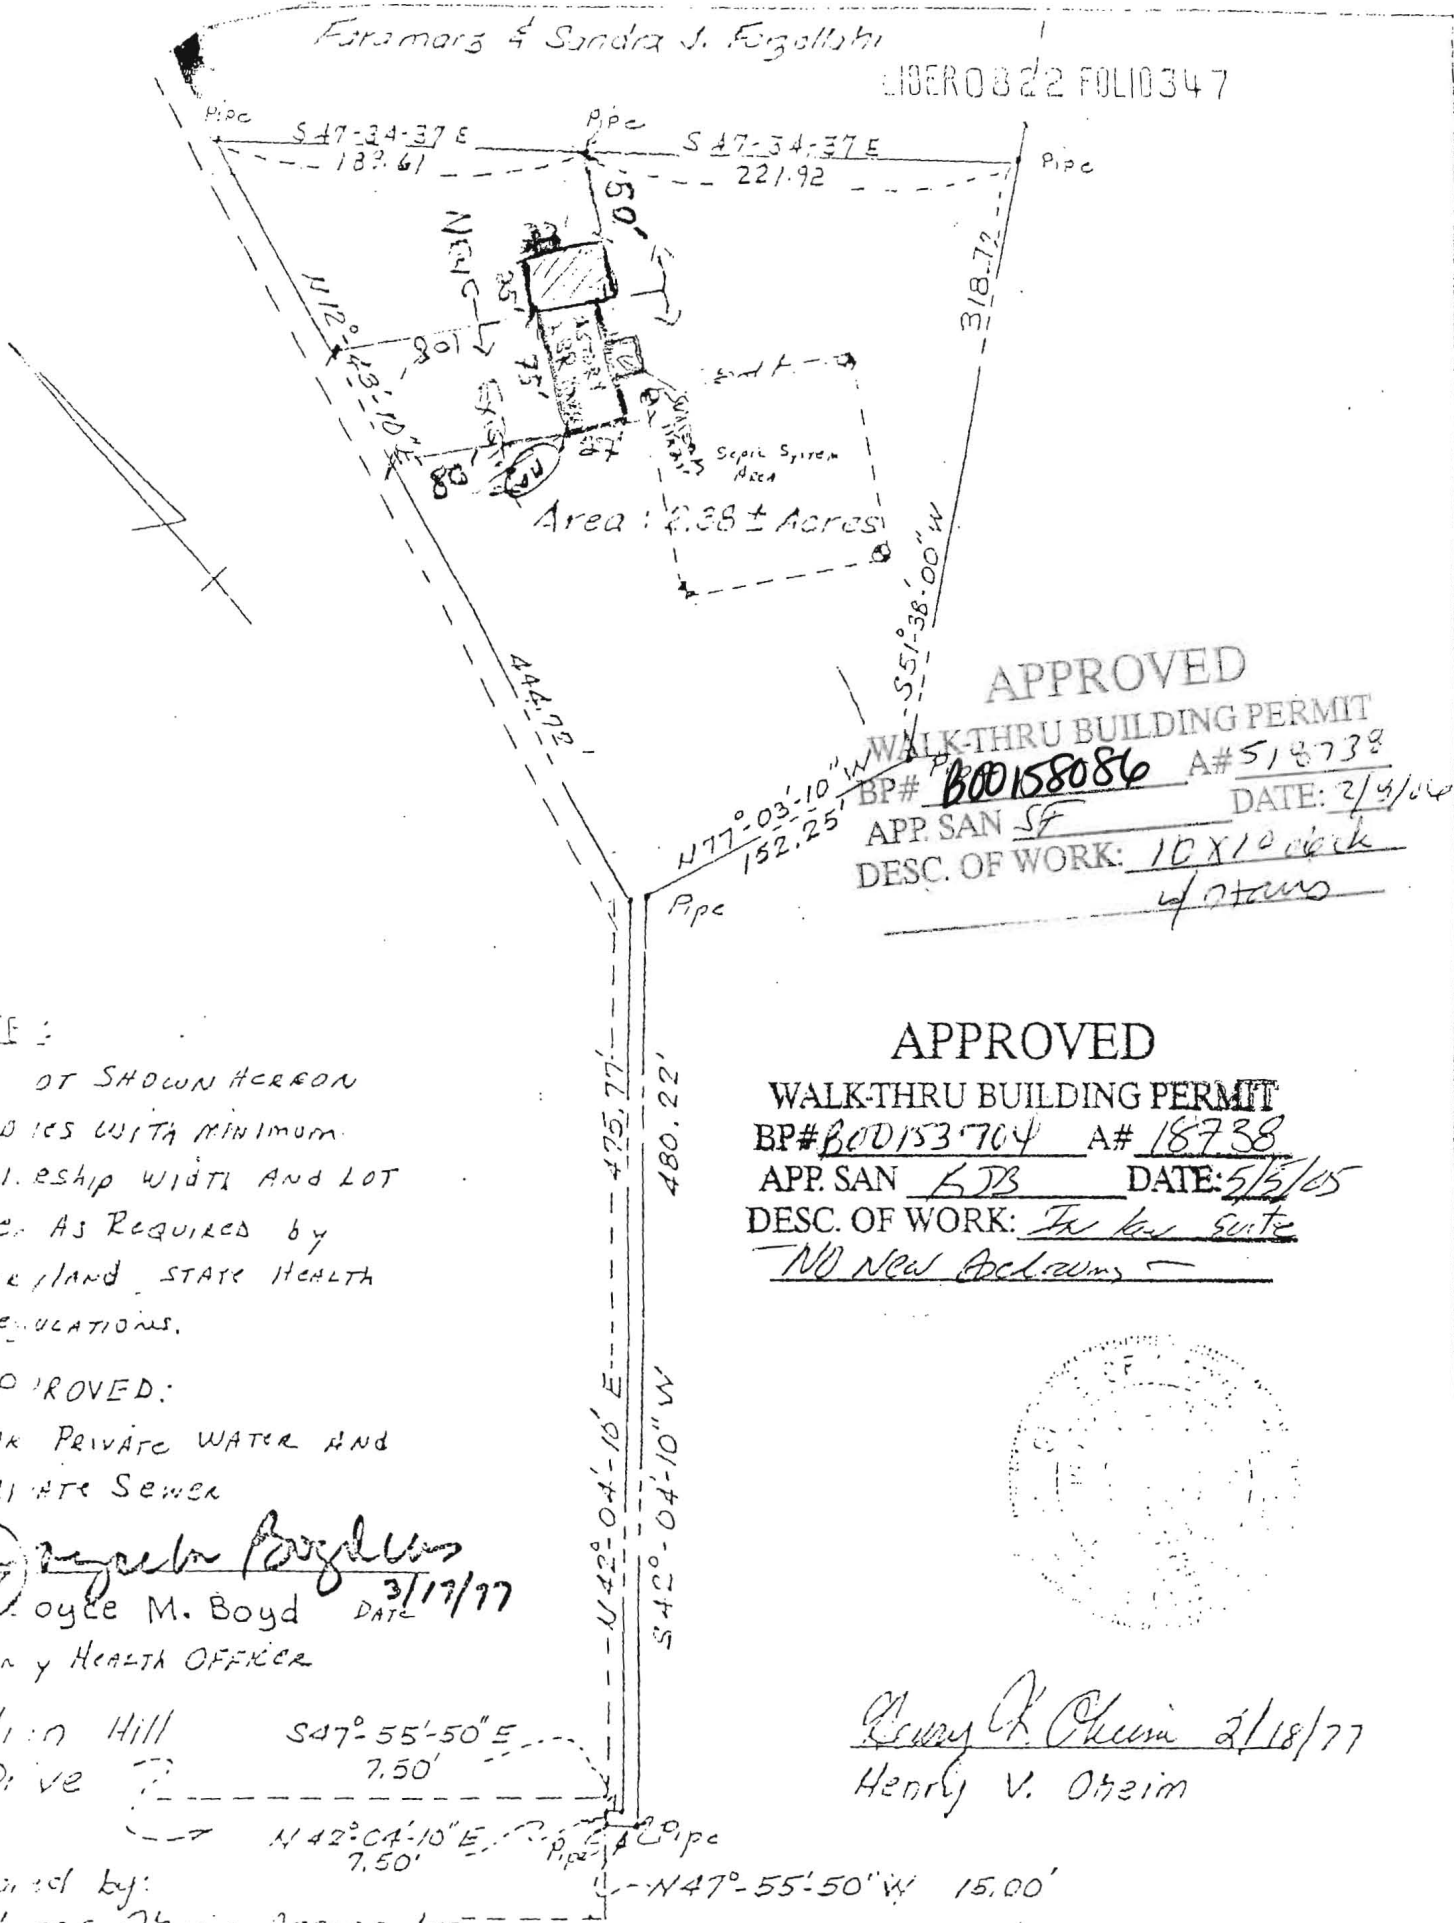

APPROVED

WALK-THRU BUILDING PERMIT

BP# B00158086 A# 518738

APP. SAN SF DATE: 2/4/04

DESC. OF WORK: 10 X 10 deck  
4 stairs


APPROVED

WALK-THRU BUILDING PERMIT

BP# B00153704 A# 18738

APP. SAN KTB DATE: 5/5/05

DESC. OF WORK: In law suite  
NO New Additions

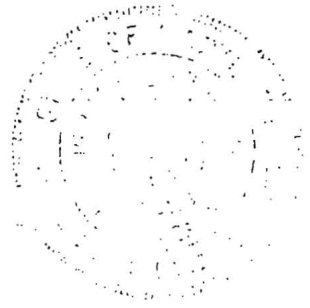

NOTE:

THE LOT SHOWN HEREON COMPLIES WITH MINIMUM OWNERSHIP WIDTH AND LOT AREA AS REQUIRED BY MARYLAND STATE HEALTH REGULATIONS.

APPROVED:

FOR PRIVATE WATER AND PRIVATE SEWER

Gregory Boyd  
Dr. Boyle M. Boyd DATE 3/17/77  
COUNTY HEALTH OFFICER

Indian Hill Drive  
S 47°-55'-50" E 7.50'  
N 42°-04'-10" E 7.50'

Henry V. Oheim 2/18/77  
Henry V. Oheim

prepared by:  
Henry V. Oheim ASSOC. INC.  
530 COURT A/P  
BETHESDA, Md. 21043

Scale: 1" = 100'