

HOWARD COUNTY HEALTH DEPARTMENT
APPLICATION-SEWAGE DISPOSAL PLANNING

Application No. 137

District g

Date 8/9/58

PD0876

TO: THE COUNTY HEALTH OFFICER
Ellicott City, Maryland

I, hereby, apply for the necessary tests in order to construct (or re-construct) a sewage disposal system.

PROPERTY OWNER Tatterie and Lovie Construction Co

Address Simpsonville Phone Atlas 5-3041

LOCATION OF PROPERTY: Subdivision Holiday Hills Lot No. 12

Road Hunting Lane

OCCUPANT OF PROPERTY _____

Address _____ Phone _____

PERSON TO CONSTRUCT PLANT _____

Address _____ Phone _____

SIZE OF LOT 1 acre

TYPE OF BUILDING TO BE SERVED Residence

SYSTEM TO SERVE _____ PEOPLE _____ NO. OF BEDROOMS _____

PERMIT NUMBER _____ FEE _____


SIGNATURE OF APPLICANT [Signature]

APPROVED BY _____ DATE _____

REJECTED BY P.W. DATE 9/16/58

REASONS FOR REJECTION _____

FOR TEST FINDINGS, SEE OTHER SIDE.

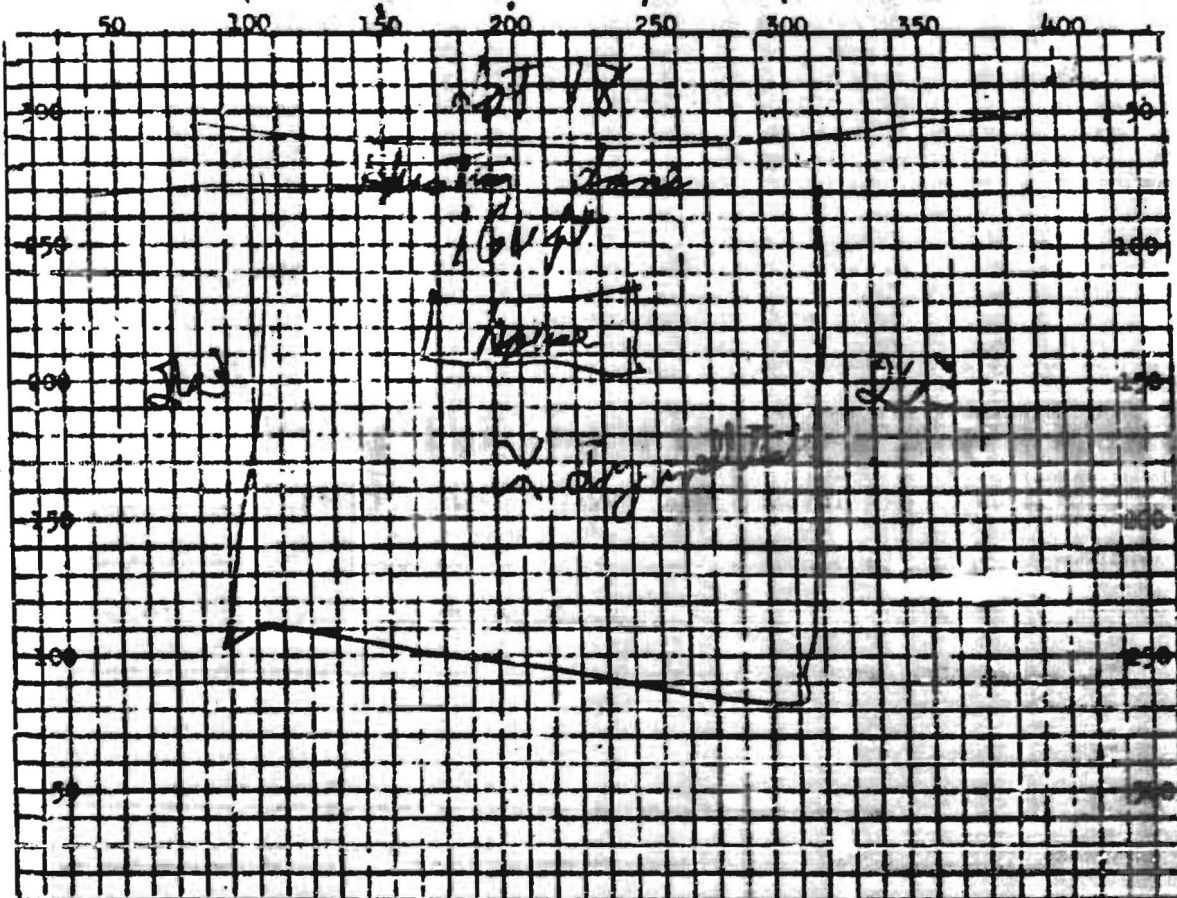

Above: Sketch property showing dimensions, location and numbers of test holes distance to adjoining wells and slope of ground. Each square = 10 ft.

LAST PREVIOUS RAIN _____

RAINFALL FOR YEAR _____

A 157

DATE	TEST NO.	TEST DEPTH	PRE-JET 6"		TOTAL		
			START	STOP	TIME START	TIME STOP	
9/10/58	1	9 ft.	10:41		10:45	11:00	5 min

SOIL NUCLER FINDING: _____

TEST CONDUCTED BY

Palmer F. Wine

DATE

9/10/58

ALSO, PRESENT

G. C. Long

SIGNATURE

REMARKS:

TITLE