

DAMMERZ

rev. to site plan

1"=50'

S52°14'38"E 152.46

S47°12'48"E 183.65

S47°32'47" 25.00

APPROVED

WALK-THRU BUILDING PERMIT  
B# 800149749 A# 519015  
APP SAN KJS DATE: 8/5/09  
DESC. OF WORK: Pool

B.R.L. EQUIP

90' TO HIGHWAY LANE

WATERFALL SPA

Pool

ED WOODS

ED WOODS

5' FENCE / GATES

B.R.L.

INV 474

FT=484.29  
BB=473.50

GAR. 482.3

8 1/2" CONC. PATH

CONC. WALK  
Retention Pools  
owned & maintained by  
owner of Lot 7

EXISTING UTILITY  
28' AS DRAINAGE  
EASEMENT TO LOT 8000


VEGETATED SWALE

LOT 7 AC. ±  
355346 B.R.L.

B.R.L.

S48°06'31"E EX. MACADAM DRIVE 250.00



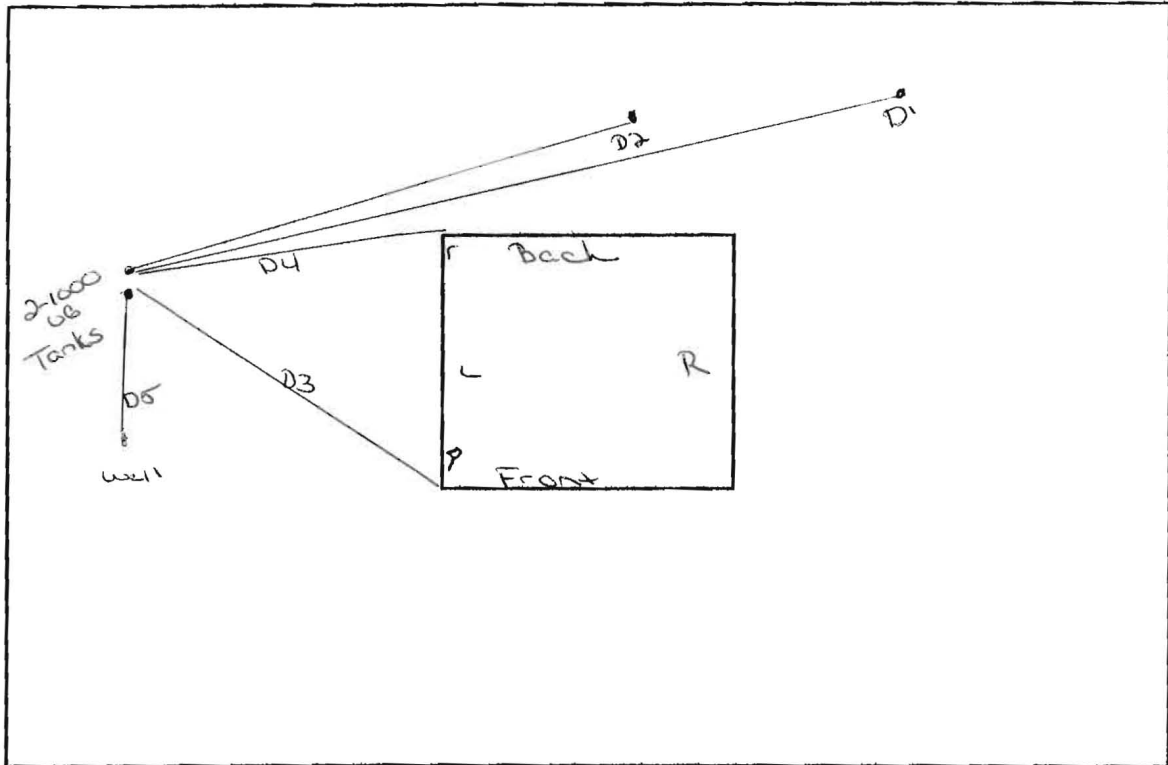

CUSTOMER NAME: Dennis Danner

ADDRESS: 13105 ~~13213~~ Isle of man way / Highland, MD

SCALE: 1" = 50ft

D1 - TANK TO SEPTIC 205

D2 - TANK TO SEPTIC EASEMENT 145

D3 - TANK TO HOUSE- RIGHT 85

D4 - TANK TO HOUSE - LEFT 80



D5 - TANK TO WELL 30

TANK SIZE 1000

TANK DIMENSIONS 18 x 4 each

B00050036  
4/6/05

L.P. tank ok  
(KSB)

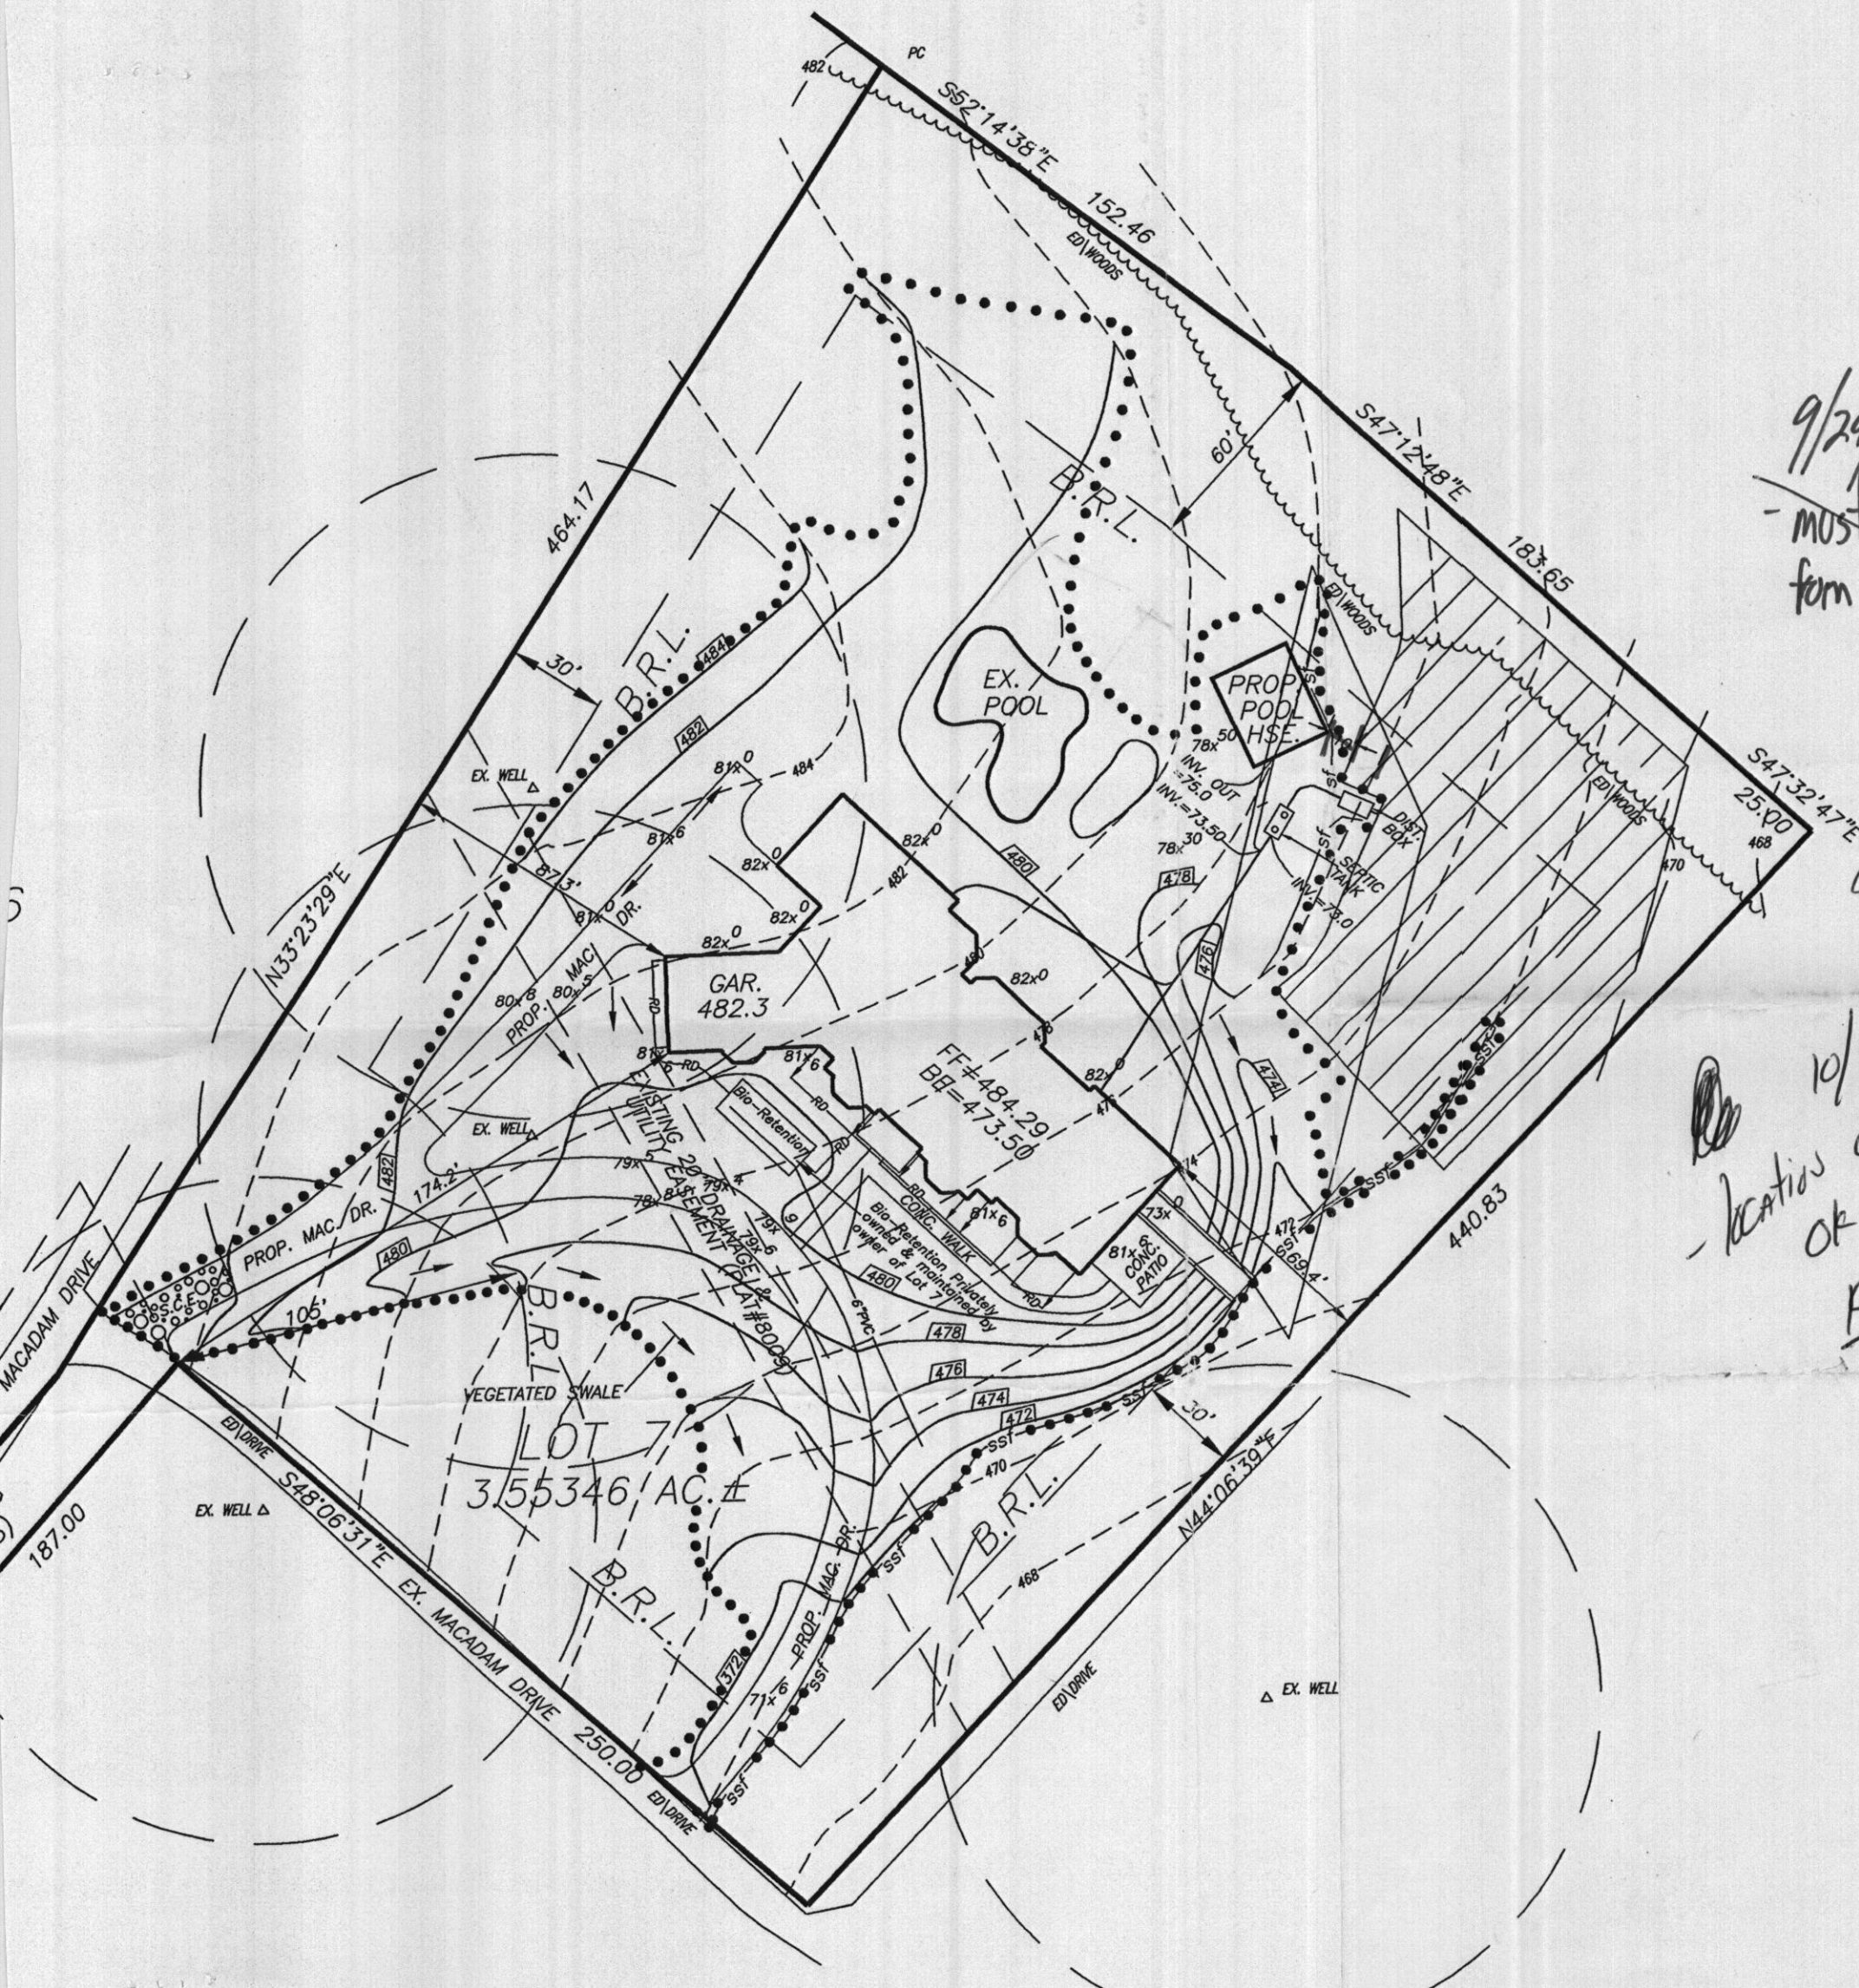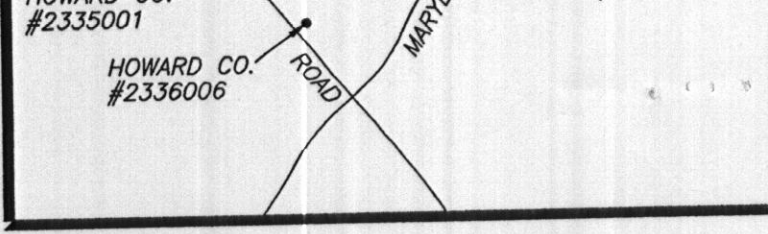

9/29/01  
- must maintain a 20' separation from easement.  
- was told by Donna Pool house was to be built on a foundation.

Reviewed by  
K. Bell

10/1/01  
- location of structure OK.  
BOO150304  
POO - Howard  
KJB / JB

SEPTIC SYSTEM DATA

INV. AT HOUSE	471.00	
SEPTIC TANK		PUMP PIT
EX. GRADE	473.7	474.0
FIN. GRADE	473.7	474.0
INV. IN	470.3	470.0
INV. OUT	470.1	-
DISTRIBUTION BOX		
EX. GRADE	476.2	
FIN. GRADE	476.2	
INV. IN	472.2	
INV. OUT	472.2	

TRENCHES

\* NOTE: TRENCH LENGTH AND ORIENTATION TO BE DETERMINED BY HEALTH DEPARTMENT AT THE TIME OF SEPTIC SYSTEM LAYOUT INSPECTION.  
SEPTIC SYSTEM REQUIRES THE USE OF A PUMP (IN PUMP PIT NEXT TO SEPTIC TANK)