

8/19/74 if possible  
8/20/74 - early as possible

# PERMIT

SEWAGE DISPOSAL SYSTEM  
MARYLAND STATE DEPARTMENT OF HEALTH

HOWARD COUNTY

ELLICOTT CITY  
DISTRICT 12

DATE 8/22/74



*for complete approval*  
852-1-2077

**INDEXED**

Richard Barth IS PERMITTED TO INSTALL X ALTER 2

ADDRESS Clarksville Pike, Ellicott City, Md. PHONE 730-8105

A SEWAGE DISPOSAL SYSTEM LOCATED AT \_\_\_\_\_

SUBDIVISION Riverside Estates ROAD July Lane LOT 11

PROPERTY OWNER Dolores Investments

ADDRESS 17512 Bowie Mill Road, Derwood, Md. Phone: 948-5115

SPECIFICATIONS 4 bedrooms

DRAIN FIELD \_\_\_\_\_ DEPTH \_\_\_\_\_ FEET. BOTTOM AREA \_\_\_\_\_ SQ. FT.

SEEPAGE PITS \_\_\_\_\_ ABSORBENT SIDE-WALL AREA \_\_\_\_\_ SQ. FT.

SEPTIC TANK CAPACITY 1270 GALLONS

FOR GARBAGE GRINDER, INCREASE DISPOSAL AREA 25% & TANK CAPACITY 50%.

**OTHER** DRY WELL - Is to have 100 sq. ft. effective absorbent sidewall area, 10' depth below the first 3 ft. of non-absorbent ground at original grade. Maximum depth of dry well to be 11 ft. Locate dry well 70 ft. from the right side line and 125 ft. from the front lot line as seen when facing lot from July Lane.

**NOTE:** ALL PIPE FROM HOUSE TO DRY WELL MUST BE CAST IRON.  
PERMIT VOID AFTER THREE YEARS.

**NOTE:** INSTALL STAND PIPE ON SEPTIC TANK AND DRY WELL.

PLANS APPROVED BY William W. Zapp DATE 9/17/73

FILL SEPTIC TANK AND DISTRIBUTION BOX WITH WATER BEFORE CALLING FOR AN INSPECTION. COVER NO WORK UNTIL INSPECTED AND APPROVED.

NEITHER THE HOWARD COUNTY COMMISSIONERS NOR THE HEALTH DEPARTMENT IS RESPONSIBLE FOR THE SUCCESSFUL OPERATION OF ANY SYSTEM.

A 18755

PERMIT

SEWAGE DISPOSAL SYSTEM  
MARYLAND STATE DEPARTMENT OF HEALTH

ELLCOTT CITY  
DISTRICT  
DATE




73  
511

20  
17  
18  
18

73

7" 6 1/2"  
4"  
4"  
7

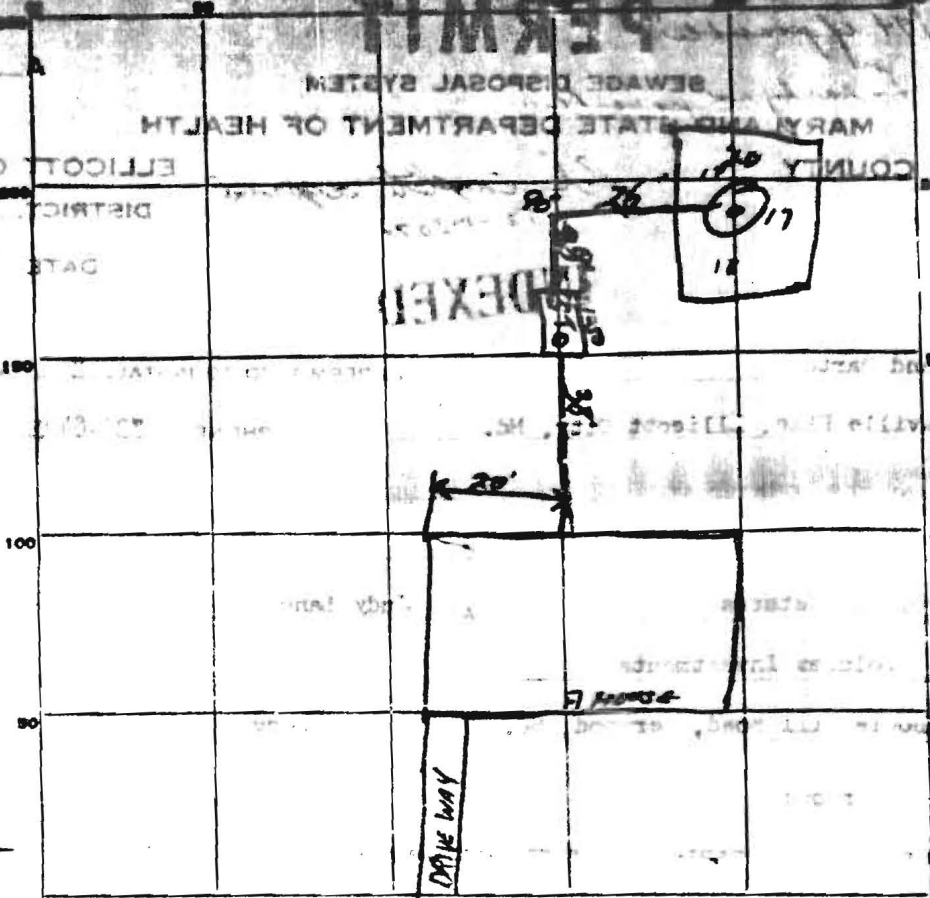

Lot 11

Location OK

INDICATE NORTH. - NAME ADJOINING PROPERTY AS BASE LINE.

*Grady Lane*

PERMIT CARD

SEPTIC TANK, LEVEL OK CLEANOUTS OK

DISTRIBUTION BOX, LEVEL N/A

TILE FIELD, DEPTH N/A FT. TRENCH WIDTH N/A FT.

GRAVEL DEPTH N/A IN. TOTAL LENGTH N/A FT.

NUMBER OF TRENCHES N/A TOTAL BOTTOM AREA N/A

SEEPAGE PITS, OUTSIDE PERIMETER INSIDE DIAMETER 73+ FT. DEPTH BELOW INLET 7' FT.

ABSORBENT AREA 511 F. SQ. FT.

REMARKS Good job - all cut seen - connected to tank.  
Clean out - caps OK

DATE SYSTEM APPROVED 8-20-74 INSPECTOR HS2 + C.B.S

