

PUB. SEWER STATUS VERIFIED BY _____

ISSUE DATE: 7/14/2003

P 519049

APPROVAL DATE: 7/14/03

A REPAIR

PERMIT INDEXED

ON-SITE SEWAGE DISPOSAL SYSTEM HOWARD COUNTY HEALTH DEPARTMENT BUREAU OF ENVIRONMENTAL HEALTH

05-382351

Jenkins Brothers Septic Serv IS PERMITTED TO INSTALL ALTER

ADDRESS: 7670 Smiths Private Rd, 21784 PHONE NUMBER: 410-465-6646

SUBDIVISION: Riverside Estates LOT NUMBER: 20, B1 H

ADDRESS: 10757 Judy Lane PROPERTY OWNER: Charles Thomas

SEPTIC TANK CAPACITY (GALLONS): Ex 1250

PUMP CHAMBER CAPACITY (GALLONS): N/A

NUMBER OF BEDROOMS: 4

SQUARE FEET PER BEDROOM: 180

LINEAR FEET OF TRENCH REQUIRED: 50

TRENCHES:	Trench to be <u>3</u> feet wide. Inlet <u>3.5</u> feet below original grade. Bottom maximum depth <u>9</u> feet below original grade. Effective area begins at <u>3</u> feet below original grade. <u>5.5</u> feet of stone below distribution pipe.
LOCATION:	<u>Run trench on best contour</u> <u>Plumb directly to P.W.</u>
PURPOSE:	Septic system has failed. Call for inspection when the ground is opened so sanitarian can recommend repair.

PLANS APPROVED: [Signature] DATE: 7/14/03

- NOTE: PERMIT VOID AFTER 2 YEARS
- NOTE: CONTRACTOR RESPONSIBLE FOR SCHEDULING A PRE-CONSTRUCTION INSPECTION FOR ALL INSTALLATIONS
- NOTE: WATERTIGHT SEPTIC TANKS REQUIRED
- NOTE: ALL PARTS OF SEPTIC SYSTEM SHALL BE 100 FEET FROM ANY WATER WELL
- NOTE: MANHOLE RISERS REQUIRED ON ALL SEPTIC TANKS AND PUMP CHAMBERS

**NEITHER THE HOWARD COUNTY COUNCIL NOR THE HEALTH DEPARTMENT IS
RESPONSIBLE FOR THE SUCCESSFUL OPERATION OF ANY SYSTEM
PERMITTEE RESPONSIBLE FOR OBTAINING FINAL APPROVAL ON THIS PERMIT
CALL 410-313-2640 FOR INSPECTION OF SEPTIC SYSTEM**

P519049

NOT TO SCALE

See Prev Sheet

ROAD

TRENCH/DRAINFIELD DATA		
WIDTH	INLET	BOTTOM
_____	_____	_____
NUMBER OF TRENCHES _____		
TOTAL LENGTH _____		
ABSORPTION AREA _____		
DISTRIBUTION BOX LEVEL _____		
DISTRIBUTION BOX BAFFLE _____		
DISTRIBUTION BOX PORT _____		

SEPTIC TANK DATA	
SEPTIC TANK 1 LEVEL _____	
CAPACITY _____	GAL
SEAM LOC _____	
TANK LID DEPTH _____	
BAFFLES _____	
BAFFLE FILTER _____	
MANHOLE LOC _____	
6" PORT LOC _____	
WATERTIGHT TEST _____	
SEPTIC TANK 2 LEVEL _____	
CAPACITY _____	GAL
SEAM LOC _____	
TANK LID DEPTH _____	
BAFFLES _____	
BAFFLE FILTER _____	
MANHOLE LOC _____	
6" PORT LOC _____	
WATERTIGHT TEST _____	

PRE-CONSTRUCTION _____

INSTALLATION 7/14/03 *OK to cover all work*

FINAL INSPECTOR *[Signature]* DATE OF APPROVAL 7/14/03

SITE INSPECTION SHEET

OWNER: Charles Thomas PHONE #: _____


ADDRESS: 10757 Judy Lane CONTRACTOR: _____

_____ WELL TAG #: _____

SUBDIVISION: _____ LOT: _____ COUNTY #: _____

PROPOSAL: Verify distance of septic tank to house and distance of existing deck to septic tank.

LOCATION DIAGRAM

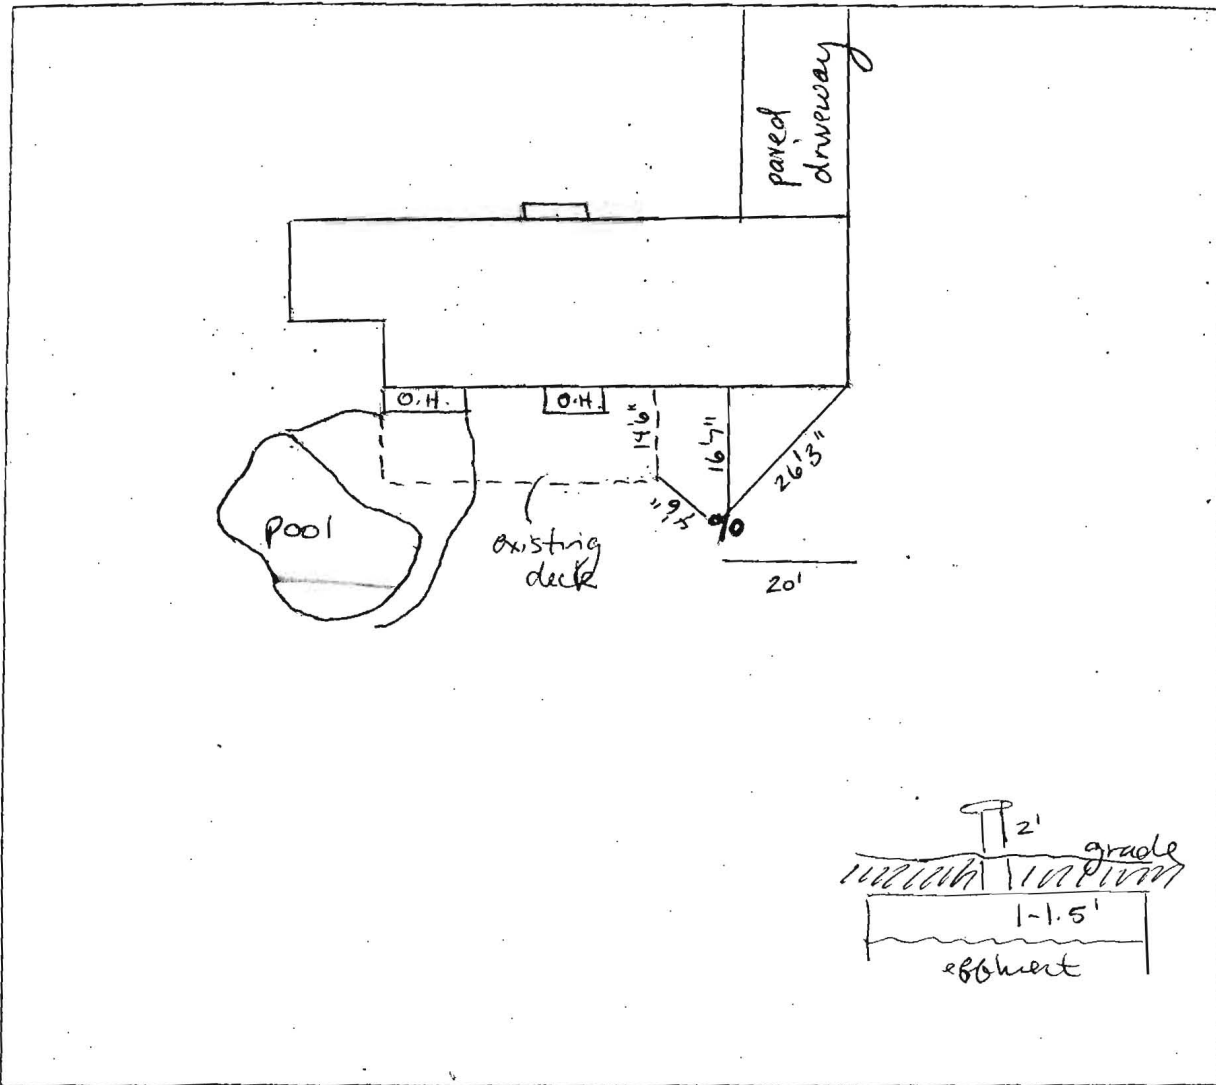

COMMENTS: Septic tank is located 16'7" from house and 4'6" from existing deck. Tank effluent levels appeared satisfactory. They were ~ 1'-1.5' below top of tank.

DATE: 9/26/05

INSPECTOR: SF