

approved 10/29/79
J. Stayer
P 30291

10/29/79
a.m. please

PERMIT

SEWAGE DISPOSAL SYSTEM

MARYLAND STATE DEPARTMENT OF HEALTH*

HOWARD COUNTY

ELLICOTT CITY

DISTRICT 5th

DATE 10/24/79

INDEXED

Bob Orndorff

IS PERMITTED TO INSTALL ALTER

ADDRESS _____

PHONE _____

SUBDIVISION Riverside Estates

ROAD 10757 Judy Lane

LOT 20, Blk.H

PROPERTY OWNER Stanley Halle

Charles Thomas

ADDRESS _____

SPECIFICATIONS 4 bedrooms

SEPTIC TANK CAPACITY 1250 GALLONS

DRAIN FIELD _____ DEPTH _____ FEET, BOTTOM AREA _____ SQ. FT.

DEEP TRENCH _____ DEPTH _____ FEET, BOTTOM AREA _____ SQ. FT.

SEEPAGE PITS ABSORBENT SIDE-WALL AREA 150 SQ. FT. per bedroom in system.

INLET PIPE 3 FT. BELOW ORIGINAL GRADE. MAXIMUM DEPTH 10 FT. BELOW ORIGINAL GRADE

EFFECTIVE DEPTH AT _____ FT. BELOW ORIGINAL GRADE.

LOCATE DISPOSAL AREA _____ FT. FROM _____ LOT LINE AND _____ FT. FROM _____ LOT LINE AS SEEN WHEN

FACING LOT FROM

Invent 3'

Locate the dry well 40 ft. from Johns Court and 140 ft. from Judy Lane. TRENCH-

to be 2 ft. wide, 10 ft. deep, and contain 7 ft. of stone. Begin the trench 5 ft.

from the edge of the dry well and follow the contour of the land.

PLANS APPROVED BY R.T. Moorefield

DATE 7/21/77

COVER NO WORK UNTIL INSPECTED AND APPROVED.

NEITHER THE HOWARD COUNTY COUNCIL NOR THE HEALTH DEPARTMENT IS RESPONSIBLE FOR THE SUCCESSFUL OPERATION OF ANY SYSTEM.

NOTE: IF TRENCH IS USED CALL FOR INSPECTION BEFORE PLACING GRAVEL IN TRENCH.

NOTE: NO DRY WELL SHALL EXCEED 15 FOOT IN DIAMETER.

NOTE: ALL PIPE FROM HOUSE TO DISPOSAL AREA MUST BE CAST IRON.

PERMIT VOID AFTER THREE YEARS.

NOTE: INSTALL STAND PIPE ON SEPTIC TANK AND DRY WELL. STAND PIPES MUST BE 6 INCHES IN DIAMETER. CAST IRON, CONCRETE OR TERRA COTTA ACCEPTED.

***INSTALLER IS RESPONSIBLE FOR OBTAINING FINAL APPROVAL ON THIS PERMIT.**

BLDG. PERMIT SIGNED
AND RETURNED 5/24/82

Serial # 49712
Pool.


BLDG. PERMIT SIGNED
AND RETURNED 11/23/82
Serial # 51760
Rev. Thomas Belmont

A 24483

150
600

60
7
420
210
630

Musselberger Co

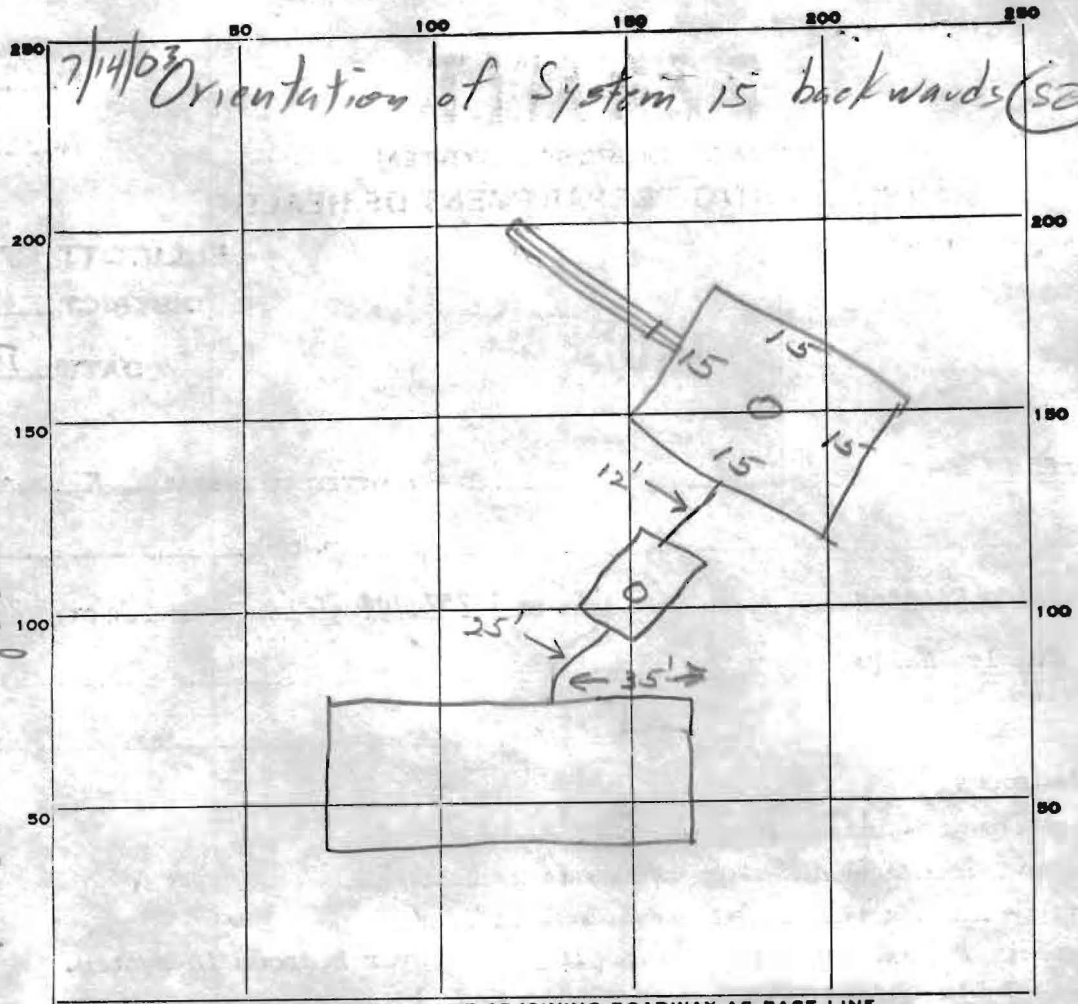

7/14/03 Orientation of System is backwards (SO)

INDICATE NORTH. - NAME ADJOINING ROADWAY AS BASE LINE.

Judy Lane

PERMIT CARD

SEPTIC TANK, LEVEL

CLEANOUTS

ST / DW

terra cotta

DISTRIBUTION BOX, LEVEL

TILE FIELD, DEPTH

10

FT.

TRENCH WIDTH

2

FT.

GRAVEL DEPTH

7

IN.

TOTAL LENGTH

30

FT.

NUMBER OF TRENCHES

1

TOTAL BOTTOM AREA

210

SEEPAGE PITS, INSIDE DIAMETER

60

FT.

DEPTH BELOW INLET

7

FT.

ABSORBENT AREA

630

SQ. FT.

REMARKS

10/29/79 - waited till gravel added to trench. OK to cover all work. J

DATE SYSTEM APPROVED


10/29/79

INSPECTOR

J. Stayer

NOTES

- 1) DIG Δ.
- 2) DIRT
- 3) REMOVE

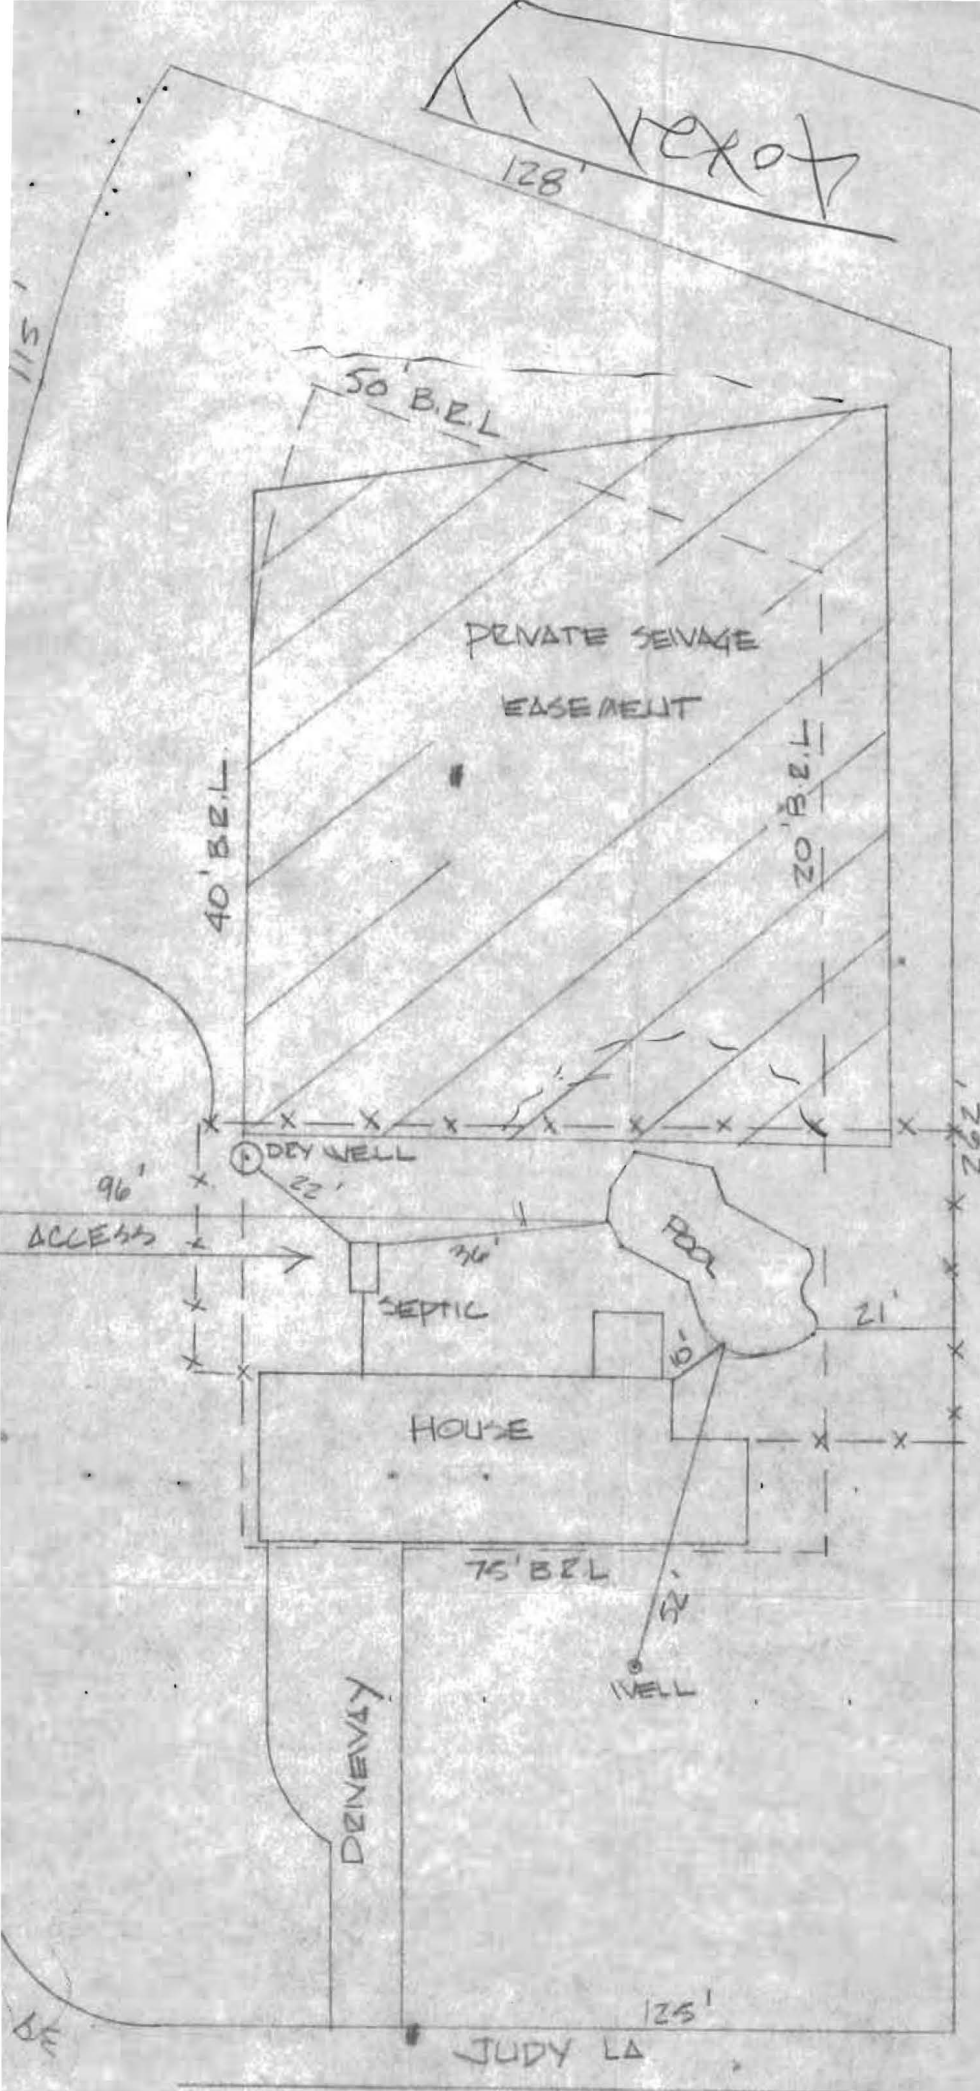

5/26/82
Sketch O.K.
G.S.