

PUB. SEWER STATUS VERIFIED BY _____

ISSUE DATE: _____

APPROVAL DATE: _____

PERMIT
INDEXED

P Re-indexed

A 519063-A

ON-SITE SEWAGE DISPOSAL SYSTEM
HOWARD COUNTY HEALTH DEPARTMENT
BUREAU OF ENVIRONMENTAL HEALTH

04-336968

IS PERMITTED TO INSTALL ALTER

ADDRESS: _____ PHONE NUMBER: _____

SUBDIVISION: Warfield Estates LOT NUMBER: 23

ADDRESS: 14577 MacClintock Drive PROPERTY OWNER: Patrick Kearney

SEPTIC TANK CAPACITY (GALLONS): _____

PUMP CHAMBER CAPACITY (GALLONS): _____

NUMBER OF BEDROOMS: _____

SQUARE FEET PER BEDROOM: _____

LINEAR FEET OF TRENCH REQUIRED: _____

TRENCHES:	Trench to be _____ feet wide. Inlet _____ feet below original grade. Bottom maximum depth _____ feet below original grade. Effective area begins at _____ feet below original grade. _____ feet of stone below distribution pipe.
LOCATION:	
PURPOSE:	File re-indexed

PLANS APPROVED: _____ DATE: _____

- NOTE: PERMIT VOID AFTER 2 YEARS
- NOTE: CONTRACTOR RESPONSIBLE FOR SCHEDULING A PRE-CONSTRUCTION INSPECTION FOR ALL INSTALLATIONS
- NOTE: WATERTIGHT SEPTIC TANKS REQUIRED
- NOTE: ALL PARTS OF SEPTIC SYSTEM SHALL BE 100 FEET FROM ANY WATER WELL
- NOTE: MANHOLE RISERS REQUIRED ON ALL SEPTIC TANKS AND PUMP CHAMBERS

NEITHER THE HOWARD COUNTY COUNCIL NOR THE HEALTH DEPARTMENT IS RESPONSIBLE FOR THE SUCCESSFUL OPERATION OF ANY SYSTEM PERMITTEE RESPONSIBLE FOR OBTAINING FINAL APPROVAL ON THIS PERMIT CALL 410-313-2640 FOR INSPECTION OF SEPTIC SYSTEM

A519063-4

7/20/84
sheet

APPROVED
7/30/84
34/2
R12

PERMIT

SEWAGE DISPOSAL SYSTEM

MARYLAND STATE DEPARTMENT OF HEALTH

A 10119

HOWARD COUNTY
BUREAU OF ENVIRONMENTAL HEALTH
982-2330

ELLCOTT CITY
DISTRICT 4th

INDEXED

DATE 7/19/84

Jack Fuock

IS PERMITTED TO INSTALL ALTER

ADDRESS 13775 Triadelphia Road, Clarks, MD 21737 PHONE 988-9270

SUBDIVISION Infield Estates ROAD 14571 MacClintock Dr. LG: 21-2

PROPERTY OWNER Pat Kearney

ADDRESS 684 Branio Lane
Westminster, Maryland 21157

IF GARBAGE GRINDER IS USED INCREASE SEPTIC TANK CAPACITY BY 60% AND ABSORPTION AREA BY 22%.

GARBAGE GRINDER? YES NO

SEPTIC TANK CAPACITY 1250 GALLONS NUMBER OF BEDROOMS 4

TRENCHES - 270 sq. ft. per bedroom. Trench to be 1 ft wide. Inlet 2 feet below original grade. Bottom maximum depth 1/2 foot below original grade. Effective area begins at 3 feet below original grade with 5 feet of stone below distribution pipe. LOCATION: Start the first trench 2 feet from the front property line and 10 feet from the right side line, as seen when facing the property from MacClintock Drive. Continue to dig the trench on level ground running more or less parallel to MacClintock Drive. Place the second trench down slope of and 10-12 feet away from and parallel to the first trench. NOTE: No trench to exceed 100 feet in length. If more than one trench used, a distribution box is required. Trenches to be installed on level ground. Call for inspection of trench before and after gravel is installed. Provide 6" - 8" diameter cleanout and cap to grade or above on septic tank. If a Garbage disposal is used, increase septic tank capacity by 50% and increase absorbent sidewall area by 22%.

PLANS APPROVED BY Frank Skinner DATE 7/2/84

COVER NO WORK UNTIL INSPECTED AND APPROVED

NEITHER THE HOWARD COUNTY COUNCIL NOR THE HEALTH DEPARTMENT IS RESPONSIBLE FOR THE SUCCESSFUL OPERATION OF ANY SYSTEM.

NOTE IF TRENCH IS USED CALL FOR INSPECTION BEFORE AND AFTER PLACING GRAVEL IN TRENCH

NOTE NO DRY WELL SHALL EXCEED 15 FOOT IN DIAMETER NO ABSORPTION TRENCH TO EXCEED 100 FEET IN LENGTH

NOTE ALL PIPE FROM HOUSE TO SEPTIC TANK MUST BE CAST IRON OR SCHEDULE 40 PVC OR ABS

PERMIT VOID AFTER THREE YEARS

NOTE INSTALL STAND PIPE ON SEPTIC TANK AND DRY WELL. STAND PIPES MUST BE 6 INCHES IN DIAMETER CAST IRON, CONCRETE OR TERRA COTTA OR PVC OR ABS ACCEPTED IF TOP OF SEPTIC TANK IS DEEPER THAN 3 FEET MANHOLE TO GRADE REQUIRED.

BLDG. PERMIT SIGNED AND RETURNED *Helpy*


SEWER PERMIT SIGNED AND RETURNED *Helpy*

*INSTALLER IS RESPONSIBLE FOR OBTAINING FINAL APPROVAL ON THIS PERMIT

CALL 982-2330 FOR INSPECTION OF SEPTIC SYSTEMS. *Call 982-2330 from address*

EH-2-1082

A 10119

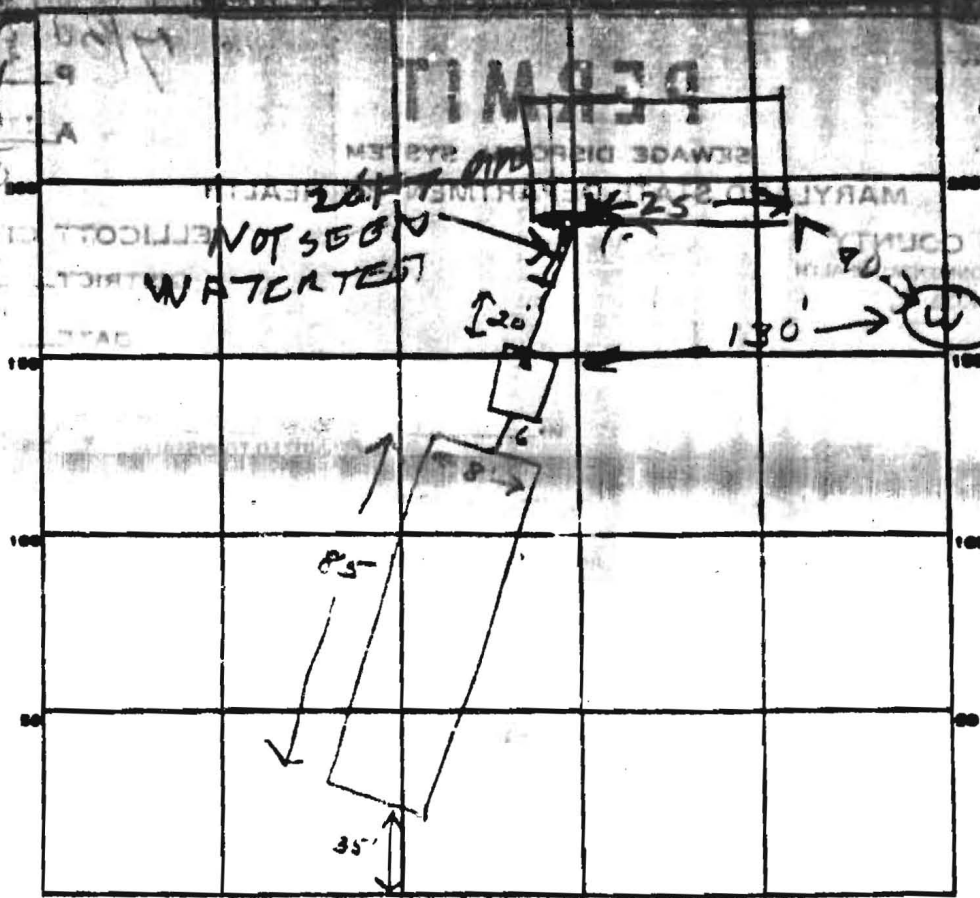


INDICATE NORTH. - NAME ADJOINING ROADWAY AS BACK LINE.
 Mac Clintock Dr.

PERMIT CARD _____
 SEPTIC TANK, LEVEL ✓ 1500 gal CLEANOUTS 5T
 DISTRIBUTION BOX, LEVEL _____
 TILE FIELD, DEPTH 5 FT. TRENCH WIDTH 8 FT.
 GRAVEL DEPTH 2 IN. TOTAL LENGTH 85 FT.
 NUMBER OF TRENCHES 8 x 85 TOTAL BOTTOM AREA 680
 SEEPAGE PITS, INSIDE DIAMETER _____ FT. DEPTH BELOW INLET _____ FT.
 ABSORBENT AREA 680 SQ. FT.

REMARKS 7/20/84 OK to cover all work. Call
when house connection ready for
7/20/85 - HOUSE SEWER NOT SEEN
BUT HOOK UP OK WATER FLUSH
TEST USED

DATE SYSTEM APPROVED 7/30/85 INSPECTOR Raymond Hodge

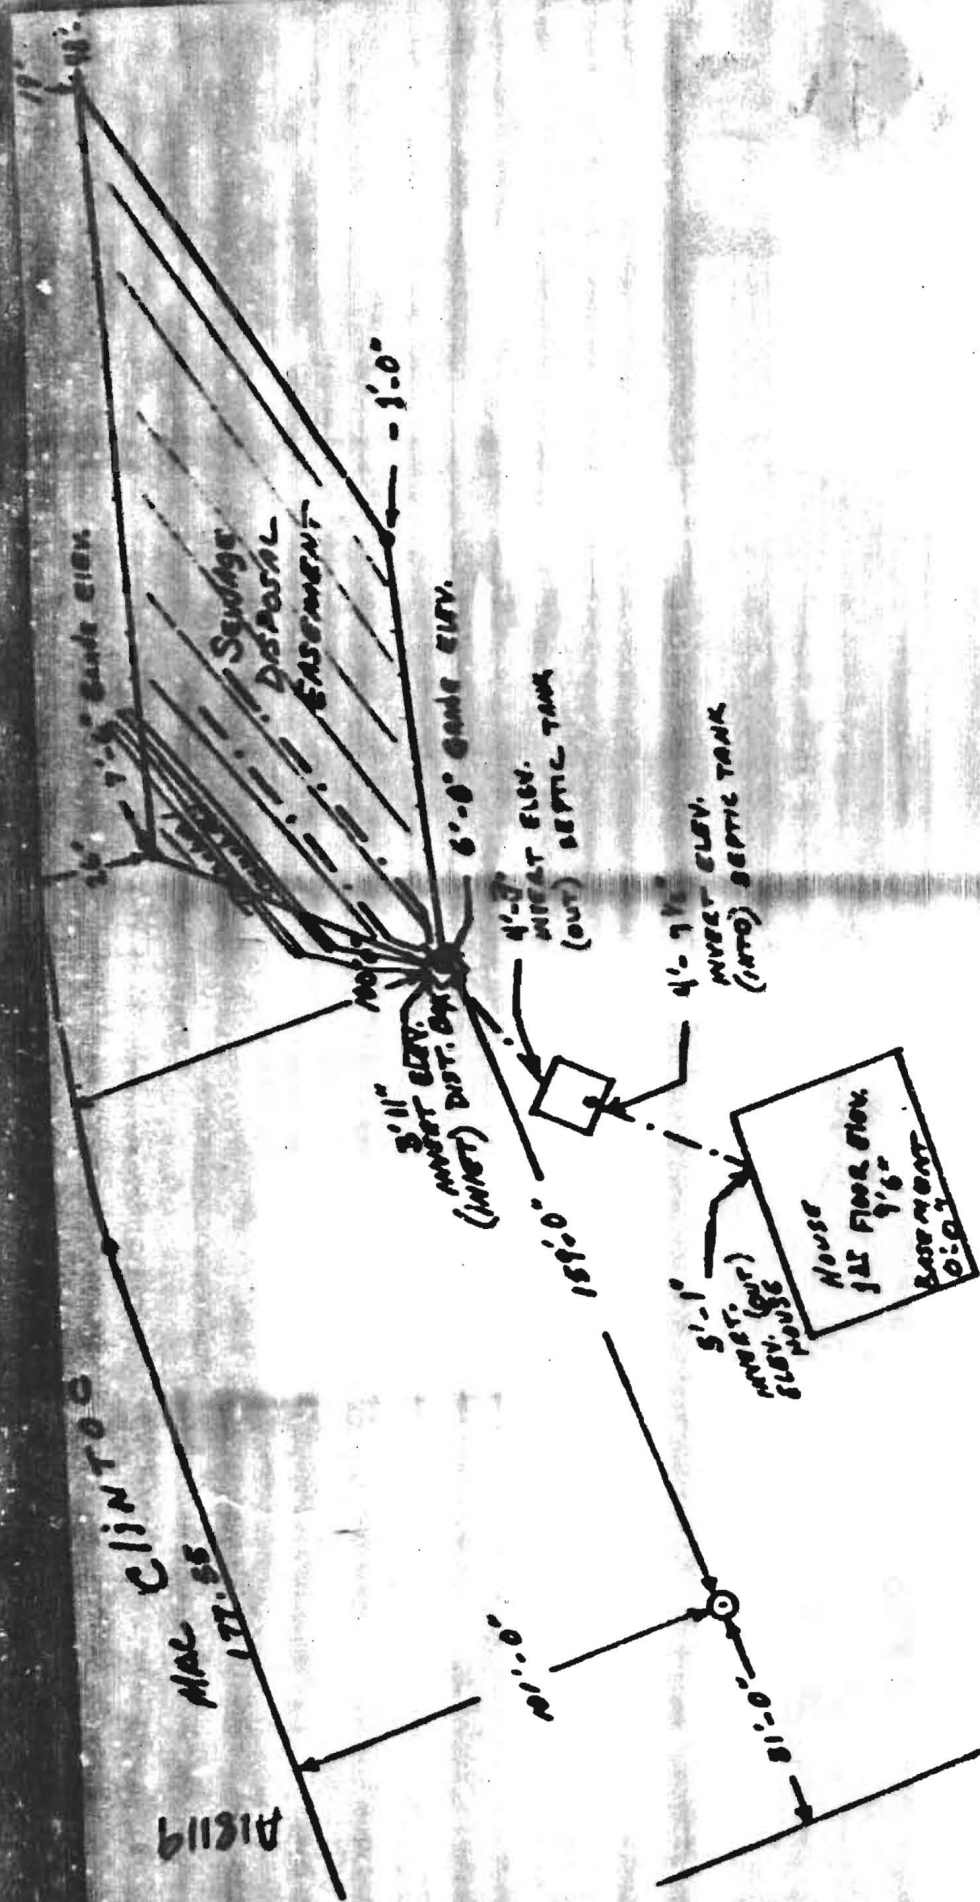

- ① ALL ELEVATIONS ARE MADE FROM BASEMENT FLOOR AS REFERENCE POINT.
- ② HOUSE SHOWN AS AN EXISTING BARN AT PRESENT TIME.

Lot 23 Block B
Warfield Estates

7/16/84
Sketch OK.
Bornerwood

I CERTIFY THE ABOVE MEASUREMENTS AND ELEVATIONS ARE ACTUAL AND CORRECT FOR THIS PROPERTY
Blair Hickey 7/16/84