

APPLICATION

SEWAGE DISPOSAL TESTING

STATE OF MARYLAND - DEPARTMENT OF HEALTH AND MENTAL HYGIENE

HOWARD COUNTY HEALTH DEPARTMENT
ENVIRONMENTAL HEALTH SERVICES
P. O. BOX 676, ELLICOTT CITY, MARYLAND 21040
TELEPHONE: 410-3000, EXT. 300

DISTRICT 4th

DATE 2-22-71

TO: THE COUNTY HEALTH OFFICER
ELLICOTT CITY, MARYLAND

I, HEREBY, APPLY FOR THE NECESSARY TEST IN ORDER TO CONSTRUCT (OR RECONSTRUCT) A SEWAGE DISPOSAL SYSTEM.

PROPERTY OWNER Robert W. Douglas

ADDRESS 9315 Annapolis Rd., Lanham, Md. PHONE 577-0065

PROPERTY LOCATION:

SUBDIVISION Warfield Estates LOT NO. 8-100-7

ROAD AND DESCRIPTION unnamed

SIZE OF LOT 4.6 Acres TYPE BLDG. Single Family Dwelling
NUMBER OF BEDROOMS 3

IF NOT SINGLE RESIDENCE DESCRIBE _____

THE SYSTEM INSTALLED UNDER THIS APPLICATION IS ACCEPTABLE ONLY UNTIL PUBLIC FACILITIES BECOME AVAILABLE.

SIGNATURE OF APPLICANT Robert W. Douglas /s/

APPROVED BY _____ FOR _____ DATE _____
(KIND OF SYSTEM)

REJECTED BY _____ FOR _____ DATE _____
(KIND OF SYSTEM)


HOLD PENDING FURTHER TESTS _____ DATE _____

REASONS FOR REJECTION OR HOLDING _____

THIS IS NOT A PERMIT

APPLICATION

DATE 10-22-73
 DISTRICT 4th

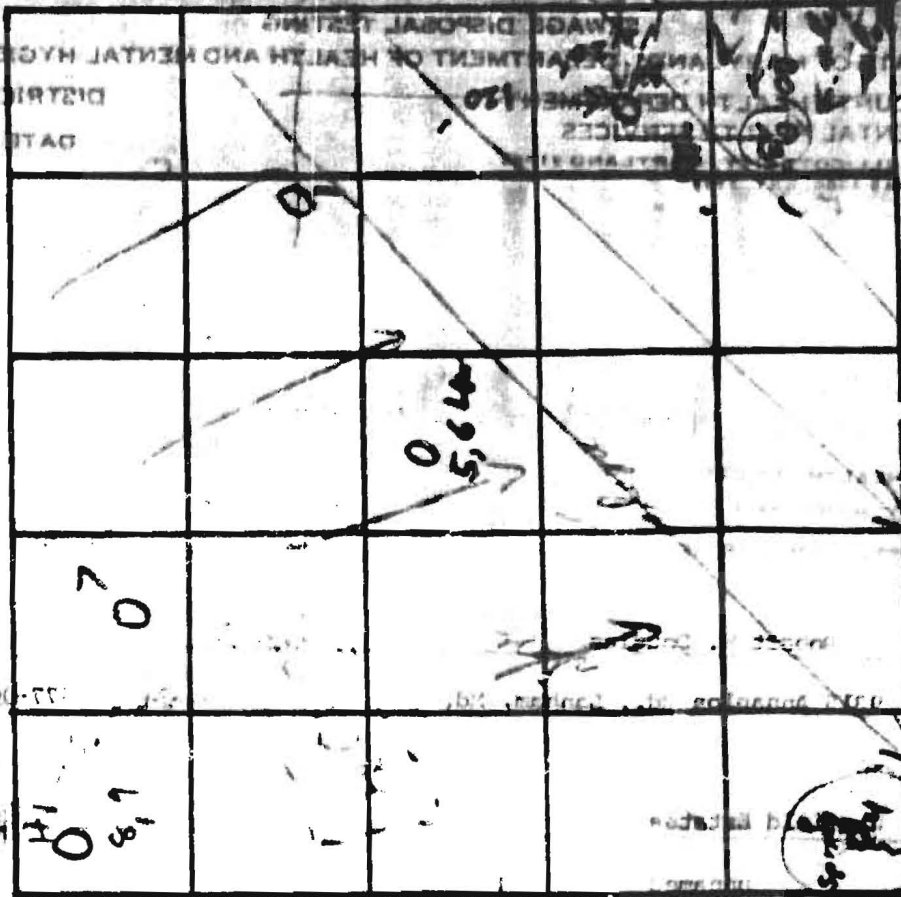

22-B

238 JUN 9

Initial System
 Use test # 8, 9
 Total @ 8'
 of Section 5' to 12'
 @ 4' to 12'

INDICATE NORTH - NAME ADJOINING ROADWAY AS BASE LINE

TEST NO.	DEPTH	PRE-WET		TEST - 1" DROP		TIME
		START	STOP	START	STOP	
10/4 1	11	2:41	2:47	2:47	2:54	7
10/3 (2)	8	Rock				
(3)	10	Water				
(4)	0	Mud				
10/4 5	11	2:52	2:58	2:40	2:43	3
6	3	2:40	2:47	2:47		
7	10	Vis	3rd	6'		
8	12	2:53	2:58	2:58	2:58	2
9	4	2:55	2:58	2:56	2:57	1

$\bar{t} = 4 \text{ min}$
 Recon =
 110' sq/ft

red sand
 level

* Septic
 System to
 be installed
 before Bidg.
 Permit Issue

REMARKS

also use lot # 9, 146 = 1, R 7.
 Not a septic before changing Bidg. Permit.