

Bolo

APPLICATION

A 13315

SEWAGE DISPOSAL TESTING

P _____

MARYLAND STATE DEPARTMENT OF HEALTH

HOWARD COUNTY

System must be installed before permit released. All fees paid in advance.
ELLICOTT CITY

3 YEARS

DISTRICT 1

750 Gal

1000 Gal

DATE 1/5/68

*Dry Well - 338 soft sidewalk
1 area below the first 4 ft. or 9 ft.
with maximum depth
of 9 1/2 ft.*

*Dry Well - 580 soft
sidewalk are the first 4 ft. of
with maximum depth
of 9 1/2 ft.*

Place the dry well 10 ft. & 20 ft. from the dirt

TO: THE COUNTY HEALTH OFFICER,
ELLICOTT CITY, MARYLAND

Road which runs along the front of the

I, HEREBY, APPLY FOR THE NECESSARY TESTS IN ORDER TO CONSTRUCT OR RECONSTRUCT A SEWAGE DISPOSAL SYSTEM.

300 ft. from the intersection

PROPERTY OWNER

*Esther Rettger of the two dirt roads
(Chas. Wehland, Lawyer) which become one dirt*

ADDRESS

PHONE

PROPERTY LOCATION:

road which goes to the school

SUBDIVISION

Poteshon New Requirements

LOT NO.

ROAD AND DESCRIPTION

Ilchester Rd. - go back to school on right hand side -

right-away beside school - 4/10 mile in on dirt road
(Possibly SECURITY REALTY SIGN - 41 acres - still there)
(after Richard Lowe property)

OCCUPANT

PERSON TO CONSTRUCT SYSTEM

*USE LEFT FORK
open - fence - use left fork - 100 yds. in go
until gate & fence type will be able to
PHONE (last name)*

ADDRESS

PHONE

SIZE OF LOT

7.948 acres

TYPE BLDG.

3 or 4

NUMBER OF BEDROOMS

20
(Single Family Dwllg.)

IF NOT SINGLE RESIDENCE DESCRIBE

SIGNATURE OF APPLICANT

Clara S. Stinson H05 1263

APPROVED BY

Raymond Hodges

FOR

Dry Well
(KIND OF SYSTEM)

DATE

5 Jan 1968

REJECTED BY

FOR

(KIND OF SYSTEM)

DATE

HOLD PENDING FURTHER TESTS


J.H. Robinson

DATE

1/11/68

REASONS FOR REJECTION OR HOLDING

THIS IS NOT A PERMIT

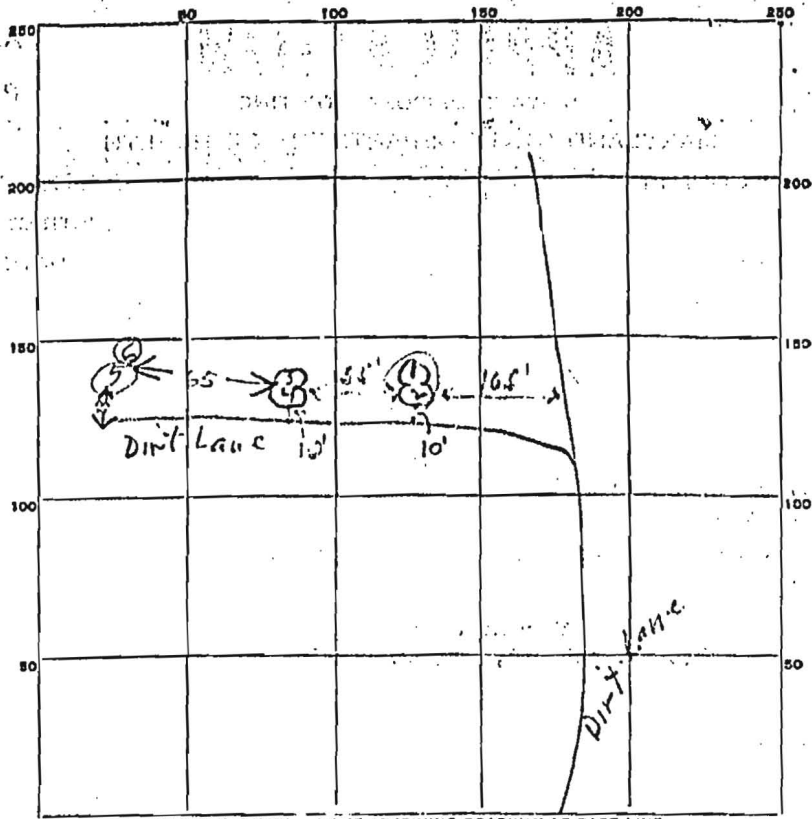

INDICATE NORTH. - NAME ADJOINING ROADWAY AS BASE LINE.

DATE	TEST NO.	DEPTH	PRE-WET		TEST - 1" DROP		TIME
			START	STOP	START	STOP	
11/2/68	(1)	4 1/2'	10:15	10:20	10:30	10:35	1st inch
1	(2)	9'	10:07	10:11	10:11	10:15	1st inch
1	3	4'	10:43	10:59	10:59	11:00	2nd inch
1	4	8'	10:45	10:55	10:55	11:15	20 minutes
11/2/68	5	9 1/2'	1004	1007	1007	1014	7
" "	6	4 1/2'	1014	1021	1021	1034	13

SOIL AUGER FINDING _____

TESTED BY JHK BH

REMARKS 11/2/68 - ground conditions good under JHK