

11/12/03 - 10 AM

2/12/04 - 2 PM

PUB. SEWER STATUS VERIFIED BY _____

ISSUE DATE: 11/10/2003

P 519856

APPROVAL DATE: 2/12/04

A. REPAIR

PERMIT INDEXED

ON-SITE SEWAGE DISPOSAL SYSTEM HOWARD COUNTY HEALTH DEPARTMENT BUREAU OF ENVIRONMENTAL HEALTH

05-358132

Jack Fyock Septic Service IS PERMITTED TO INSTALL ALTER

ADDRESS: PO Box 89, Glenelg, MD 21737 PHONE NUMBER: 410-988-9270

SUBDIVISION: Hopkins Mead LOT NUMBER: 7, Section 1

ADDRESS: 11525 Johns Hopkins Road PROPERTY OWNER: Peter David

SEPTIC TANK CAPACITY (GALLONS): Ex 750

PUMP CHAMBER CAPACITY (GALLONS): N/A

NUMBER OF BEDROOMS: 3

SQUARE FEET PER BEDROOM: 180

LINEAR FEET OF TRENCH REQUIRED: 120

TRENCHES:	Trench to be <u>2</u> feet wide. Inlet <u>6</u> feet below original grade. Bottom maximum depth <u>10</u> feet below original grade. Effective area begins at <u>6</u> feet below original grade. <u>4</u> feet of stone below distribution pipe.
LOCATION:	<u>Use good levelers w/ D.W. all the way up, trenches all the way down</u>
PURPOSE:	Septic system is failing. Call for inspection when the ground has been opened so sanitarian can recommend repair.

PLANS APPROVED: [Signature] DATE: 11/12/03


- NOTE: PERMIT VOID AFTER 2 YEARS
- NOTE: CONTRACTOR RESPONSIBLE FOR SCHEDULING A PRE-CONSTRUCTION INSPECTION FOR ALL INSTALLATIONS
- NOTE: WATERTIGHT SEPTIC TANKS REQUIRED
- NOTE: ALL PARTS OF SEPTIC SYSTEM SHALL BE 100 FEET FROM ANY WATER WELL
- NOTE: MANHOLE RISERS REQUIRED ON ALL SEPTIC TANKS AND PUMP CHAMBERS

NEITHER THE HOWARD COUNTY COUNCIL NOR THE HEALTH DEPARTMENT IS RESPONSIBLE FOR THE SUCCESSFUL OPERATION OF ANY SYSTEM PERMITTEE RESPONSIBLE FOR OBTAINING FINAL APPROVAL ON THIS PERMIT BUILDING PERMIT **SIGNED** 13-2640 FOR INSPECTION OF SEPTIC SYSTEM

AND RETURNED
3-23-05 800 152731 - ONE STEP ADDITION

P 519 656

NOT TO SCALE

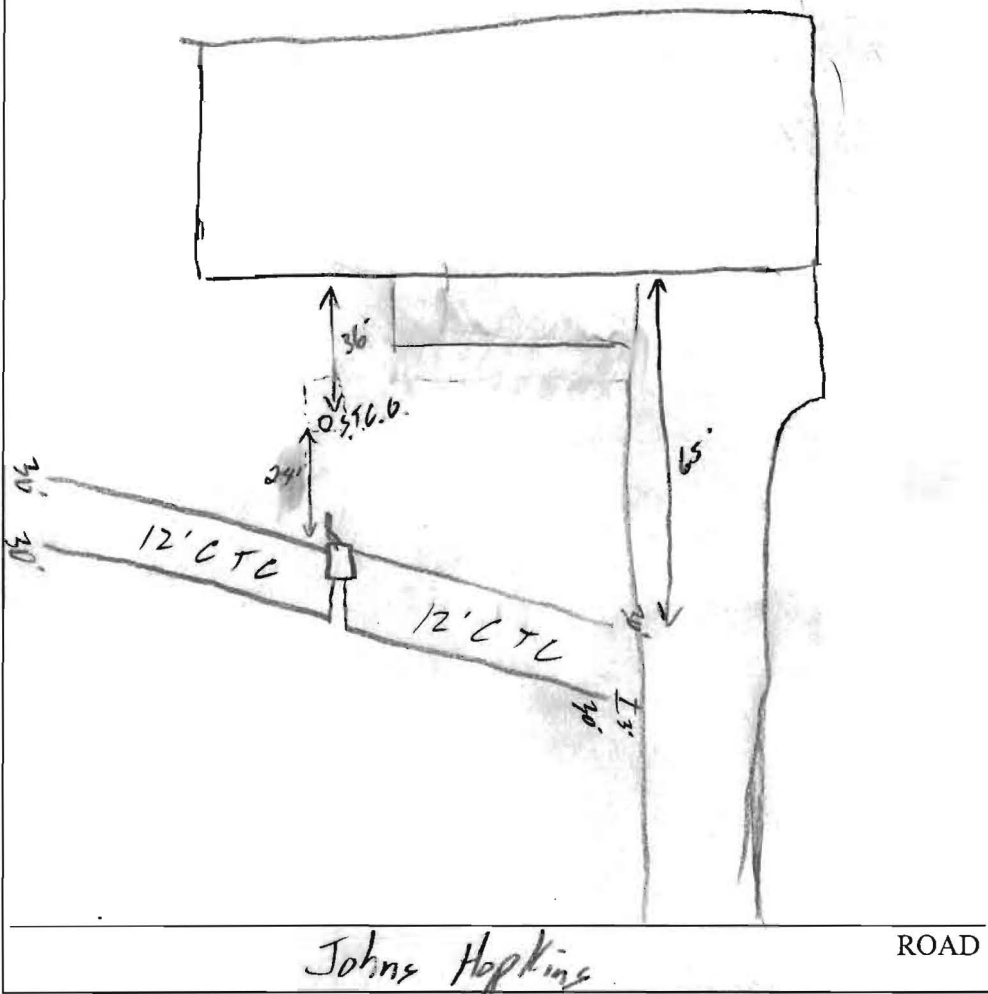

TRENCH/DRAINFIELD DATA

WIDTH	INLET	BOTTOM
_____	_____	_____
NUMBER OF TRENCHES _____		
TOTAL LENGTH _____		
ABSORPTION AREA _____		
DISTRIBUTION BOX LEVEL _____		
DISTRIBUTION BOX BAFFLE _____		
DISTRIBUTION BOX PORT _____		

SEPTIC TANK DATA

SEPTIC TANK 1 LEVEL _____

CAPACITY _____ GAL

SEAM LOC _____

TANK LID DEPTH _____

BAFFLES _____

BAFFLE FILTER _____

MANHOLE LOC _____

6" PORT LOC _____

WATERTIGHT TEST _____

SEPTIC TANK 2 LEVEL _____

CAPACITY _____ GAL

SEAM LOC _____

TANK LID DEPTH _____

BAFFLES _____

BAFFLE FILTER _____

MANHOLE LOC _____

6" PORT LOC _____

WATERTIGHT TEST _____


PRE-CONSTRUCTION see prev. sheet

INSTALLATION 2/12/04 - 4 trenches installed, D.W. collapsed when forklift drove over it. D.W. pumped, collapsed & filled in OK to cover all work (SO)

BUILDING PERMIT SIGNED AND RETURNED

FINAL INSPECTOR [Signature]

DATE OF APPROVAL 2/12/04

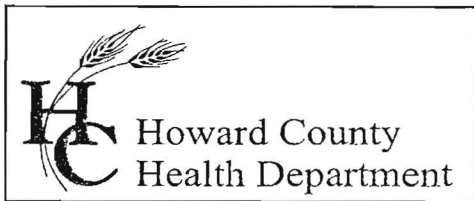

7178 Columbia Gateway Drive, Columbia, MD 21046
(410) 313-2640 Fax (410) 313-2648
TDD (410) 313-2323 Toll Free 1-866-313-6300
website: www.hchealth.org

Penny E. Borenstein, M.D., M.P.H., Health Officer

December 14, 2004

Pete & Lisa David
11525 Johns Hopkins Road
Clarksville, MD 21029

P579656

RE: 11525 Johns Hopkins Road

Dear Mr. & Mrs. David,

We have received a variance requesting the required 30' setback to a foundation for a well at the above referenced property be waived to 20'. According to the foundation drawings submitted, the new molithic poured foundation wall will be 20' from the well. This agency will grant your **approval** for the variance at the property.

Any questions regarding this decision may be directed to the Well and Septic Program of the Howard County Health Department.

Respectfully,

John A. Boris, Jr., R.S., Director
Well and Septic Program

cc: File