

APPLICATION

A 02592

P 02823

SEWAGE DISPOSAL TESTING

MARYLAND STATE DEPARTMENT OF HEALTH

HOWARD COUNTY

ELLICOTT CITY

DISTRICT 5

DATE 6/16/60

*318 sq. ft. of tile field placed
in front of lot in front of house.
Solite trenches on right side of lot
750 gal septic tank.*

TO: THE COUNTY HEALTH OFFICER
ELLICOTT CITY, MARYLAND

I, HEREBY, APPLY FOR THE NECESSARY TESTS IN ORDER TO CONSTRUCT (OR RECONSTRUCT) A SEWAGE DISPOSAL SYSTEM.

PROPERTY OWNER W. M. Robbins

ADDRESS Clarksville PHONE Atlast 6-2433

PROPERTY LOCATION:

SUBDIVISION Hopkins Meade LOT NO. 9 Sec. 1

ROAD AND DESCRIPTION Hopkins Rd.

OCCUPANT _____ PHONE _____

PERSON TO CONSTRUCT SYSTEM _____

ADDRESS _____ PHONE _____

SIZE OF LOT 1 acre TYPE BLDG. 3
NUMBER OF BEDROOMS

IF NOT SINGLE RESIDENCE DESCRIBE _____

SIGNATURE OF APPLICANT *W.M. Robbins*


APPROVED BY *J. Hennegren* FOR *Doug. Will* DATE 6-22-60

REJECTED BY _____ FOR _____ DATE _____

HOLD PENDING FURTHER TESTS _____ DATE _____

REASONS FOR REJECTION OR HOLDING _____

THIS IS NOT A PERMIT

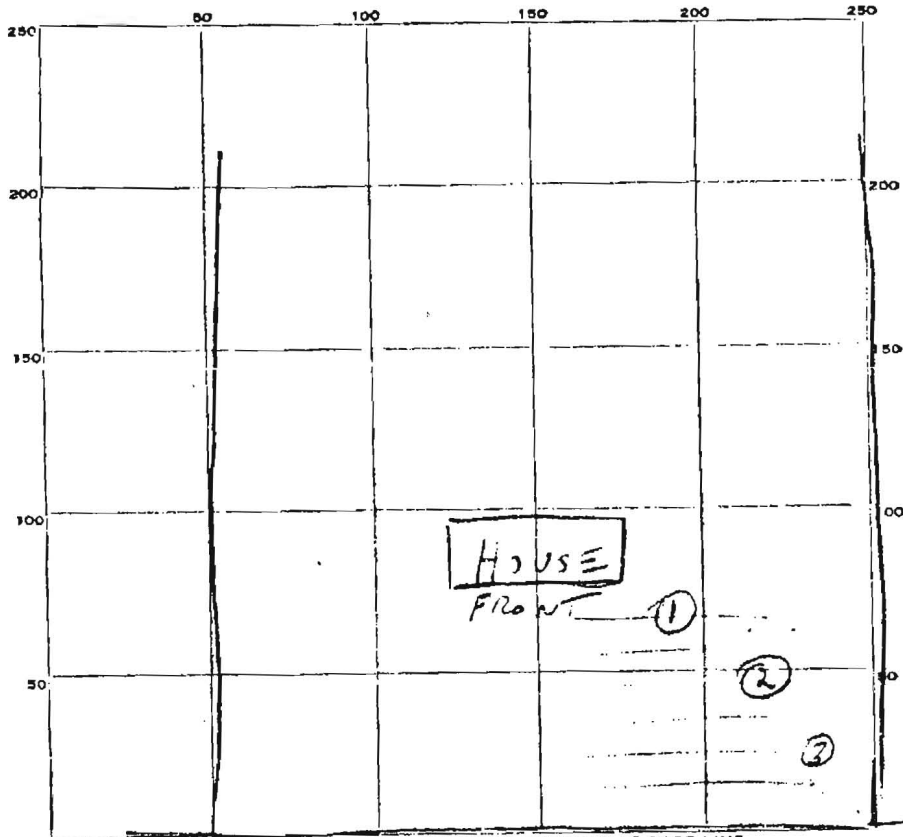

INDICATE NORTH. - NAME ADJOINING ROADWAY AS BASE LINE.

HOPKINS ROAD

DATE	TEST NO.	DEPTH	PRE-WET		TEST - 1" DROP		TIME
			START	STOP	START	STOP	
6-21-60	1	3	1:23	1:27	1:27	1:38	11 Minutes
	2	1	1:27	1:30	1:30	1:36	6 Minutes
	3	1	1:30	1:40	1:40	2:04	24 Minutes

SOIL AUGER FINDING.

TESTED BY

REMARKS

ALSO PRESENT

J. J. ...
Trenched to 1/2' below center to right side of plot.
 6-21-60
 LOT NO 17