

# APPLICATION

PERCOLATION TESTING

A \_\_\_\_\_

P \_\_\_\_\_

HOWARD COUNTY HEALTH DEPARTMENT  
BUREAU OF ENVIRONMENTAL HEALTH  
3525-H ELLICOTT MILLS DRIVE/ELLICOTT CITY, MARYLAND 21043  
TELEPHONE: 313-2640

DISTRICT \_\_\_\_\_

DATE \_\_\_\_\_

TO: THE COUNTY HEALTH OFFICER  
ELLICOTT CITY, MARYLAND

I HEREBY APPLY FOR THE NECESSARY TEST PRIOR TO APPLICATION FOR PERMIT TO CONSTRUCT (OR RECONSTRUCT) A SEWAGE DISPOSAL SYSTEM.

PROPERTY OWNER \_\_\_\_\_

ADDRESS \_\_\_\_\_ PHONE \_\_\_\_\_

AGENT OR PROSPECTIVE BUYER \_\_\_\_\_

ADDRESS \_\_\_\_\_ PHONE \_\_\_\_\_

PROPERTY LOCATION:

SUBDIVISION \_\_\_\_\_ LOT NO. \_\_\_\_\_

ROAD AND DESCRIPTION \_\_\_\_\_

TAX MAP \_\_\_\_\_ PARCEL # \_\_\_\_\_

SIZE OF LOT \_\_\_\_\_ TYPE BLDG. \_\_\_\_\_  
(SINGLE FAMILY DWELLING OR COMMERCIAL)

THE SYSTEM INSTALLED UNDER THIS APPLICATION IS ACCEPTABLE ONLY UNTIL PUBLIC FACILITIES BECOME AVAILABLE. I FULLY UNDERSTAND THE FEE CONNECTED WITH THE FILING OF THIS PERC TEST APPLICATION IS NON-REFUNDABLE UNDER ANY CIRCUMSTANCES. I ALSO AGREE TO COMPLY WITH ALL M.O.S.H.A. REQUIREMENTS IN TESTING THIS LOT. \_\_\_\_\_  
(SIGNATURE OF APPLICANT)

APPROVED BY \_\_\_\_\_ FOR \_\_\_\_\_ DATE \_\_\_\_\_

DISAPPROVED BY \_\_\_\_\_ FOR \_\_\_\_\_ DATE \_\_\_\_\_

HOLD PENDING FURTHER TESTS \_\_\_\_\_

REASONS FOR REJECTION OR HOLDING \_\_\_\_\_

PERCOLATION TEST PLAT/PRELIMINARY PLAT - TITLE OR I.D. # \_\_\_\_\_ DATE \_\_\_\_\_

SITE DEVELOPMENT PLAN/FINAL PLAT - TITLE OR I.D. # \_\_\_\_\_ DATE \_\_\_\_\_


# THIS IS NOT A PERMIT

COUNTY #


SOIL PROFILE

0'  
 7'  
 6'  
 15'  
 17'

Topsoil  
 orange tan  
 Si Clay  
 Tan Brown  
 Loam  
 H<sub>2</sub>O

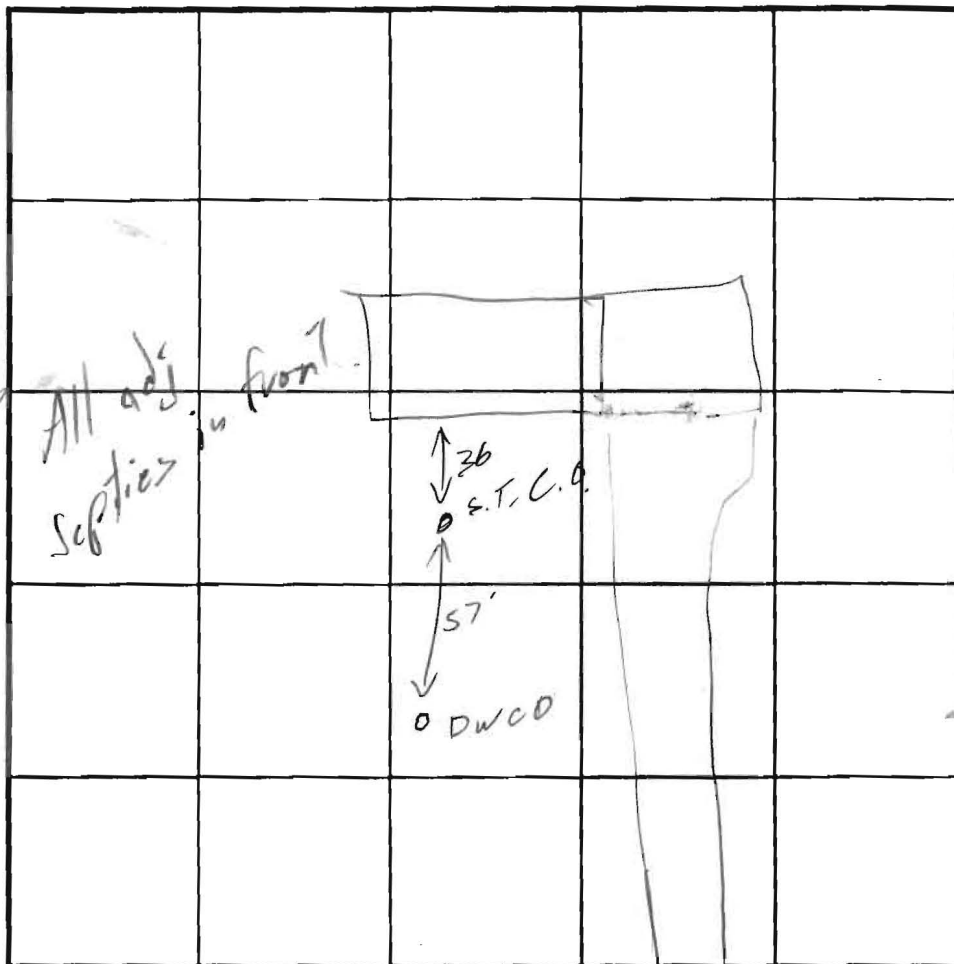

SOIL PROFILE

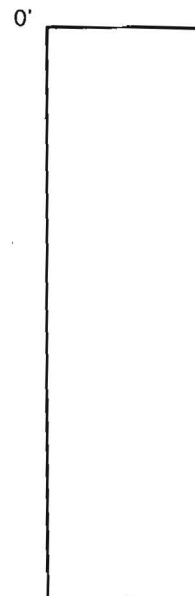

INDICATE NORTH - NAME ADJOINING ROADWAY AS BASE LINE.

DATE	TEST NO.	DEPTH	PRE-WET		TEST - 1" DROP		TIME
			START	STOP	START	STOP	
11/12/03	Ⓐ	<del>7'</del> 15'	10:19	10:20	10:20	10:23	3

REMARKS \_\_\_\_\_



TYPE OF SOIL \_\_\_\_\_

TESTED BY SD ALSO PRESENT Steve Kevin

TRENCH DESIGN DATA: AVERAGE PERCOLATION TIME 13 TRENCH WIDTH 2'

INLET DEPTH 5 MAXIMUM BOTTOM DEPTH 10 SQ. FT./BEDROOM 100

LOCATION DRAWING

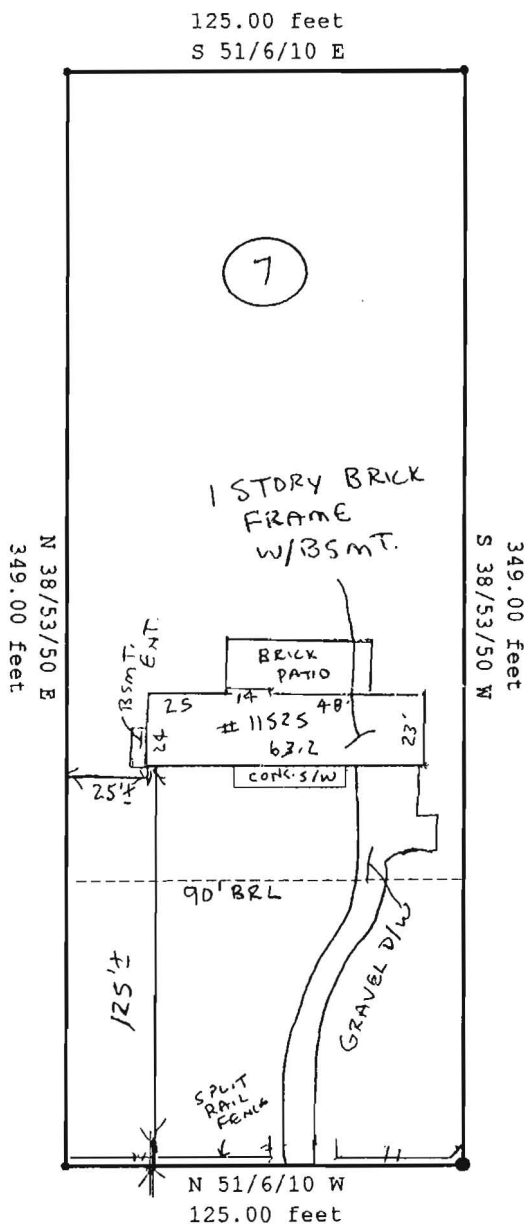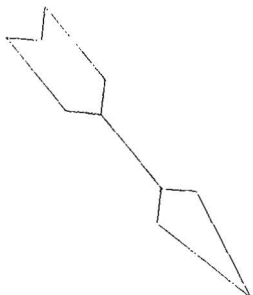

JOHNS HOPKINS ROAD



Note: Location survey measurements are +/- 1'

THE LOT SHOWN HEREON APPEARS TO LIE WITHIN FLOOD ZONE C PER F.E.M.A. FLOOD INSURANCE RATE MAP PANEL # \_\_\_\_\_ Effective Date: \_\_\_\_\_

This plat is of benefit to a consumer only insofar as it is required by a lender or a title insurance company or its agent in connection with contemplated transfer, financing or re-financing.

This plat is not to be relied upon for the establishment or location of fences, garages, buildings, or other existing or future improvements.

This plat does not provide for the accurate identification of property boundary lines, but such identification may not be required for the transfer of title or securing financing or refinancing.

THIS IS TO CERTIFY THAT WE HAVE CONDUCTED A LOCATION SURVEY OF THE IMPROVEMENTS AND THAT THEY ARE LOCATED AS SHOWN HEREON.

Signature: *Patrick G. Cathell*

Reg. No. 571 Date: 1-15-97

CLS And Associates


P.O. Box 190  
Lisbon, MD 21765

Office: (410) 442-5117 Fax: (410) 442-5175  
Beeper: 204-3565

Date: 1/15/97  
Scale: 1"=60'  
File: 977035

Project: 11525 JOHNS HOPKINS ROAD  
Clarksville, Maryland 21029

Title Deed Liber: 3490, Folio: 152  
Plat Ref: Lot 7, Plat of Sec. 1, Hopkins Mead Subdivision  
Plat Book 6, page 77

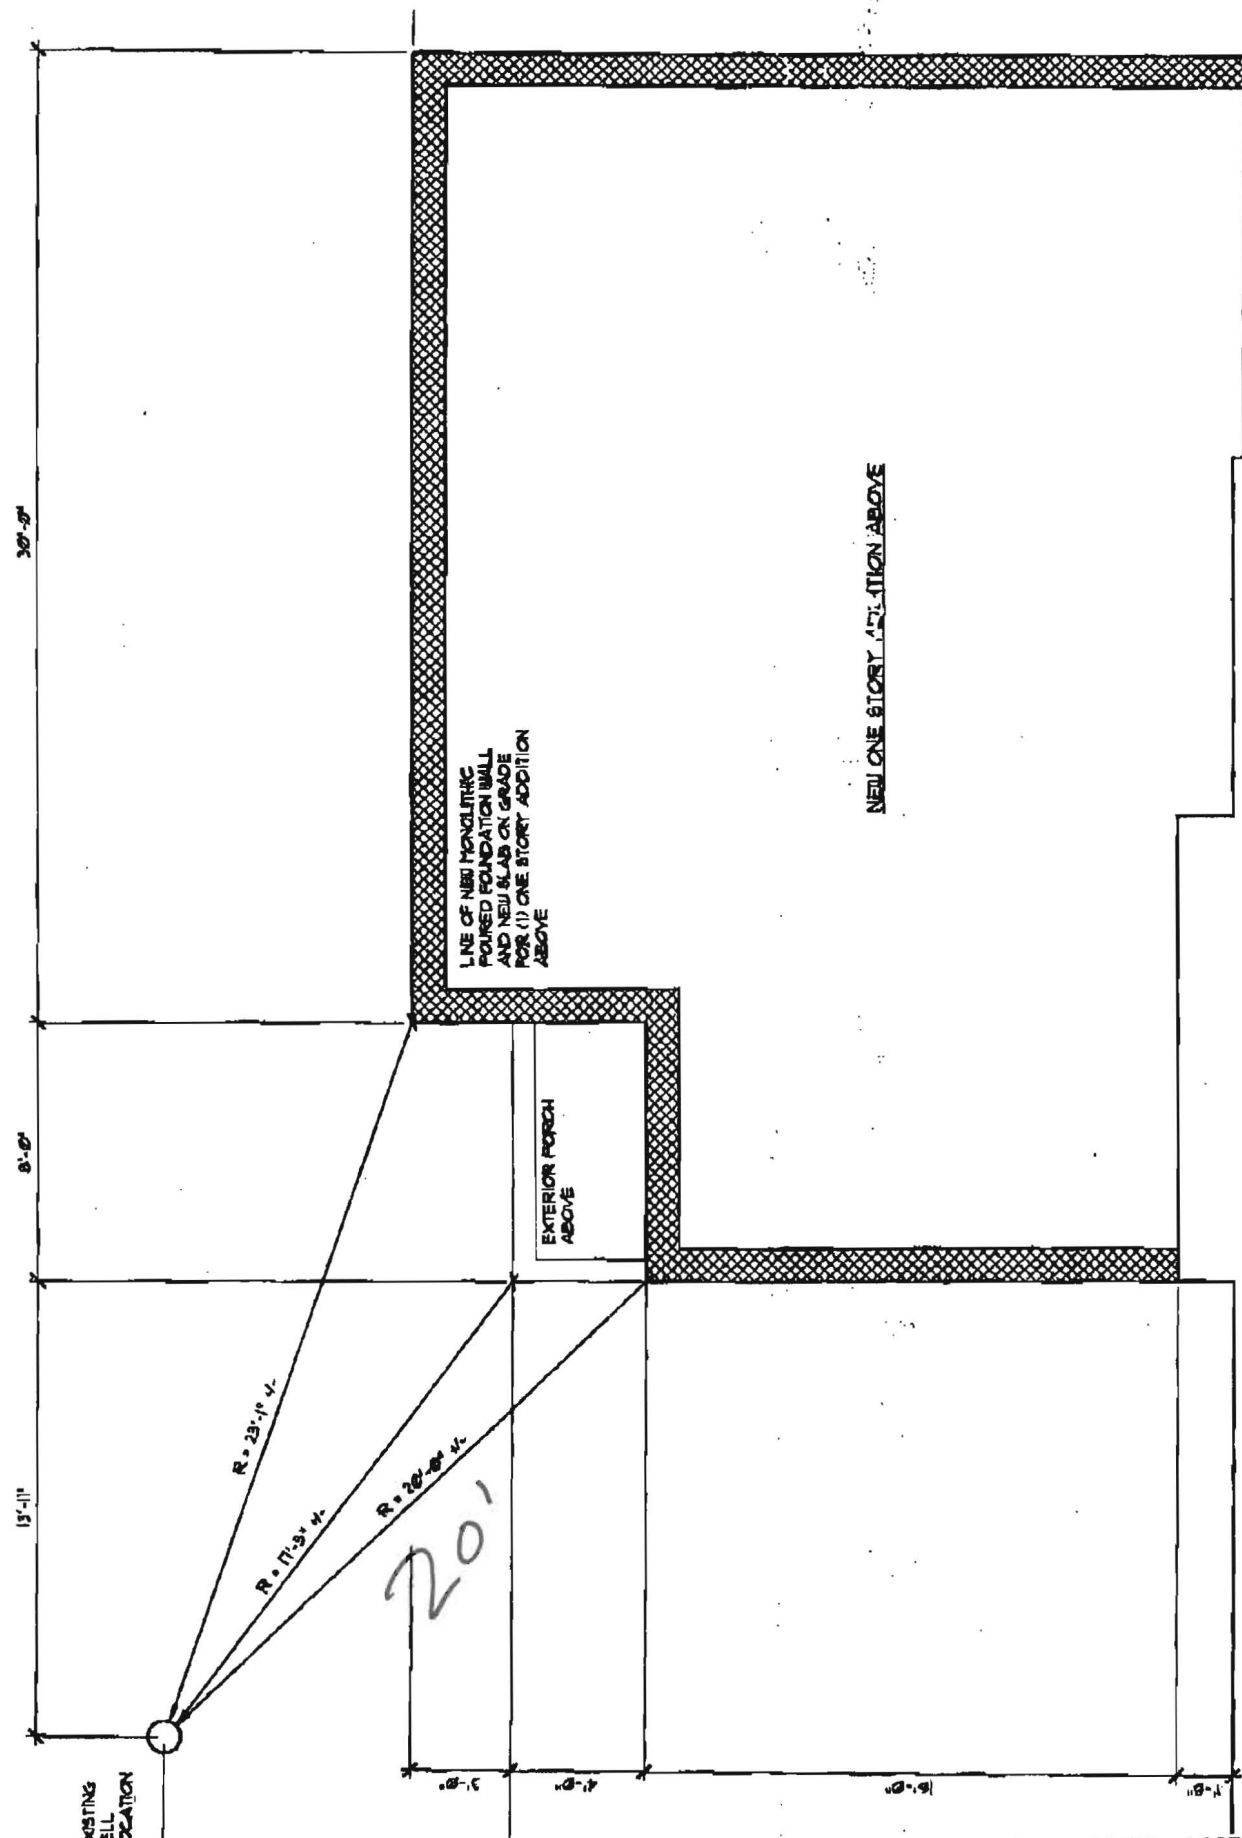

3/16" = 1'-0" scale

DAVID RESIDENCE