

Flu. 2/23/04 - pm

1/7/04 9:30

2/20/04

PUB. SEWER STATUS VERIFIED BY \_\_\_\_\_

ISSUE DATE: 12/4/2003

# PERMIT

(4)

P 519689

APPROVAL DATE: 2/23/04

A REPAIR

## ON-SITE SEWAGE DISPOSAL SYSTEM HOWARD COUNTY HEALTH DEPARTMENT BUREAU OF ENVIRONMENTAL HEALTH

05-372011

Fogles Septic Clean, Inc IS PERMITTED TO INSTALL  ALTER

ADDRESS: 580 Obrecht Road, Sykesville PHONE NUMBER: 410-795-5670

SUBDIVISION: Cabin Hill LOT NUMBER: 10

ADDRESS: 12930 Kentbury Drive PROPERTY OWNER: Michael Weidel

SEPTIC TANK CAPACITY (GALLONS): Existing

PUMP CHAMBER CAPACITY (GALLONS): N/A

NUMBER OF BEDROOMS: 4

SQUARE FEET PER BEDROOM: 180

LINEAR FEET OF TRENCH REQUIRED: 120'

3.5-5.5'  
Maximum Depth 5.5'  
2-foot of Stone


TRENCHES:	Trench to be _____ feet wide. Inlet _____ feet below original grade. Bottom maximum depth _____ feet below original grade. Effective area begins at _____ feet below original grade. _____ feet of stone below distribution pipe.
LOCATION:	
PURPOSE:	Septic system is failing. Call for inspection when the ground has been opened so sanitarian can recommend repair.

PLANS APPROVED: \_\_\_\_\_ DATE: \_\_\_\_\_

- NOTE: PERMIT VOID AFTER 2 YEARS
- NOTE: CONTRACTOR RESPONSIBLE FOR SCHEDULING A PRE-CONSTRUCTION INSPECTION FOR ALL INSTALLATIONS
- NOTE: WATERTIGHT SEPTIC TANKS REQUIRED
- NOTE: ALL PARTS OF SEPTIC SYSTEM SHALL BE 100 FEET FROM ANY WATER WELL
- NOTE: MANHOLE RISERS REQUIRED ON ALL SEPTIC TANKS AND PUMP CHAMBERS

**NEITHER THE HOWARD COUNTY COUNCIL NOR THE HEALTH DEPARTMENT IS RESPONSIBLE FOR THE SUCCESSFUL OPERATION OF ANY SYSTEM PERMITTEE RESPONSIBLE FOR OBTAINING FINAL APPROVAL ON THIS PERMIT CALL 410-313-2640 FOR INSPECTION OF SEPTIC SYSTEM**

PS19689

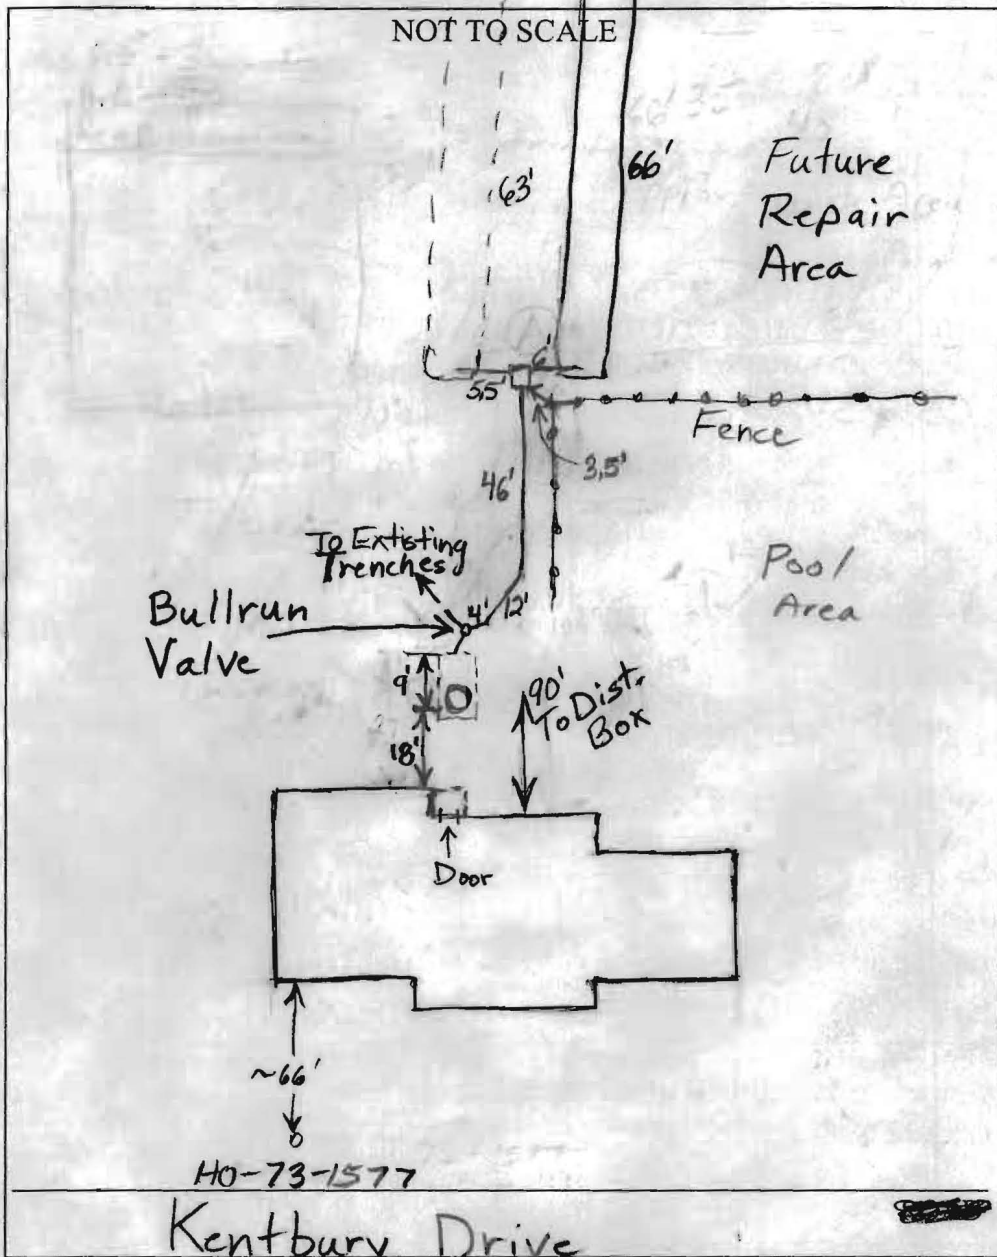

TRENCH/DRAINFIELD DATA		
WIDTH	INLET	BOTTOM
5'	3.5	5.5
NUMBER OF TRENCHES		2
TOTAL LENGTH		129'
ABSORPTION AREA		645 + Sidewall
DISTRIBUTION BOX LEVEL		✓
DISTRIBUTION BOX BAFFLE		✓
DISTRIBUTION BOX PORT		No

SEPTIC TANK DATA	
SEPTIC TANK 1 LEVEL	
CAPACITY	Existing GAL
SEAM LOC	
TANK LID DEPTH	
BAFFLES	New Rear Baffle
BAFFLE FILTER	No
MANHOLE LOC	Front?
6" PORT LOC	No
WATERTIGHT TEST	No
SEPTIC TANK 2 LEVEL N/A	
CAPACITY	GAL
SEAM LOC	
TANK LID DEPTH	
BAFFLES	
BAFFLE FILTER	
MANHOLE LOC	
6" PORT LOC	
WATERTIGHT TEST	

PRE-CONSTRUCTION 1/7/04 To install 2-5' wide trenches with a separation of 5' from edge to edge behind pool - parallel to the fence. Trenches will be off contour in order to save area. Bottom of trenches no deeper than 5.5' at lowest elevation - can be deeper as trenches are run uphill. Keep bottom of trench level - 2 laterals per trench, Minimum of 120' of trench. To install bullrun valve so that effluent can be switched to existing trenches later on (BB)

2/20/04 Twist 5' wide trench done. Bullrun valve and distribution box installed (BB) Second 5' wide trench installed

FINAL INSPECTOR B. Baker DATE OF APPROVAL 2/23/04

per Fogles. Covered without inspection. (BB)