


18875 A

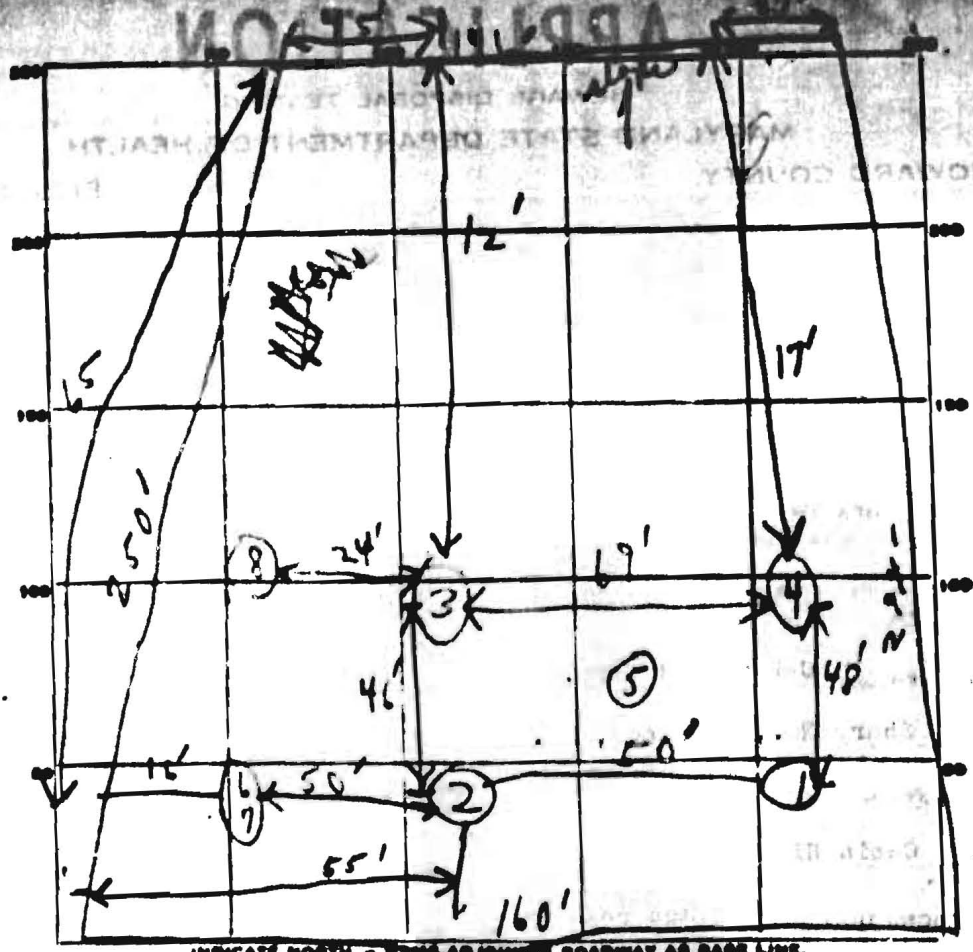

INDICATE NORTH - WITH ARROWING ROADWAY AS BASE LINE.

Soil Test # 10 Blks

DATE	TEST NO.	DEPTH	PRE-WET		TEST - 1" DR 'P		TIME
			START	STOP	START	STOP	
2/15/77	1	3'	3:11	3:14	3:14	3:20	6 min
	2	3 1/2'	3:14	3:17	3:17	3:25	8 min
	3	3 1/2'	3:16	3:18	3:18	3:22	4 min
	4	3 1/2'	3:12	3:14	3:14	3:16	2 min
	5	9'	3:10	3:13	3:13	3:17	4 min
	6	5 1/2'	3:27	3:29	3:29	3:31	2 min
	7	12'	3:27	3:30	3:30	3:35	5 min
	7th	11 1/2'	water			7:31	5 min
						No logs	Flan 4' x 6'

No basement foundation

SOIL AUGER FINDING

TESTED BY: B.S. Pravin Frelde { checked with  
 REMARKS: Lot fairly level field check on well  
Soil top ground