

76
176
176

PERMIT

SEWAGE DISPOSAL SYSTEM

MARYLAND STATE DEPARTMENT OF HEALTH

HOWARD COUNTY

INDEXED

ELLICOTT CITY

DISTRICT 5th

DATE 10/22/76

16675

_____ IS PERMITTED TO INSTALL ALTER _____

Jennings Chapel Road, Woodbine, Md. 21797 PHONE 489-4724

DISPOSAL SYSTEM LOCATED AT _____

Cabin Hill ¹²⁹³⁰ ~~W. Kennedy~~ ^{W. Kennedy} Drive LOT 10, Blk. A, Sec. 2

OWNER Michael P. & Suzanne M. Wiedel

ROOMS 4 bedrooms

DRAIN FIELD _____ DEPTH _____ FEET. BOTTOM AREA _____ SQ. FT.

SEEPAGE PITS _____ ABSORBENT SIDE-WALL AREA _____ SQ. FT.

SEPTIC TANK CAPACITY 1250 GALLONS

FOR GARBAGE GRINDER, INCREASE DISPOSAL AREA 25% & TANK CAPACITY 50%.

TRENCHES - Two 84 ft. trenches with 2 ft. of gravel in trench. Maximum depth ~~of~~ trenches 65 ft. from back property line and 40 ft. from right-hand property line when facing lot from the road. Invert into ~~existing~~ trench ~~as~~ at 3 ft. ~~below~~ ~~bottom~~ OF TRENCH BEFORE PLACING STONE IN TRENCH.

PIPE FROM HOUSE TO DISPOSAL AREA MUST BE CAST IRON. ~~AND~~ AFTER THREE YEARS.

ALL STAND PIPE ON SEPTIC TANK. STAND PIPES MUST BE 4 INCHES IN DIAMETER. ~~AND~~ CAST IRON, CONCRETE OR TERRA COTTA ACCEPTED.


APPROVED BY Fred Frommelt DATE 10/14/76

COVER TANK AND DISTRIBUTION BOX WITH WATER BEFORE CALLING FOR AN INSPECTION. COVER NO WORK NOTED AND APPROVED.

HOWARD COUNTY COMMISSIONERS NOR THE HEALTH DEPARTMENT IS RESPONSIBLE FOR THE OPERATION OF ANY SYSTEM.

BLDG. PERMIT SIGNED AND RETURNED 3/1/84 Serial # 57601 Pool

16675

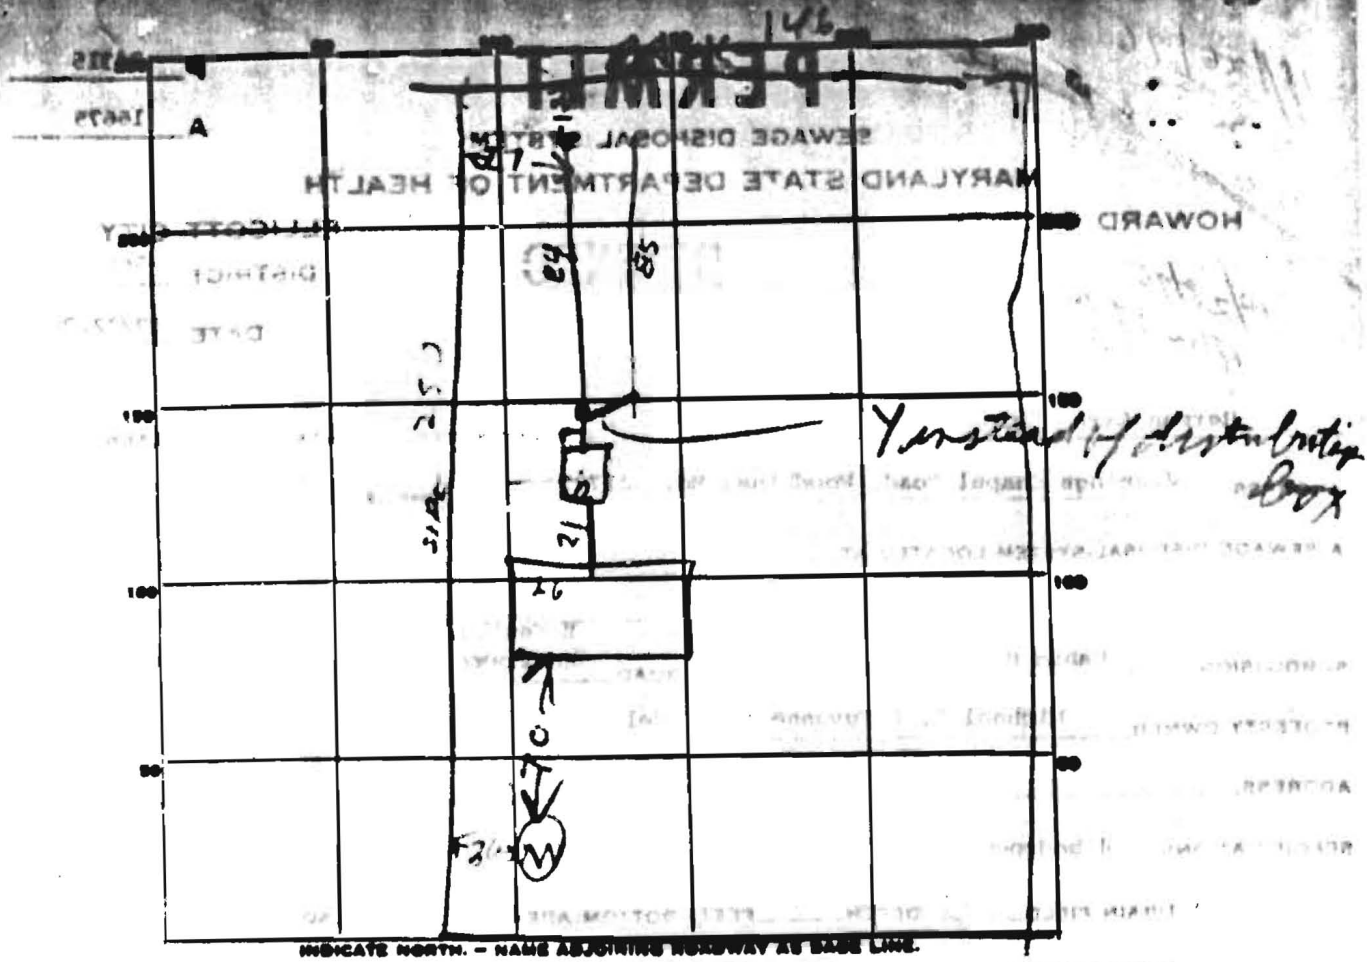

INDICATE NORTH. - NAME ADJOINING HIGHWAY AS BASE LINE.

PERMIT CARD

SEPTIC TANK LEVEL NOT YET IN PLACE 10/26/76 CLEANOUTS OK

10/26/76 OK 1250 TOP IN 1 FT BELOW GRADE

DISTRIBUTION BOX LEVEL

PITCH TRENCH DEPTH 5 FT. TRENCH WIDTH 3 FT.

GRAVEL DEPTH 2 FT IN. TOTAL LENGTH 169 FT.

NUMBER OF TRENCHES 2 TOTAL SURFACE AREA 338

SEEPAGE PITS, INSIDE DIAMETER _____ FT. DEPTH BELOW INLET _____ FT.

ABSORBENT AREA _____ SQ. FT.

REMARKS 10/25/76 DM SAID OK TO CHANGE LOCATION

OF SYSTEM AS LONG AS IT IS IN PERC AREA

10/26/76 - DITCH OK AND ROCKS, INSTALL TANKS

3 CALL FOR INSPECTION REC

10/29/76 - H. SIRK CALLED DM ON RADIO & GOT PERMISSION

TO PUT IN Y INSIDE OF DISTRIBUTION BOX

5 TONE RATED TODAY

DATE SYSTEM APPROVED 10/29/76 INSPECTOR Raymond Dodge