

HOWARD COUNTY
 PERMIT APPLICATION

PERMIT NUMBER

B09001785

Building Address 12732 LIME KILN RD
HIGHLAND, MD 20777
 Suite/Apt. #: _____ SDP/WP/Petition #: _____
 Census Tract _____ Subdivision _____
 Section _____ Area _____ Lot _____
 Tax Map _____ Parcel _____ Grid _____
 Zoning _____ Map Coordinates _____ Lot size _____

Property Owner's Name ROBERT RICHARDSON
 Address 12732 LIME KILN RD
 City HIGHLAND State MD Zip Code 20777
 Home Phone 410-988-9074 Work Phone 443-474-9572
 Applicant's Name & Mailing Address, (if other than stated hereon): _____
 Phone _____ Fax _____

Existing Use N/A
 Proposed Use OUTDOOR LIVING SPACE
 Estimated Construction Cost \$ 3,500
 Description of Work DECK 14 X 25 and
12 X 22.

Contractor Company N/A
 Contact Person _____
 Address _____
 City _____ State _____ Zip Code _____
 License No. _____
 Phone _____ Fax _____

Occupant or Tenant _____
 Contact Name _____
 Address _____
 City _____ State _____ Zip Code _____
 Phone _____ Fax _____

Engineer or Architect Company _____
 Contact Person _____
 Address _____
 City _____ State _____ Zip Code _____
 Phone _____ Fax _____

NEVER BUILT

BUILDING DESCRIPTION - COMMERCIAL

BUILDING DESCRIPTION - RESIDENTIAL

Building Characteristics	Utilities
Height: _____	Water Supply: <input type="checkbox"/> Public <input type="checkbox"/> Private
No. of stories: _____	Sewage Disposal: <input type="checkbox"/> Public <input type="checkbox"/> Private
Gross area, sq. ft. per floor: _____	Electric Yes <input type="checkbox"/> No <input type="checkbox"/> Gas Yes <input type="checkbox"/> No <input type="checkbox"/>
Use group: _____	Heating System: <input type="checkbox"/> Electric <input type="checkbox"/> Oil <input type="checkbox"/> <input type="checkbox"/> Natural Gas <input type="checkbox"/> <input type="checkbox"/> Propane Gas <input type="checkbox"/>
Construction type: <input type="checkbox"/> Reinforced Concrete <input type="checkbox"/> Structural Steel <input type="checkbox"/> Masonry <input type="checkbox"/> Wood Frame <input type="checkbox"/> State Certified Modular	Sprinkler system: <u>N/A</u> <input type="checkbox"/> <input type="checkbox"/> Full <input type="checkbox"/> Partial <input type="checkbox"/> Other Suppression # of Heads _____

Building Characteristics	Utilities
SF Dwelling <input checked="" type="checkbox"/> SF Townhouse <input type="checkbox"/> Depth _____ Width _____	Water Supply: <input type="checkbox"/> Public <input checked="" type="checkbox"/> Private
1st floor: _____ 2nd floor: _____ Basement: _____	Sewage Disposal: <input type="checkbox"/> Public <input checked="" type="checkbox"/> Private
Finished Basement <input type="checkbox"/> Unfinished Basement <input type="checkbox"/> Crawl space <input type="checkbox"/> Slab on Grade <input type="checkbox"/> No. of Bedrooms: _____ Height: _____	Electric Yes <input type="checkbox"/> No <input type="checkbox"/> Gas Yes <input type="checkbox"/> No <input type="checkbox"/>
Multi-family dwellings: No. of efficiency units: _____ No. of 1 BR units: _____ No. of 2 BR units: _____ No. of 3 BR units: _____	Heating System: <input type="checkbox"/> Electric <input type="checkbox"/> Oil <input type="checkbox"/> <input type="checkbox"/> Natural Gas <input type="checkbox"/> <input type="checkbox"/> Propane Gas <input type="checkbox"/>
Other Structure: _____ Dimensions: _____ Footings: _____ Roof Height: _____ <input type="checkbox"/> State Certified Modular <input type="checkbox"/> Manufactured Home	Sprinkler system: <u>N/A</u> <input type="checkbox"/> <input type="checkbox"/> NFPA #13D <input type="checkbox"/> NFPA #13R <input type="checkbox"/> Other.

THE UNDERSIGNED HEREBY CERTIFIES AND AGREES AS FOLLOWS: (1) THAT HE/SHE IS AUTHORIZED TO MAKE THIS APPLICATION; (2) THAT THE INFORMATION IS CORRECT; (3) THAT HE/SHE WILL COMPLY WITH ALL REGULATIONS OF HOWARD COUNTY WHICH ARE APPLICABLE THERETO; (4) THAT HE/SHE WILL PERFORM NO WORK ON THE ABOVE REFERENCED PROPERTY NOT SPECIFICALLY DESCRIBED IN THIS APPLICATION; (5) THAT HE/SHE GRANTS COUNTY OFFICIALS THE RIGHT TO ENTER ONTO THIS PROPERTY FOR THE PURPOSE OF INSPECTING THE WORK PERMITTED AND POSTING NOTICES.

Robert K. Richardson
 Applicant's Signature
COADY & FARLEY
 Title/Company


ROBERT K. RICHARDSON
 Print Name
7/17/09
 Date

Checks payable to: **DIRECTOR OF FINANCE OF HOWARD COUNTY**
 ** PLEASE WRITE NEATLY AND LEGIBLY **

FOR OFFICE USE ONLY

AGENCY	DATE	SIGNATURE APPROVAL	DPZ SETBACK INFORMATION	PROPERTY ID#
Land Development DPZ			Front: _____	Filing fee \$ _____
State Highways			Rear: _____	Permit fee \$ _____
Building Official			Side: _____	Excise tax \$ _____
Dev. Engineering DPZ	<u>7/17/09</u>	<u>[Signature]</u>	Side St. _____	Add'l per. fee \$ _____
Health			All minimum setbacks met?	TOTAL FEES \$ _____
Fire Protection			YES <input type="checkbox"/> NO <input type="checkbox"/>	Sub-total paid \$ _____
Is Sediment Control approval required prior to issuance?			Is Entrance Permit required?	Balance due \$ _____
YES <input type="checkbox"/> NO <input type="checkbox"/>			YES <input type="checkbox"/> NO <input type="checkbox"/>	Check \$ _____
CONTINGENCY CONSTRUCTION START: <input type="checkbox"/>			Historic District?	Validation # _____
ONE STOP SHOP: <input type="checkbox"/>			YES <input type="checkbox"/> NO <input type="checkbox"/>	
Distribution of Copies -	White: Building Official	Green: LDD, DPZ	Lot Coverage for New Town Zone _____	
Yellow: DED, DPZ	Pinic Health	Gold: SHA	SDP/Red-line approval date _____	Accepted by _____
Forms/PERMIT.FRM				

5/26/04 spoke to Surveyor
for tag# - matched
our file KN

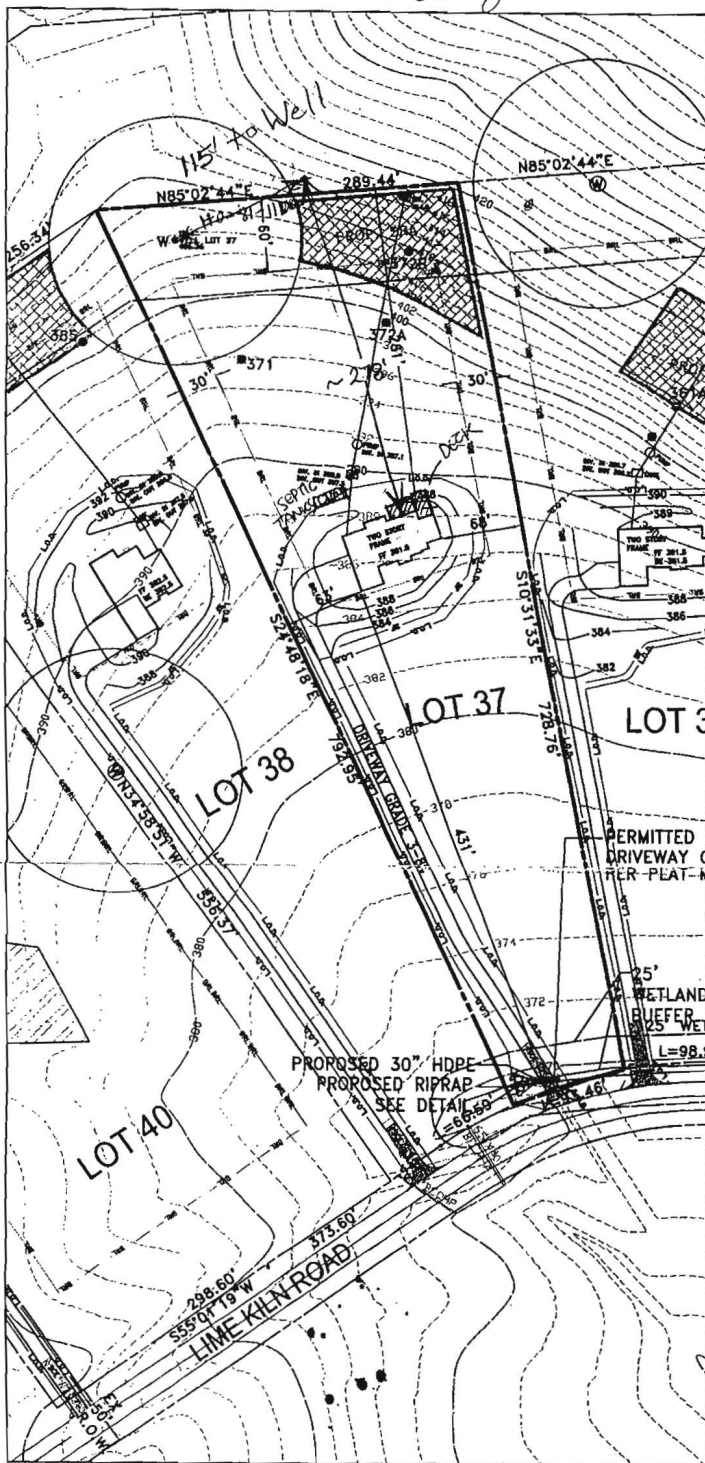

SCALE: 1"=100'

APPROVED

WALK-THRU BUILDING PERMIT

BP# _____ A# 519697-8

APP. SAN _____ DATE: 7/17/09

DESC. OF WORK: 14'x25' and 12'x22' Jack elevated

TOPOGRAPHY PROVIDED BY
HOWARD COUNTY



KCW Engineering Technologies, Inc.
3106 Lord Baltimore Drive, Suite 110
Baltimore, Maryland 21244
Tele (410) 281-0033
Fax (410) 281-1065
www.KCW-ET.com

PAVING
SPECIFICATIONS
3" BIT CONC.
6" CR-6



OWNER
POTOMAC ELECTRIC POWER CO.
1900 PENNSYLVANIA AVE. N.W.
WASHINGTON D.C. 20068

BUILDER
ALTRI HOMES, INC.
9017 RED BRANCH ROAD, SUI. 201
COLUMBIA, MD 21045

PLAT TO ACCOMPANY BUILDING PERMIT
FOR
LIME KILN VALLEY
LOT 37, LIME KILN ROAD

SCALE: AS SHOWN
MARCH 11, 2004

PLAT REFERENCE: MDR 10883
ELECTION DISTRICT - 5
HOWARD CO., MARYLAND

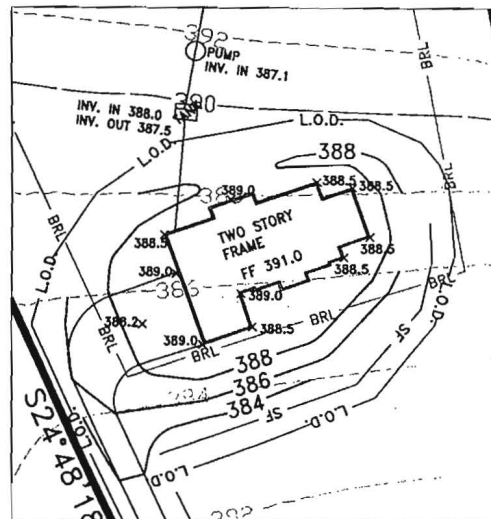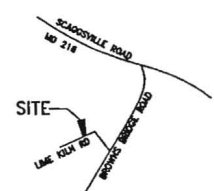

HOUSE INSERT
SCALE: 1"=50'


LEGEND

- 396 — EXISTING CONTOUR
- 396 — PROPOSED CONTOUR
- ⊗ EXISTING WELL
- ⊕ PROPOSED WELL
- ▨ PROPOSED SEPTIC RESERVE AREA
- BRL — BUILDING RESTRICTION LINE
- L.O.D. — LIMIT OF DISTURBANCE
- S.F. — PROPOSED SILT FENCE PER H.C.S.C.D. DETAIL E-15
- PROPOSED SCE PER H.C.S.C.D. DETAIL F-17-3

NOTE

1. DRIVEWAY CONSTRUCTION SHALL DISTURB ONLY THAT WHICH CAN BE BACKFILLED AND STABILIZED AT THE END OF EACH WORKING DAY.
2. EJECTOR PUMP BASEMENT
3. THE EXISTING WELL(S) SHOWN ON THIS PLAN HAS BEEN FIELD LOCATED BY KCW ENGINEERING TECHNOLOGIES PROFESSIONAL LAND SURVEYOR(S) AND IS ACCURATELY SHOWN.

5/26/04
Wall
check ok
to scale
(KN)

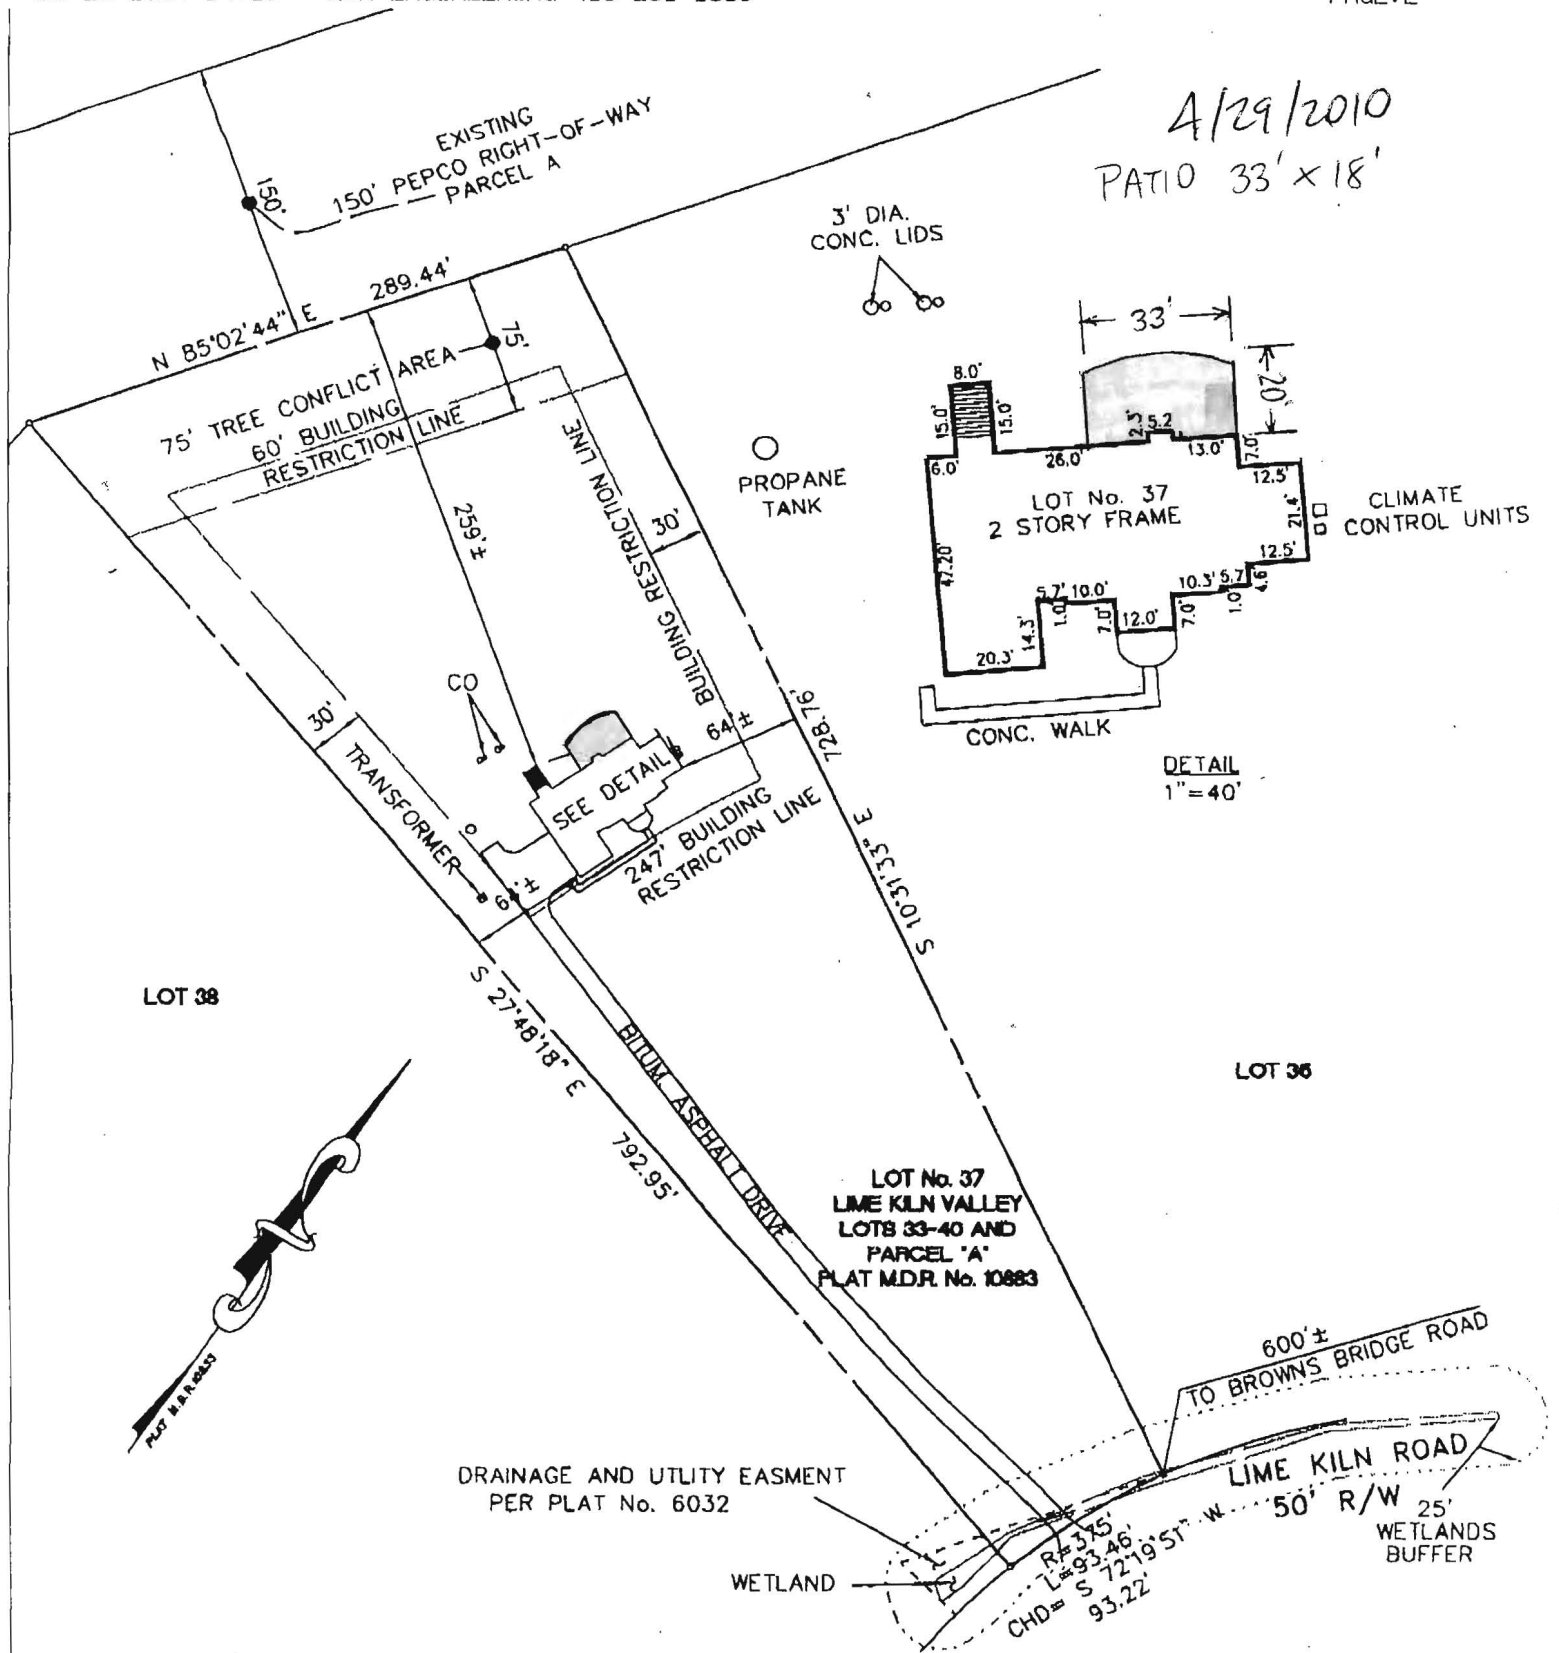

SURVEYORS CERTIFICATION

I hereby certify that I have made a survey of this property for the purpose of locating the improvements thereon and that they are located as shown. This is not a property line survey.

William K. Woody
 Date *9/27/04*
 William K. Woody
 Professional Land Surveyor
 Lic. No. 10724

NOTES:

1. This plot is of benefit to the consumer only insofar as it is required by a the lender or the title insurance company or its agent in connection with contemplated transfer, financing or re-financing.
2. This plot is not to be relied upon for the establishment or location of fences, garages, buildings, or other existing or future improvements.
3. This plot does not provide for the accurate identification of property boundary lines, but such identification may not be required for the transfer of title or securing financing or refinancing.

PLAT REF. LIME KILN VALLEY LOTS 33-40 AND PARCEL "A" PLAT M.D.R. No. 10833

KCW JO. 2030269



KCW Engineering Technologies, Inc.
 3106 Lord Baltimore Drive, Suite 110
 Baltimore, Maryland 21244
 Tele (410) 281-0030
 Fax (410) 281-1065
 www.KCW-ET.com


Comp. By:	M.D.T
Drawn By:	A.J.P.
Checked By:	W.K.W.

LOCATION SURVEY

**LOT No.37
 LIME KILN VALLEY
 LOTS 33-40 AND PARCEL "A"
 PLAT M.D.R. No. 10883**



5TH ELECTION DISTRICT
 HOWARD COUNTY, MARYLAND

SCALE: 1" = 100' DATE: SEPT. 27, 2004

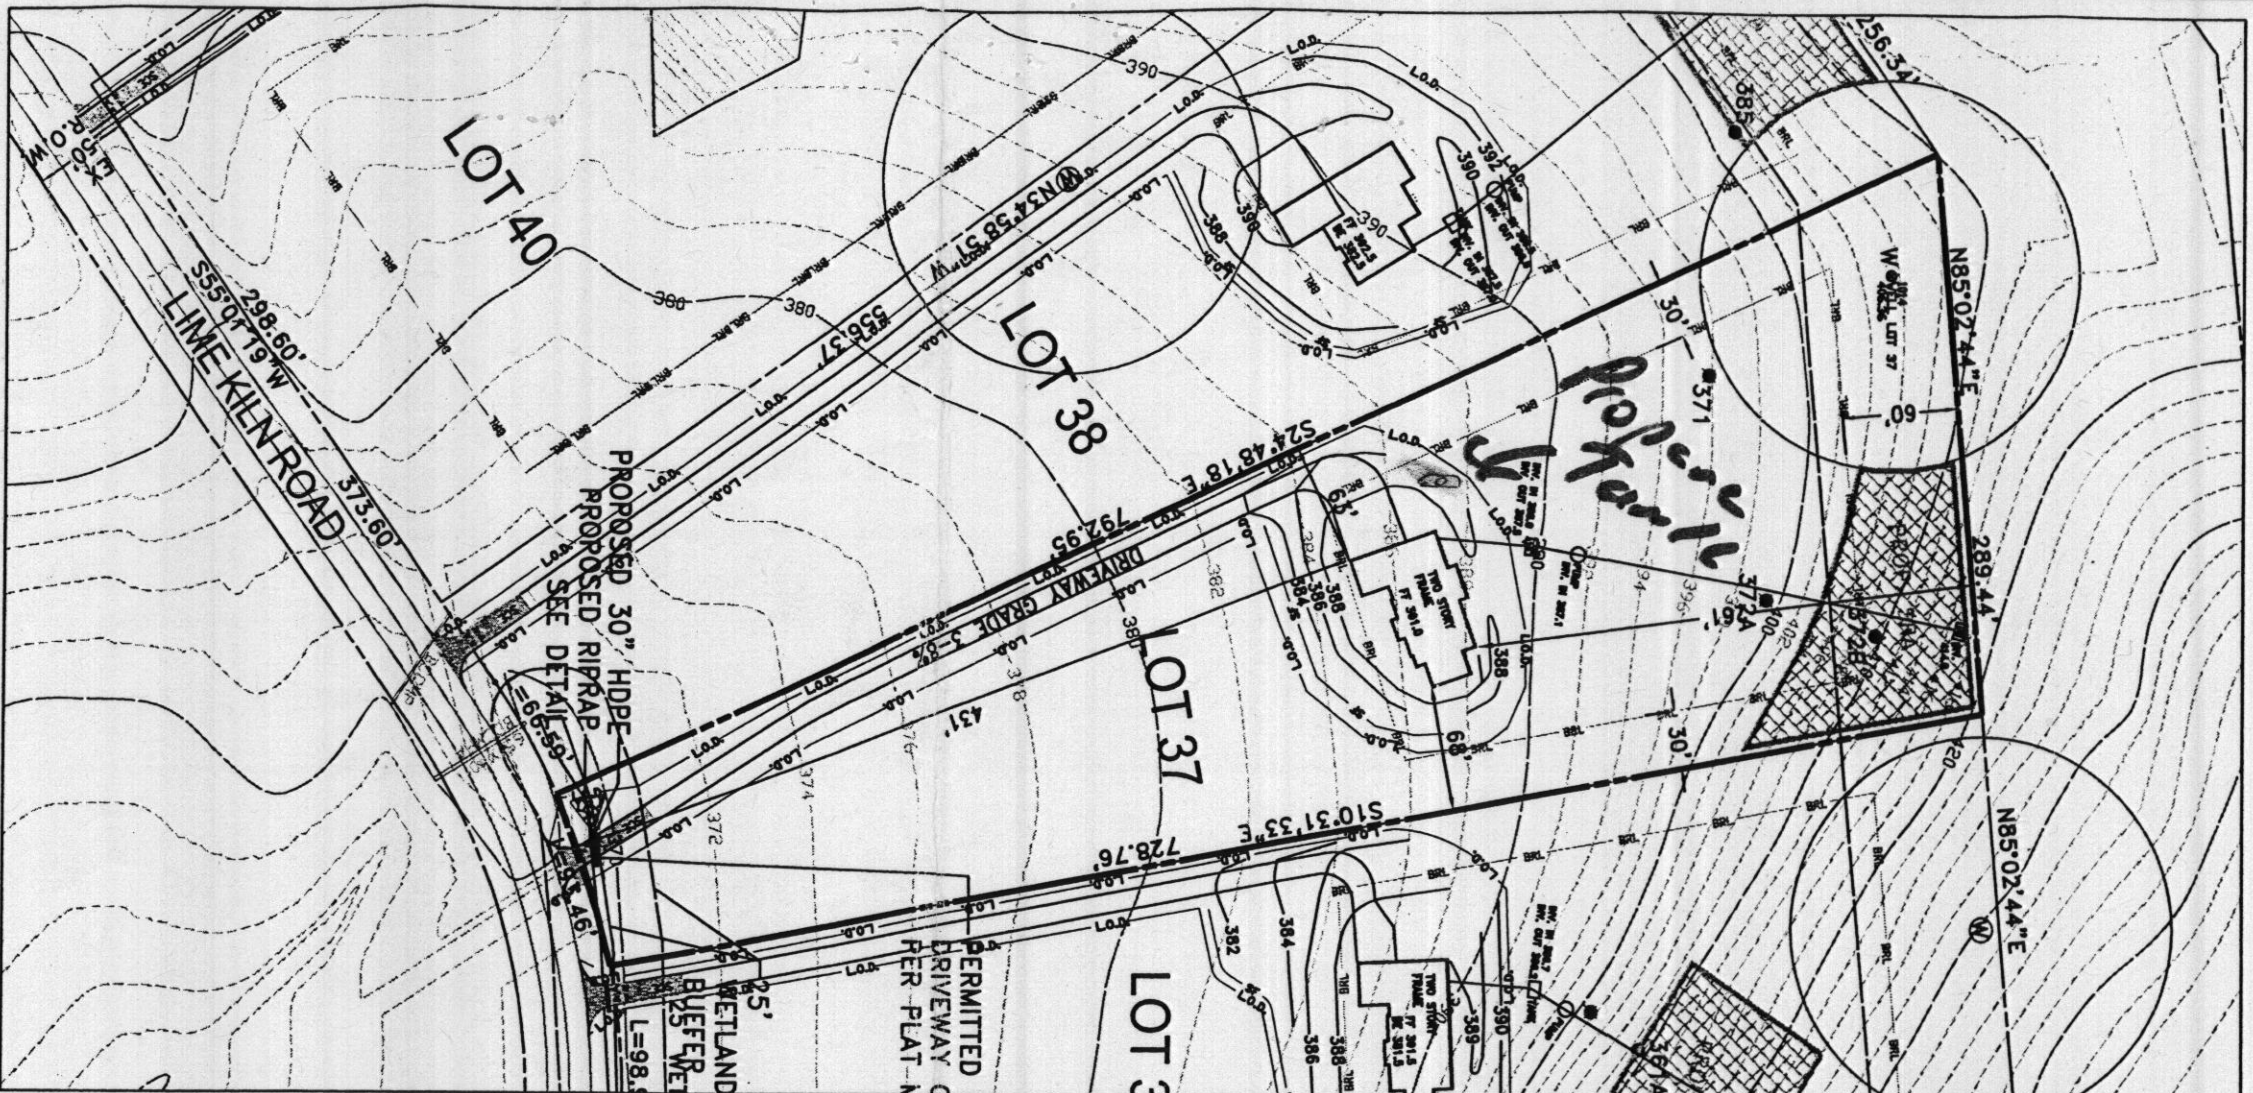

SCALE: 1"=100'

TOPOGRAPHY PROVIDED BY
HOWARD COUNTY

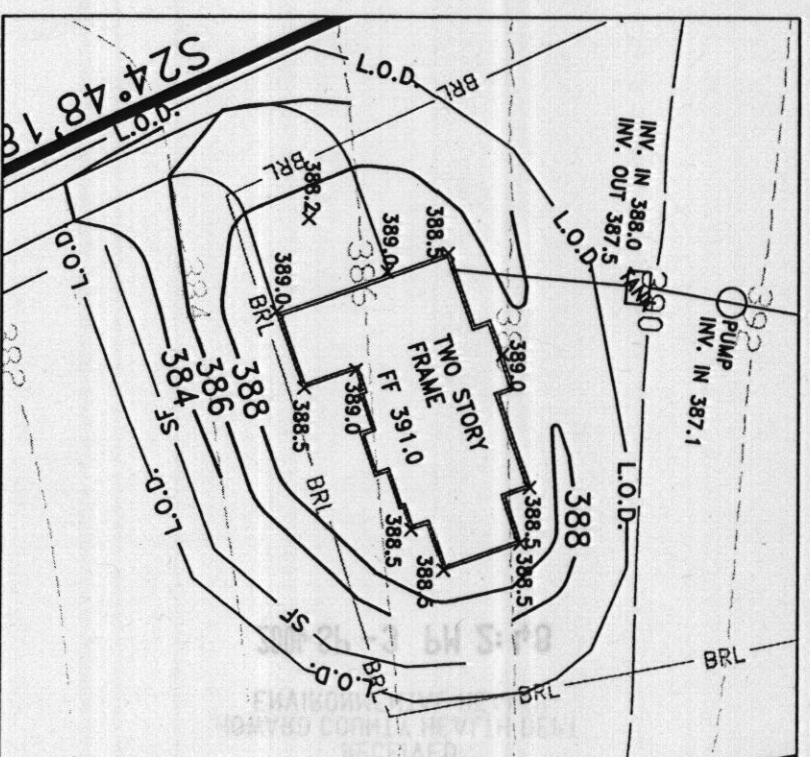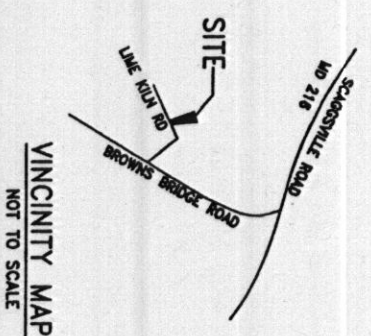

PERMITTED ESSENTIAL
DRIVEWAY CROSSING
PER PLAT MDR 10833

LEGEND

- 396 — EXISTING CONTOUR
- 396 — PROPOSED CONTOUR
- ⊗ EXISTING WELL
- ⊙ PROPOSED WELL
- ▨ PROPOSED SEPTIC RESERVE AREA
- BRL — BUILDING RESTRICTION LINE
- L.O.D. — LIMIT OF DISTURBANCE
- S.F. — PROPOSED SILT FENCE PER H.C.S.C.D. DETAIL E-15
- — PROPOSED SCE PER H.C.S.C.D. DETAIL F-17-3

NOTE

1. DRIVEWAY CONSTRUCTION SHALL DISTURB ONLY THAT WHICH CAN BE BACKFILLED AND STABILIZED AT THE END OF EACH WORKING DAY.
2. EJECTOR PUMP BASEMENT
3. THE EXISTING WELL(S) SHOWN ON THIS PLAN HAS BEEN FIELD LOCATED BY KCW ENGINEERING TECHNOLOGIES PROFESSIONAL LAND SURVEYOR(S) AND IS ACCURATELY SHOWN.

PAVING SPECIFICATIONS
3" BIT CONC.
6" CR-6

OWNER
POTOMAC ELECTRIC POWER CO.
1900 PENNSYLVANIA AVE. N.W.
WASHINGTON D.C. 20068

BUILDER
ALTERI HOMES, INC.
9017 RED BRANCH ROAD, SUI. 201
COLUMBIA, MD 21045

PLAT TO ACCOMPANY BUILDING PERMIT

FOR
LIME KILN VALLEY
LOT 37, LIME KILN ROAD




ENGINEERING
TECHNOLOGIES

KCW

KCW Engineering Technologies, Inc.
3106 Lord Baltimore Drive, Suite 110
Baltimore, Maryland 21244
Tele (410) 281-0033
Fax (410) 281-1065
www.KCW-ET.com

SCALE: AS SHOWN
MARCH 11, 2004

PLAT REFERENCE: MDR 10883
ELECTION DISTRICT - 5
HOWARD CO., MARYLAND

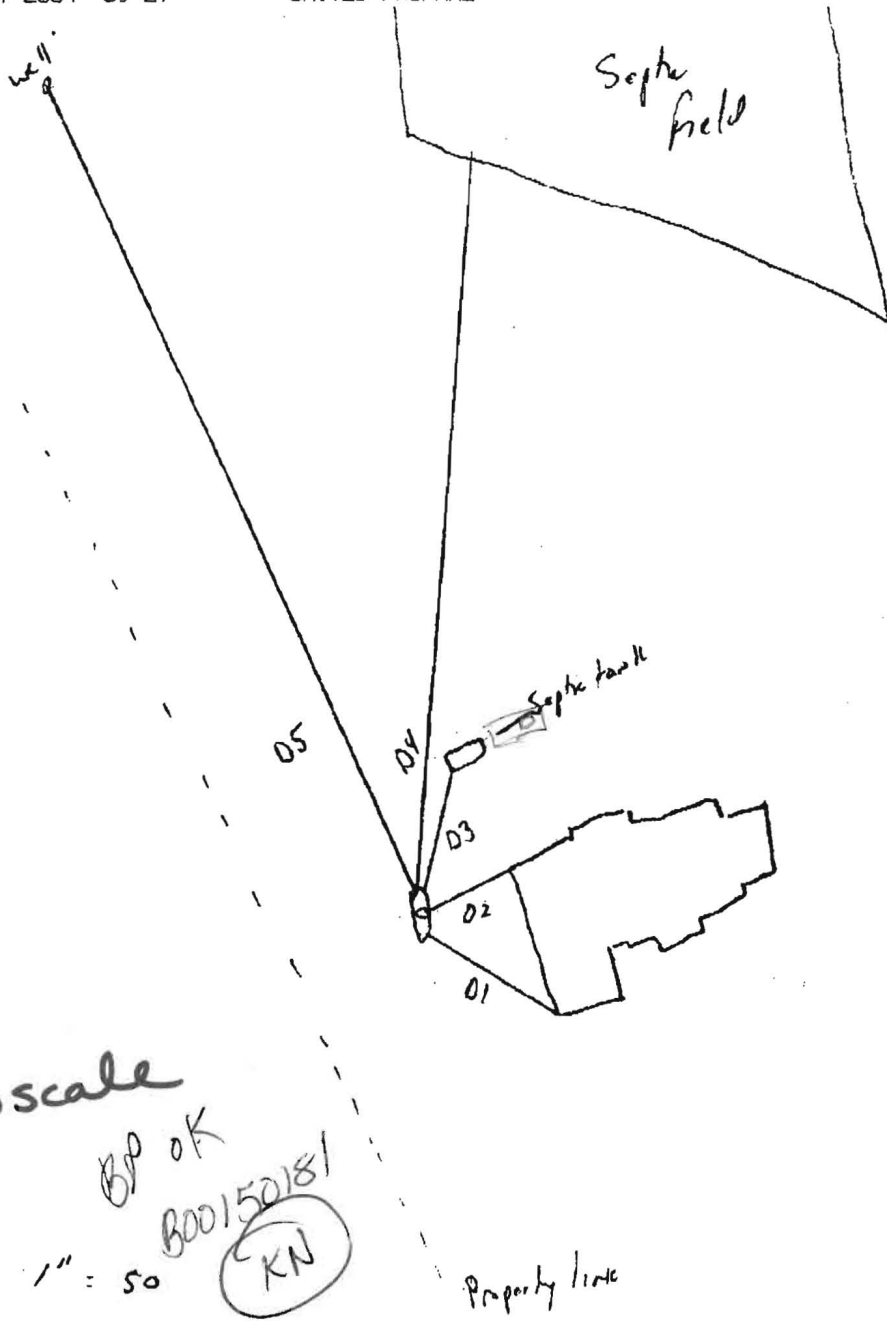

9/17/04
 Plan to scale

BP OK

Scale is 1" = 50'
 B00150181
 KN

Property line

12732 Lime Kiln Road

Highland Md. lot 37

- D1 From front to corner of House - 37'
- D2 " " " " " - 25'
- D3 " " " Septic tank - 37'
- D4 " " " " Easement - 220'
- D5 " " " Well - 230'