

C1 00506

SEQUENCE NO. (OEP USE ONLY)

STATE OF MARYLAND WELL COMPLETION REPORT

THIS REPORT MUST BE SUBMITTED WITHIN 45 DAYS AFTER WELL IS COMPLETED.

(THIS NUMBER IS TO BE PUNCHED IN COLS. 3-6 ON ALL CARDS)

COUNTY NUMBER

DATE RECEIVED

DATE WELL COMPLETED 05/19/86

DEPTH OF WELL (TO NEAREST FOOT) 175

PERMIT NO. FROM "PERMIT TO DRILL WELL" 40-81-1447

OWNER DEBESK QUENTIN last name first name TOWN FULTON LIME KILN VALLEY SECTION 1 LOT 2

WELL LOG table with columns: DESCRIPTION (Use additional sheets if needed), FEET (FROM, TO), Check if water bearing. Includes handwritten entries: Overburden, Shale + Earth, Gray Rock.

GROUTING RECORD: WELL HAS BEEN GROUTED (Y), TYPE OF GROUTING MATERIAL: CEMENT CM, BENTONITE CLAY BC, NO. OF BAGS 5, NO. OF POUNDS 500.

CASING RECORD: MAIN CASING TYPE ST, Nominal diameter 6 inches, Total depth of main casing 175 feet.

OTHER CASING (if used) table with columns: diameter inch, depth (feet) from, to.

SCREEN RECORD: screen type or open hole insert appropriate code below. Options: ST (STEEL), BR (BRASS), HO (OPEN HOLE), PL (PLASTIC), OT (OTHER).

SCREEN DEPTH (nearest ft.) table with columns for depth ranges (8-9, 11-15, 17-21, etc.) and handwritten values.

A WELL WAS ABANDONED AND SEALED WHEN THIS WELL WAS COMPLETED. ELECTRIC LOG OBTAINED. TEST WELL CONVERTED TO PRODUCTION WELL.

I HEREBY CERTIFY THAT THIS WELL HAS BEEN CONSTRUCTED IN ACCORDANCE WITH COMAR 10.17.13 "WELL CONSTRUCTION" AND IN CONFORMANCE WITH ALL CONDITIONS STATED IN THE ABOVE CAPTIONED PERMIT...

DRILLERS IDENT. NO., DRILLERS SIGNATURE, SITE SUPERVISOR (sign. of driller or journeyman responsible for sitework if different from permittee).

PUMPING TEST: HOURS PUMPED 3, PUMPING RATE 17.7 gal. per min., MEASURE PUMPING RATE SUBMERSIBLE, WATER LEVEL 43.37 before pumping, 86.27 when pumping.

PUMP INSTALLED: DRILLER WILL INSTALL PUMP YES NO, TYPE OF PUMP INSTALLED PLACE (A,C,J,P,R,S,T,O) IN BOX - SEE ABOVE: S (submersible).

LOCATION OF WELL ON LOT: SHOW PERMANENT STRUCTURE SUCH AS BUILDING, SEPTIC TANKS, AND/OR LANDMARKS AND INDICATE NOT LESS THAN TWO DISTANCES (MEASUREMENTS TO WELL).

GRAVEL PACK from to, IF WELL DRILLED WAS FLOWING WELL INSERT F IN BOX 68.

OEP USE ONLY (NOT TO BE FILLED IN BY DRILLER): T (E.R.O.S.), WQ, TELESCOPE CASING, LOG INDICATOR, OTHER DATA.

B 1 5396

SEQUENCE NO. (OEP USE ONLY)

STATE OF MARYLAND PERMIT TO DRILL WELL

please print or type

OEP PERMIT NUMBER

10-81-1449

(THIS NUMBER IS TO BE PUNCHED IN COLS. 3-6 ON ALL CARDS)

Date Received

7/27/86

OWNER INFORMATION

DOLEEK OVENTU, 3001 CRAY STATION, SILVER SPRING MD 20904

B 3

LOCATION OF WELL


HOWARD COUNTY, LIME KILN VALLEY, SECTION 44, LOT 48, NEAREST TOWN FULLY

DRILLER INFORMATION


Sonny D. Cochran, 6 EDGAR HARRIS SONS CORP, 12047 FACES RD, CHICKASSVILLE 21030

B 4

DIRECTION OF WELL FROM TOWN (CIRCLE BOX)

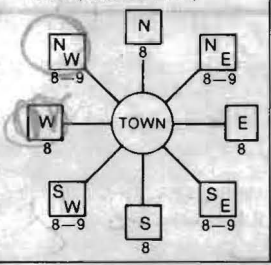

NEAR WHAT ROAD: BROWN BRIDGE RD, LIME KILN RD

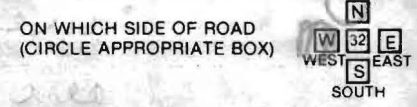

DISTANCE FROM ROAD: 200 FT

WELL INFORMATION

APPROX. PUMPING RATE (GAL. PER MIN.) 5, AVERAGE DAILY QUANTITY NEEDED (GAL. PER DAY) 50

USE FOR WATER (CIRCLE APPROPRIATE BOX)

- D HOME (SINGLE OR DOUBLE HOUSEHOLD UNIT ONLY), F FARMING (LIVESTOCK WATERING & AGRICULTURAL IRRIGATION), I INDUSTRIAL, COMMERCIAL, STATE AND FEDERAL GOV. OTHER (REQUIRES APPROPRIATION PERMIT), P PUBLIC OR PRIVATE WATER COMPANY (REQUIRES APPROPRIATION PERMIT AND STATE HEALTH DEPARTMENT APPROVAL), T TEST, OBSERVATION, MONITORING (MAY REQUIRE APPROPRIATION PERMIT)

NOT TO BE FILLED IN BY DRILLER HEALTH DEPARTMENT APPROVAL

COUNTY NAME HOWARD, COUNTY NO. A 33088, OEP SIGNATURE B. Nufem, DATE ISSUED 11/05/86, CO SIGNATURE, EXP. DATE

APPROXIMATE DEPTH OF WELL 200 FEET

APPROXIMATE DIAMETER OF WELL 6 INCH

METHOD OF DRILLING (circle one)

BORED (or Augered), JETTED, Jetted & DRIVEN, AIR-ROTary, AIR-PERCussion, ROTARY (Hydraulic Rotary), CABLE, REVERSE-ROTary, DRIVE-POINT

REPLACEMENT OR DEEPEMED WELLS (CIRCLE APPROPRIATE BOX)


- N THIS WELL WILL NOT REPLACE AN EXISTING WELL, Y THIS WELL WILL REPLACE A WELL THAT WILL BE ABANDONED AND SEALED, S THIS WELL WILL REPLACE A WELL THAT WILL BE USED AS A STANDBY, D THIS WELL WILL DEEPEN AN EXISTING WELL

SHOW MAJOR FEATURES OF BOX & LOCATE WELL WITH AN X

SOURCES OF DRILLING WATER

- 1., 2., 3.

WRITE THE BOX NUMBER FROM THE MAP HERE

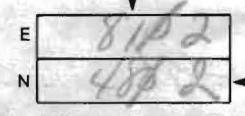

DRAW A SKETCH BELOW SHOWING LOCATION OF WELL IN RELATION TO NEARBY TOWNS AND ROADS AND GIVE DISTANCE FROM WELL TO NEAREST ROAD JUNCTION



Not to be filled in by driller (OEP USE ONLY)

APPROX. PERMIT NUMBER GAP, FORCE INITIALS IN BOX, PERMIT No. 10-81-1449

SPECIAL CONDITIONS

N  
WELL ABANDONMENT REPORT

DATE 4/13/92

Permit Number of abandoned well (if any) HO-81-1449

Driller's Name Mayne Joseph Mayne  
Last First

Owner's Name Potomac Electric Power  
Last First


Well Location:

County HOWARD  
Subdivision Line Kiln Valley Lot 2  
Section \_\_\_\_\_  
Nearest Town FULTON

Maryland Grid Location

E	810
N	480

Show well location with (X)

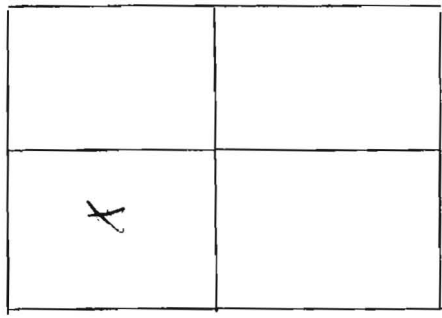

Type of Well

Drilled   
Jetted \_\_\_\_\_  
Bored or Augered \_\_\_\_\_  
Other, specify \_\_\_\_\_  
Depth of Well 165 Feet

Type of Casing

Steel   
Plastic \_\_\_\_\_  
Concrete \_\_\_\_\_  
Other, specify \_\_\_\_\_  
Size of casing 6 5/8 inches

Was any casing removed  Yes \_\_\_\_\_ No \_\_\_\_\_  
If yes, state amount removed 3ft.

Log of sealing material

<u>Material</u>	<u>Feet</u>	
	From	To
Cement + gravel	0	165'


Was casing ripped or perforated  
Yes \_\_\_\_\_ No

LIC 238





5/5/86

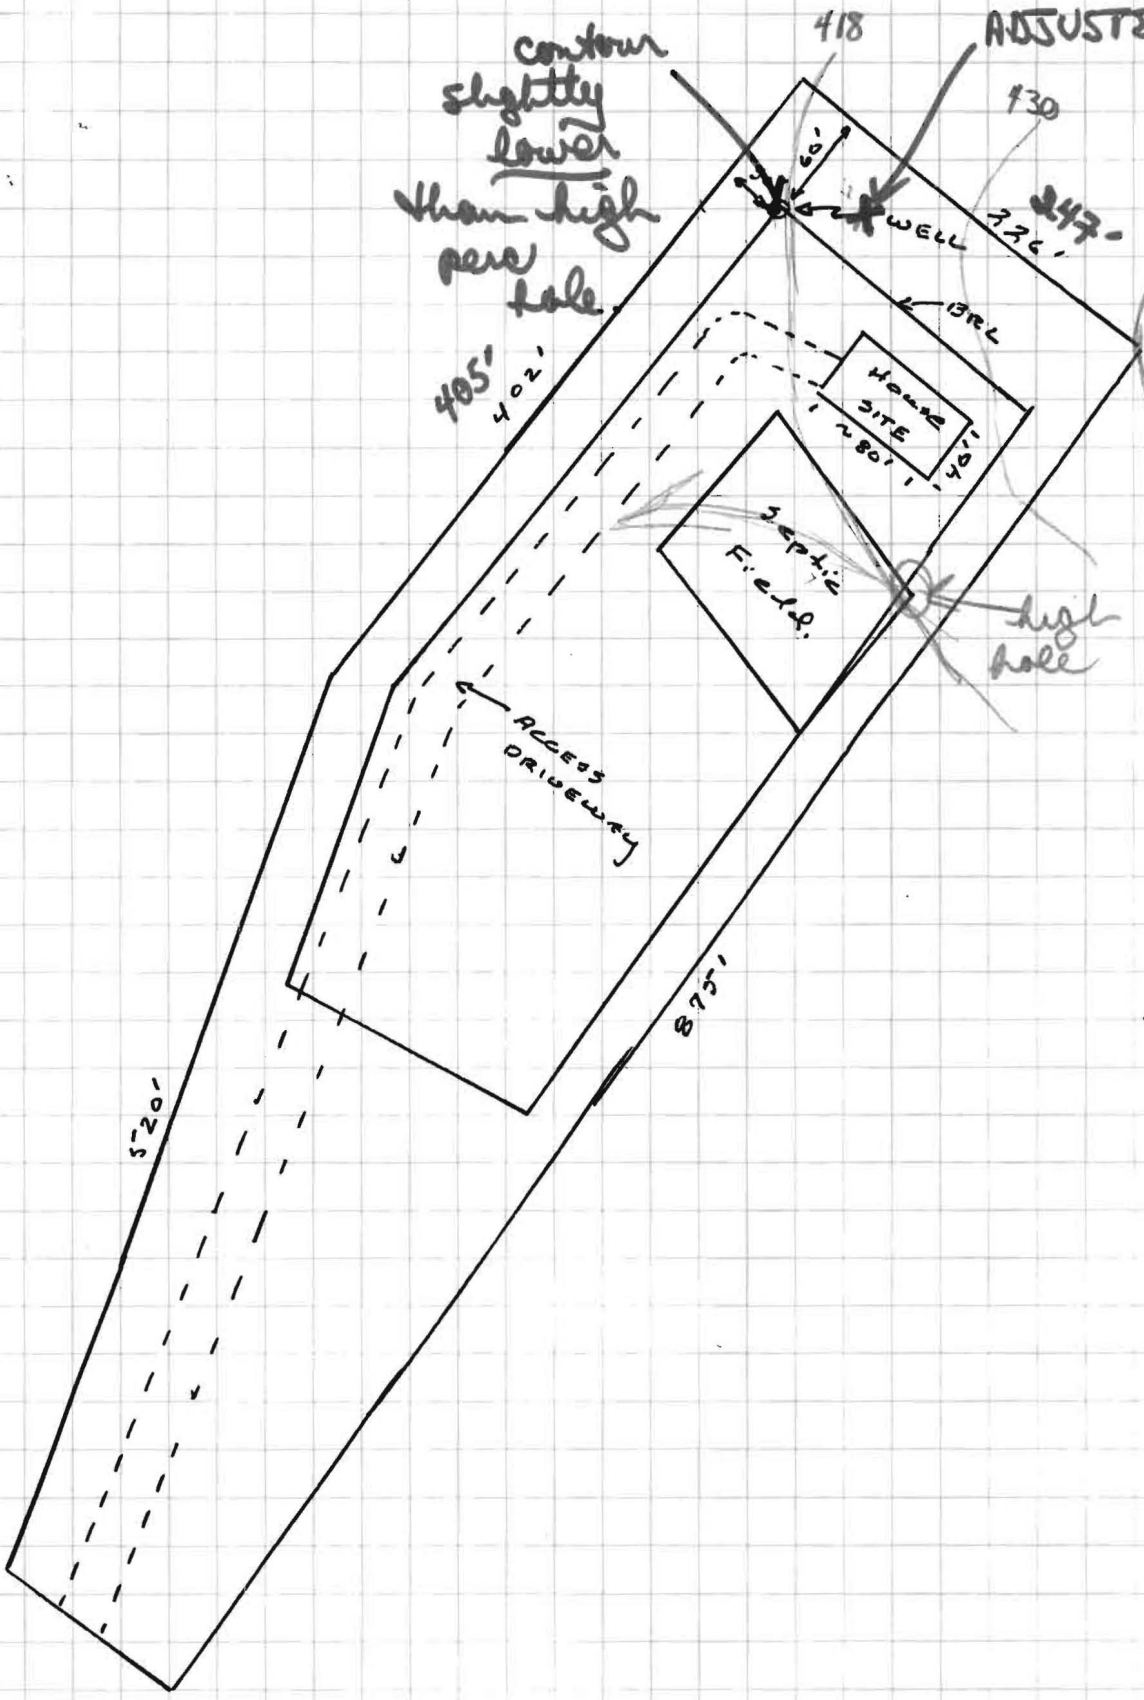

ADJUSTED WELL SITE  
 TO GET HIGHER  
 ELEVATION THAN  
 HOLE #2  
 60' OFF 405'  
 LINE  
 40' OFF 247'

LOT #2  
 SECTION 1  
 LIME KILN VALLEY

MAY 5, 1986  
 2. E. Dalech