

PUB. SEWER STATUS VERIFIED BY _____

ISSUE DATE: _____

APPROVAL DATE: _____

PERMIT INDEXED

P re-index

A 519872-H

ON-SITE SEWAGE DISPOSAL SYSTEM HOWARD COUNTY HEALTH DEPARTMENT BUREAU OF ENVIRONMENTAL HEALTH

04-310349

IS PERMITTED TO INSTALL ALTER

ADDRESS: _____ PHONE NUMBER: _____

SUBDIVISION: Chestnut Hills LOT NUMBER: Parcel R

ADDRESS: 1227 Long Corner Road PROPERTY OWNER: Earl Dunmeyer

SEPTIC TANK CAPACITY (GALLONS): _____

PUMP CHAMBER CAPACITY (GALLONS): _____

NUMBER OF BEDROOMS: _____

SQUARE FEET PER BEDROOM: _____

LINEAR FEET OF TRENCH REQUIRED: _____

TRENCHES:	Trench to be _____ feet wide. Inlet _____ feet below original grade. Bottom maximum depth _____ feet below original grade. Effective area begins at _____ feet below original grade. _____ feet of stone below distribution pipe.
LOCATION:	_____
PURPOSE:	_____

PLANS APPROVED: _____ DATE: _____

- NOTE: PERMIT VOID AFTER 2 YEARS
- NOTE: CONTRACTOR RESPONSIBLE FOR SCHEDULING A PRE-CONSTRUCTION INSPECTION FOR ALL INSTALLATIONS
- NOTE: WATERTIGHT SEPTIC TANKS REQUIRED
- NOTE: ALL PARTS OF SEPTIC SYSTEM SHALL BE 100 FEET FROM ANY WATER WELL
- NOTE: MANHOLE RISERS REQUIRED ON ALL SEPTIC TANKS AND PUMP CHAMBERS

**NEITHER THE HOWARD COUNTY COUNCIL NOR THE HEALTH DEPARTMENT IS
RESPONSIBLE FOR THE SUCCESSFUL OPERATION OF ANY SYSTEM
PERMITTEE RESPONSIBLE FOR OBTAINING FINAL APPROVAL ON THIS PERMIT
CALL 410-313-2640 FOR INSPECTION OF SEPTIC SYSTEM**

AS19872-H

PERMIT

SEWAGE DISPOSAL SYSTEM

19453

MARYLAND STATE DEPARTMENT OF HEALTH


HOWARD COUNTY

ELLICOTT CITY

DISTRICT 4th

DATE 9/17/75

INDEXED

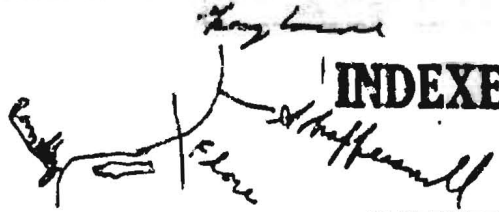

Harold Duvall

IS PERMITTED TO INSTALL ALTER

ADDRESS Damascus, Maryland

PHONE

A SEWAGE DISPOSAL SYSTEM LOCATED AT

SUBDIVISION (Chestnut Hills)

ROAD

1227

Long Corner Road

LOT

Parcel R

PROPERTY OWNER Leopard C. Martin

ADDRESS Route 1, Box 297-B, Mt. Airy, Md.

SPECIFICATIONS 4 bedrooms

DRAIN FIELD _____ DEPTH _____ FEET, BOTTOM AREA _____ SQ. FT.

SEEPAGE PITS _____ ABSORBENT SIDE-WALL AREA _____ SQ. FT.

SEPTIC TANK CAPACITY 1250 GALLONS

FOR GARBAGE GRINDER, INCREASE DISPOSAL AREA 22% & TANK CAPACITY 50%.

OTHER DRY WELL - 151 sq. ft. absorbent sidewall area per bedroom to begin below the first 5 ft. of original grade. Maximum depth permitted for dry well is 12 ft. below original grade. Place dry well 175 ft. from front lot line and 20 ft. from left side line as seen when facing from the front. If trench is desired - call office and get permission and size. Manhole type element to grade level.

MANHOLE IS FOR SEPTIC TANK IF TOP

NOTE: ALL PIPE FROM HOUSE TO DISPOSAL AREA MUST BE CAST IRON. PERMIT VOID AFTER THREE YEARS.

NOTE: INSTALL STAND PIPE ON SEPTIC TANK AND DRY WELL. STAND PIPES MUST BE 6 INCHES IN DIAMETER. CAST IRON, CONCRETE OR TERRA COTTA ACCEPTED.

PLANS APPROVED BY Donna W. Monaghan

DATE 2/28/74

SEPTIC TANK IS OVER 3 FT DEEP

FILL SEPTIC TANK AND DISTRIBUTION BOX WITH WATER BEFORE CALLING FOR AN INSPECTION. COVER NO WORK UNTIL INSPECTED AND APPROVED.

OR TRENCH 100 FT LONG 12 IN

NEITHER THE HOWARD COUNTY COMMISSIONERS NOR THE HEALTH DEPARTMENT IS RESPONSIBLE FOR THE SUCCESSFUL OPERATION OF ANY SYSTEM.

DEEP WITH 6 FT OF STONE 8 AT LEAST

1 1/2 FT WIDE. START TRENCH 175 FT FROM FRONT


& 20 FT FROM LEFT SIDE LINE AS SEEN WHEN FACIN

TRENCH TO FOLLOW CONTOUR OF GROUND

TWO INSPECTIONS OF TRENCH NEEDED

IF SEPTIC IS CHANGED BY AHT

19453

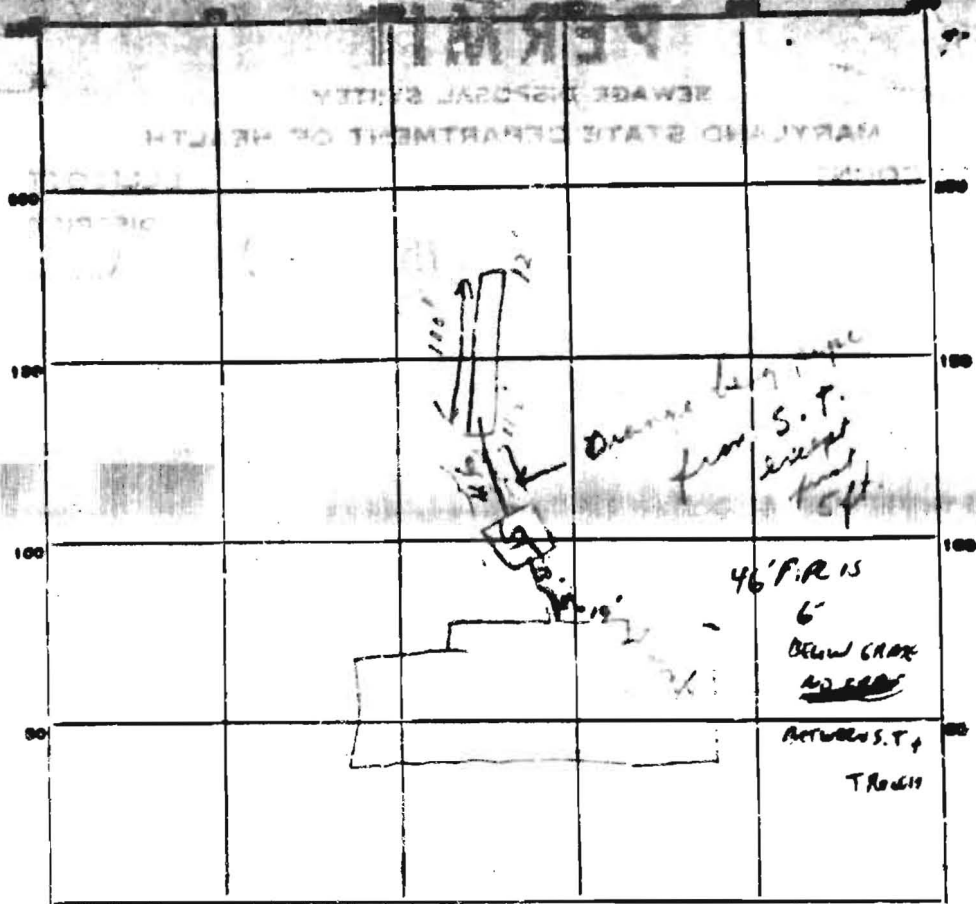

INDICATE NORTH - NAME ADJOINING ROADWAY AS BASE LINE.

Long Corner Road

PERMIT CARD 114-24 S.T. | D. Well

SEPTIC TANK, LEVEL _____ CLEANOUTS OK | OK

ALSO MANDOLE

DISTRIBUTION BOX, LEVEL _____

TILE FIELD, DEPTH 11 1/2 - 12 FT. TRENCH WIDTH 1 1/2 - 3 FT.

GRAVEL DEPTH 6 ft TOTAL LENGTH 100 FT.

NUMBER OF TRENCHES 1 Sidewall TOTAL BOTTOM AREA 600 sq ft

outside printer

SEEPAGE PITS, INSIDE DIAMETER _____ FT. DEPTH BELOW INLET _____ FT.

ABSORBENT AREA _____ SQ. FT.

REMARKS 9/18/75 *Water issues in basement in house*

1 *in for trench to have gravel only below*


Sept note to

replace every day with last run on ground 10/9/75 P.T.

11-3-75 mca hole under better cement job - open 5' area 11/3/75 Durr

DATE SYSTEM APPROVED 11/6/75

INSPECTOR W.D. Hargrave

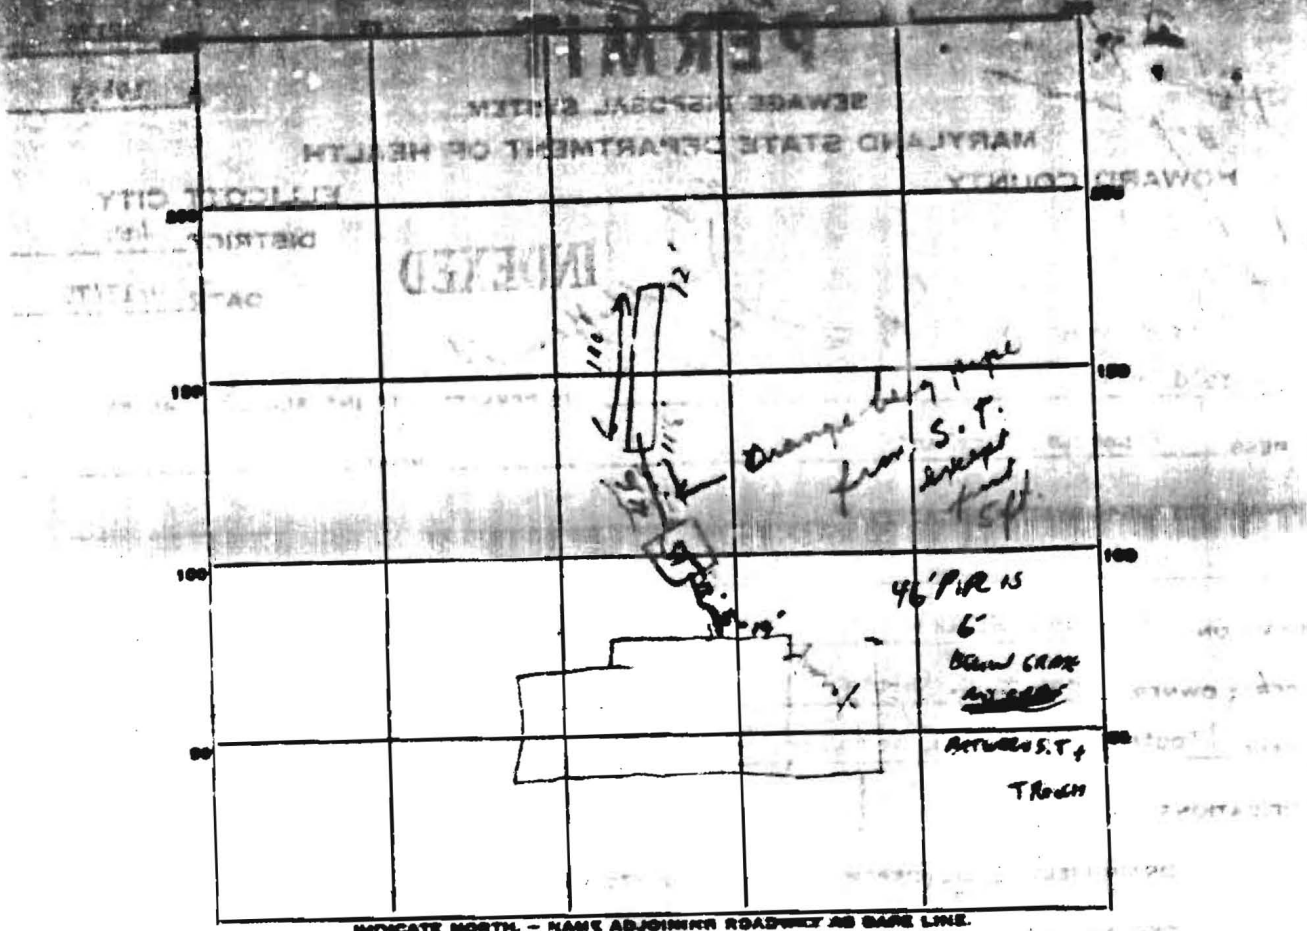

INDICATE NORTH - NAME ADJOINING ROADWAY AS BARE LINE.

Long Corner Road

PERMIT CARD 14420 S.T. / D. Well
 SEPTIC TANK, LEVEL _____ CLEARANCE OK / OK
 DISTRIBUTION BOX, LEVEL _____ ALSO MANHOLE
 TILE FIELD, DEPTH 11 1/2 - 12' FT. TRENCH WIDTH 1 1/2 - 3' FT.
 GRAVEL DEPTH 6 ft ' BE TOTAL LENGTH 100 FT.
 NUMBER OF TRENCHES 1 - Subsidiary TOTAL COVER AREA 600 sq ft
 SEE PAGE PITS, INSIDE DIAMETER _____ FT. DEPTH BELOW SILEY _____ FT.
 ABSORBENT AREA _____ SQ. FT.

REMARKS 9/18/75 Notes house basement use 2' x 2' Ct.
 ① ok for trench to have gravel only 11' x 12'
 Left note to replace assembly with lead wire on ground 10/21/75 P.T.
 11-2-75 man hole under better cement job - open 5:00 am 11/3/75 done

DATE SYSTEM APPROVED 11/6/75 INSPECTOR W. H. Hargrave