

APPLICATION

19453

SEWAGE DISPOSAL TESTING

STATE OF MARYLAND - DEPARTMENT OF HEALTH AND MENTAL HYGIENE

HOWARD COUNTY HEALTH DEPARTMENT
ENVIRONMENTAL HEALTH SERVICES

DISTRICT 6th

P. O. BOX 475, ELLICOTT CITY, MARYLAND 21043
TELEPHONE: 465-5000, EXT. 336

DATE 1/23/76

TO: THE COUNTY HEALTH OFFICER
ELLICOTT CITY, MARYLAND

I, HEREBY, APPLY FOR THE NECESSARY TEST IN ORDER TO CONSTRUCT (OR RECONSTRUCT) A SEWAGE DISPOSAL SYSTEM.

PROPERTY OWNER C. P. Magrove and E J. D. Bradshaw

ADDRESS 15714 Allnutt Lane, Burtonsville, Md. 20730 PHONE 301-6508

PROPERTY LOCATION:

SUBDIVISION (Chestnut Hills) LOT NO. Parcel R

ROAD AND DESCRIPTION Long Corner Road

SIZE OF LOT 5 acres TYPE BLDG. 3 of 4 bedrooms
NUMBER OF BEDROOMS

IF NOT SINGLE RESIDENCE DESCRIBE _____

THE SYSTEM INSTALLED UNDER THIS APPLICATION IS ACCEPTABLE ONLY UNTIL PUBLIC FACILITIES BECOME AVAILABLE.

SIGNATURE OF APPLICANT /s/ C. P. Magrove

APPROVED BY _____ FOR _____ DATE _____
(KIND OF SYSTEM)


REJECTED BY _____ FOR _____ DATE _____
(KIND OF SYSTEM)

HOLD PENDING FURTHER TESTS _____ DATE _____

REASONS FOR REJECTION OR HOLDING _____

THIS IS NOT A PERMIT

APPLICATION

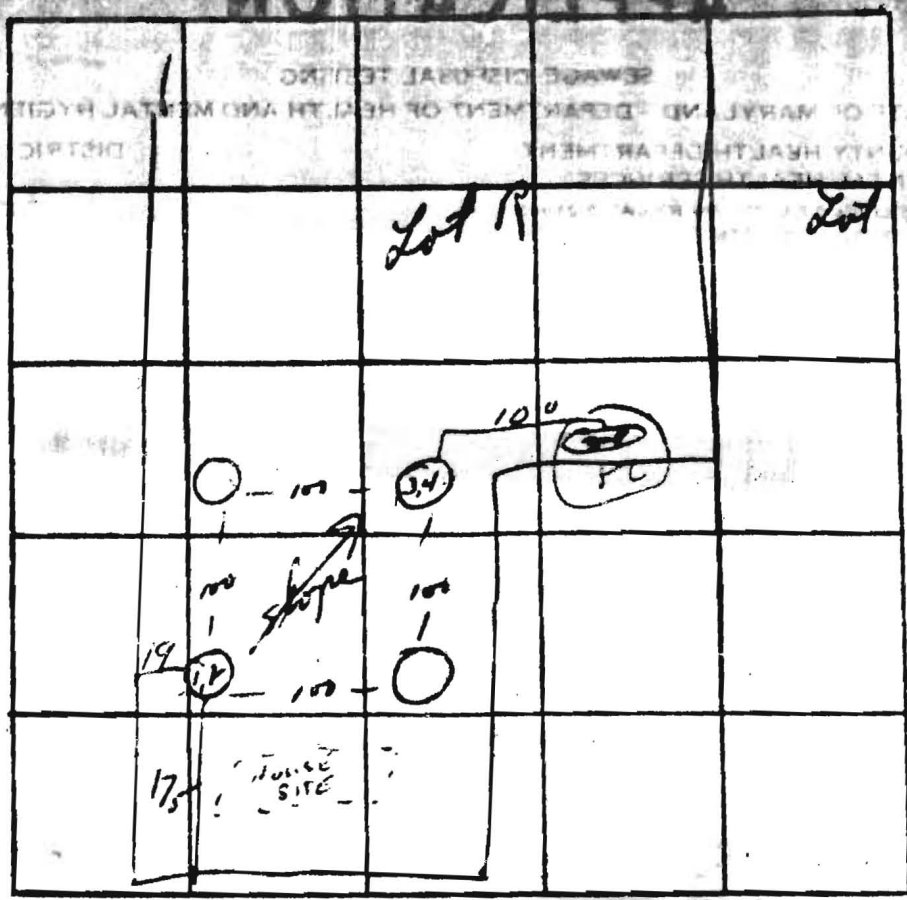

INDICATE NORTH - NAME ADJOINING PROPERTY AS BASE LINE

Long Corner Rd

DATE	TEST NO.	DEPTH	PRE-WET		TEST 1" DROP		TIME
			START	STOP	START	STOP	
1/27/74	1	4 1/2	2:58	3:16	3:16	3:42	26
	2	10 1/2	2:56	2:59	2:59	3:04	5
	3	6	3:20	---	---	3:40	NO PERC
	4	12	3:16	3:17	3:17	3:18	↓
2-1-74	5	12	10:02	10:03	10:03	10:05	2 1/4" W
	6	7'	10:02	10:10	10:10	10:15	SPIN
2-FM	7	12'	10:15	10:22	10:22	10:35	15" W
	8	6'	10:10	10:25	10:25	10:46	21" W

REMARKS: Just in 6' from jet (102) W/W

TYPE OF SOIL: _____

TESTED BY: WWZ & HSZ ALSO PRESENT: _____

Same
 as
 1-12-74