

MAC CLINTOCK  
ARC-263.44

50'

DRIVE

R=495.0'

272.65'

75'

82.0'

ⓔ


77.0'

77.0'

TO SHADY  
LANE

102.5'

10' UTILITY EASEMENT  
250.00'

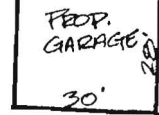


N25°07'50" W



9/16/98  
 Shown garage  
 addition will have  
 no impact to the  
 existing well or  
 septic

10' UTILITY EASEMENT  
 570°02'06" W 124.83'

DAVID STURGES LOT  
 LOT 10, BLOCK "B", SECT. 4  
 DIST. 4, HOWARD Co. MD.

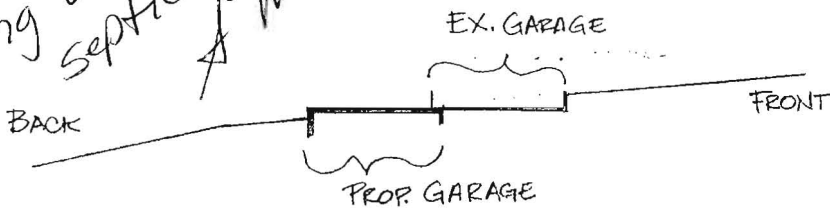

ELEVATION

Scale: 1"=40' Date: 9/10/98  
 DWN. BY: M.T.G.