

6/11/04 6/17/04 - Alter

PUB. SEWER STATUS VERIFIED BY _____

ISSUE DATE: 5/4/04

P 520339

APPROVAL DATE: 6/18/04

A REPAIR

PERMIT INDEXED

ON-SITE SEWAGE DISPOSAL SYSTEM HOWARD COUNTY HEALTH DEPARTMENT BUREAU OF ENVIRONMENTAL HEALTH

~~JV Harrison~~ Jet Septic IS PERMITTED TO INSTALL ALTER

ADDRESS: 4717 Old Washington Rd., Sykesville 21784 PHONE NUMBER: 410-795-7204

SUBDIVISION: _____ LOT NUMBER: _____

ADDRESS: 3465 Jennings Chapel Rd., Woodbine PROPERTY OWNER: Ralph Cordisco

SEPTIC TANK CAPACITY (GALLONS): Ex 1250

PUMP CHAMBER CAPACITY (GALLONS): 1500 comp tank

NUMBER OF BEDROOMS: 4

SQUARE FEET PER BEDROOM: 100

LINEAR FEET OF TRENCH REQUIRED: 150

TRENCHES:	Trench to be <u>2</u> feet wide. Inlet <u>6</u> feet below original grade. Bottom maximum depth <u>8</u> feet below original grade. Effective area begins at <u>6</u> feet below original grade. <u>2</u> feet of stone below distribution pipe.
LOCATION:	
PURPOSE:	Existing septic system has failed. Call for inspection when ground is opened so sanitarian can recommend repair.


PLANS APPROVED: [Signature] DATE: 5/7/04

- NOTE: PERMIT VOID AFTER 2 YEARS
- NOTE: CONTRACTOR RESPONSIBLE FOR SCHEDULING A PRE-CONSTRUCTION INSPECTION FOR ALL INSTALLATIONS
- NOTE: WATERTIGHT SEPTIC TANKS REQUIRED
- NOTE: ALL PARTS OF SEPTIC SYSTEM SHALL BE 100 FEET FROM ANY WATER WELL
- NOTE: MANHOLE RISERS REQUIRED ON ALL SEPTIC TANKS AND PUMP CHAMBERS

NEITHER THE HOWARD COUNTY COUNCIL OR THE HEALTH DEPARTMENT IS RESPONSIBLE FOR THE SUCCESSFUL OPERATION OF ANY SYSTEM PERMITTEE RESPONSIBLE FOR OBTAINING FINAL APPROVAL ON THIS PERMIT CALL 410-313-2640 FOR INSPECTION OF SEPTIC SYSTEM

P520339

NOT TO SCALE

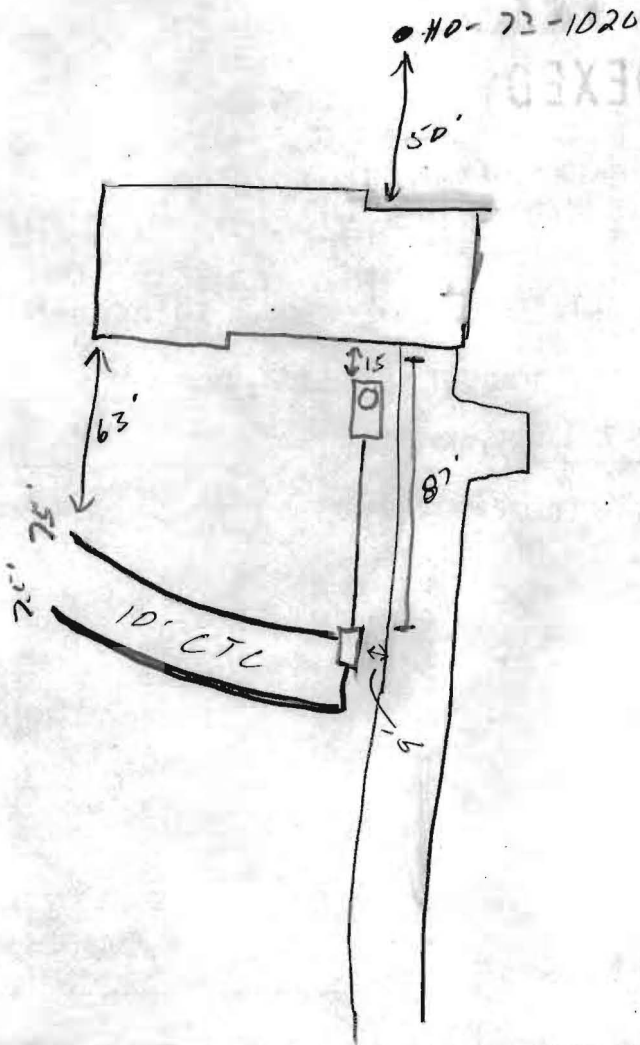

TRENCH/DRAINFIELD DATA		
WIDTH	INLET	BOTTOM
_____	_____	_____
NUMBER OF TRENCHES _____		
TOTAL LENGTH _____		
ABSORPTION AREA _____		
DISTRIBUTION BOX LEVEL _____		
DISTRIBUTION BOX BAFFLE _____		
DISTRIBUTION BOX PORT _____		

SEPTIC TANK DATA	
SEPTIC TANK 1 LEVEL _____	
CAPACITY _____	GAL
SEAM LOC _____	
TANK LID DEPTH _____	
BAFFLES _____	
BAFFLE FILTER _____	
MANHOLE LOC _____	
6" PORT LOC _____	
WATERTIGHT TEST _____	
SEPTIC TANK 2 LEVEL _____	
CAPACITY _____	GAL
SEAM LOC _____	
TANK LID DEPTH _____	
BAFFLES _____	
BAFFLE FILTER _____	
MANHOLE LOC _____	
6" PORT LOC _____	
WATERTIGHT TEST _____	

Jennings Chapel ROAD

PRE-CONSTRUCTION 6/11/04 - Met w/ Jet Septic. Dig up S.T.
 Shot outlet invert, can make P.B. by gravity.

INSTALLATION Install new baffle in tank. Pump collapse
~~fill in~~ P.W. (SO) 6/17/04 - Trench installed OK
to cover. No manhole on tank. Left red sticker (SO)
6/18/04 - Manhole installed (SO)

FINAL INSPECTOR [Signature] DATE OF APPROVAL 6/18/04