

C 1 3053 SEQUENCE NO. (WRA USE ONLY)
1 2 3 (SEQ. NO.) 4
(THIS NUMBER IS TO BE PUNCHED IN COLS. 3-9 ON ALL CARDS)

STATE OF MARYLAND
WATER RESOURCES ADMINISTRATION
TAWES STATE OFFICE BLDG., ANNAPOLIS, MD. 21401
WELL COMPLETION REPORT

THIS REPORT MUST BE SUBMITTED WITHIN 30 DAYS AFTER WELL COMPLETION

FILL IN THIS FORM COMPLETELY

COUNTY NUMBER A 17 808

DATE RECEIVED (WRA USE ONLY)
DATE WELL COMPLETED 2-15-75
19 20

DEPTH OF WELL 125
22 (TO NEAREST FOOT) 26

PERMIT NO. FROM "PERMIT TO DRILL WELL"
73-1020
28 29 30 31 32 33 34 35 36 37

DRILLERS IDENTIFICATION NO. 42

OWNER: Mc CONVILLE Hugh
LAST NAME FIRST NAME
STREET OR RFD 1525 IMPERIAL AVE. POST OFFICE BALTIMORE Md.

WELL DESCRIPTION

DESCRIPTION (USE ADDITIONAL SHEETS IF NECESSARY)	FEET FROM TO	CHECK IF WATER BEARING
Top Soil	0 2	
Shale	2 18	
Brown Slate	18 80 ✓	
Blue Slate	80 125	

7-1-75,
30' grout
65' case
15 bags cement
CBS

GROUTING RECORD

WELL HAS BEEN GROUTED (CIRCLE APPROPRIATE BOX)
 YES (Y) NO (N)
 24 44

TYPE OF GROUTING MATERIAL (CIRCLE BOX):
 CEMENT C M B C
 45 46 45 46

NO. OF BAGS 15 NO. OF POUNDS 1500
 GALLONS OF WATER 75

DEPTH OF GROUT SEAL (TO NEAREST FOOT)
 FROM 0 FT. TO 50 FT.
 48 52 54 58

CASING RECORD

CASING TYPES (INSERT APPROPRIATE CODE BELOW)
 S T STEEL C O CONCRETE
 P L PLASTIC O T OTHER

MAIN CASING TYPE S T NOMINAL DIAMETER OF MAIN CASING (NEAREST INCH) 6 TOTAL DEPTH OF MAIN CASING (NEAREST FOOT) 65
 60 61 63 64 66 70

OTHER CASING (IF USED):
 DIAMETER (INCH) DEPTH (FEET) FROM TO

SCREEN RECORD

SCREEN TYPE OR OPEN HOLE (INSERT APPROPRIATE CODE BELOW)
 S T STEEL B R BRASS OR BRONZE H O OPEN HOLE
 P L PLASTIC O T OTHER

C 2

DEPTH (NEAREST WHOLE FOOT) 125
 11 15 17 21
 23 24 26 30 32 36
 38 39 41 45 47 51

SLOT SIZE 1. 2. 3.

DIAMETER OF SCREEN 5 (NEAREST INCH)
 FROM 5 TO

GRAVEL PACK

IF WELL DRILLED WAS A FLOODING WELL (CIRCLE BOX) 68 F

PUMPING TEST

HOURS PUMPED (TO NEAREST HOUR) 1
 8 9

PUMPING RATE (GALLONS PER MINUTE TO NEAREST GALLON) 10
 11 15

METHOD USED TO MEASURE PUMPING RATE 1 Bucket

WATER LEVEL (DISTANCE FROM LAND SURFACE)
 BEFORE PUMPING 40 (NEAREST FOOT)
 17 20

WHEN PUMPING 125 (NEAREST FOOT)
 22 25

TYPE OF PUMP USED (CIRCLE APPROPRIATE BOX) (IF OR PUMPING TEST)
 A AIR P PISTON T TURBINE
 27 27 27
 C CENTRIFUGAL R ROTARY O OTHER (DESCRIBE BELOW)
 27 27 27
 J JET S SUBMERSIBLE
 27 27


PUMP INSTALLED

TYPE OF PUMP (WRITE APPROPRIATE LETTER IN BOX - SEE ABOVE: A, C, J, P, R, S, T, O)

DRILLER WILL INSTALL PUMP (CIRCLE APPROPRIATE BOX)
 YES (Y) NO (N)

CAPACITY:
 GALLONS PER MINUTE (TO NEAREST GALLON) 31 35
 PUMP HORSE POWER 37 41
 PUMP COLUMN LENGTH (NEAREST FOOT) 43 47

CASING HEIGHT (CIRCLE APPROPRIATE BOX AND ENTER CASING HEIGHT)
 + ABOVE LAND SURFACE (NEAREST FOOT) 2
 - BELOW 49 51

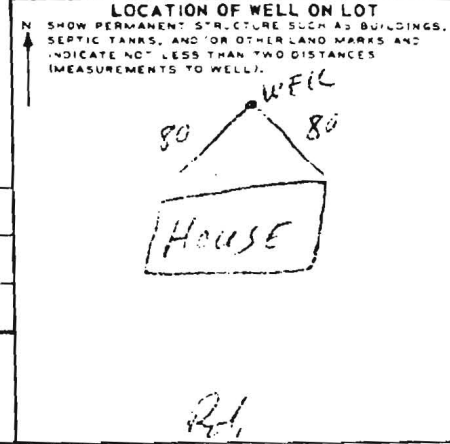

CIRCLE APPROPRIATE BOXES

A A WELL WAS ABANDONED AND SEALED WHEN THIS WELL WAS COMPLETED

E ELECTRIC LOG OBTAINED

P TEST WELL CONVERTED TO PRODUCTION WELL

HEREBY CERTIFY THAT I HAVE COMPLIED WITH ALL CONDITIONS STATED ON THE ABOVE-CAPTIONED "PERMIT TO DRILL WELL", AND THAT INFORMATION CONTAINED IN THIS REPORT IS TRUE, ACCURATE, AND COMPLETE TO THE BEST OF MY KNOWLEDGE, INFORMATION AND BELIEF.

DRILLERS NAME
 PLEASE PRINT
 SIGNATURE

WRA USE ONLY (NOT TO BE FILLED IN BY DRILLER)
 T TELESCOPE CASING 72 LOG INDICATOR W D 74 75 76 OTHER DATA AVAILABLE