

APPLICATION

A 17808

SEWAGE DISPOSAL TESTING

P _____

STATE OF MARYLAND - DEPARTMENT OF HEALTH AND MENTAL HYGIENE

HOWARD COUNTY HEALTH DEPARTMENT
ENVIRONMENTAL HEALTH SERVICES

DISTRICT 4

P. O. BOX 476, ELLICOTT CITY, MARYLAND 21043
TELEPHONE: 465-5000, EXT. 356

DATE 12/20/72

TO THE COUNTY HEALTH OFFICER
ELLICOTT CITY, MARYLAND

I, HEREBY, APPLY FOR THE NECESSARY TEST IN ORDER TO CONSTRUCT (OR RECONSTRUCT) A SEWAGE DISPOSAL SYSTEM.

PROPERTY OWNER Edwin Warfield, III
(Hugh J. McConville & wife - Contract Purchasers)
ADDRESS 1525 Ingleside Avenue, Baltimore, Md. 21207 PHONE 744-3247

PROPERTY LOCATION

SUBDIVISION Ed Warfield St LOT NO. 28

ROAD AND DESCRIPTION Jennings Chapel Road - Go to Daisy - use ED, WARFIELD Road
then turn onto Jennings Chapel Rod - 1/5 mile beyond Hipsley Mill Road

SIZE OF LOT 5,000 acres TYPE BLDG. 4
(Single Famly. Bldg.)

IF NOT SINGLE RESIDENCE DESCRIBE _____

THE SYSTEM INSTALLED UNDER THIS APPLICATION IS ACCEPTABLE ONLY UNTIL PUBLIC FACILITIES BECOME AVAILABLE.

SIGNATURE OF APPLICANT Hugh J. McConville


APPROVED BY _____ FOR _____ DATE _____
(KIND OF SYSTEM: _____)

REJECTED BY _____ FOR _____ DATE _____
(KIND OF SYSTEM: _____)

HOLD PENDING FURTHER TESTS _____ DATE _____

REASONS FOR REJECTION OR HOLDING _____

THIS IS NOT A PERMIT

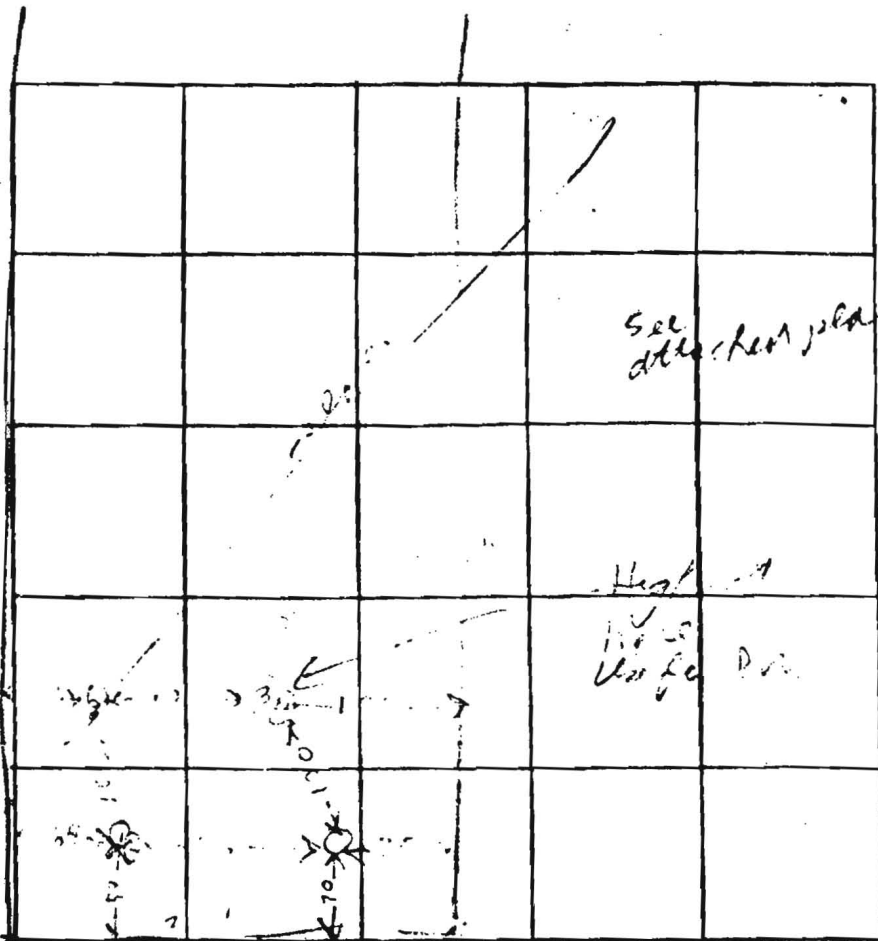

INDICATE NORTH - NAME ADJOINING ROADWAY AS BASE LINE

YENNIK, 34 CRABE 20

DATE	TEST NO.	DEPTH	PRE-WET		TEST - 1" DROP		TIME
			START	STOP	START	STOP	
5/14	1	12 1/2	1026	1100	1132	1104	
	2	12 1/2	1027	1037	1132	1142	9
	1A	12 1/2	1009	1057	1047	1100	13
	3	12	1054	1057	1058	1105	7
	4	5	1057	1105	1105	1112	13
	5	11	1057	1105	1105	1112	
	6	11	1057	1105	1105	1112	

PHYSICAL
ANALYSIS

REMARKS _____

TYPE OF SOIL _____

TESTED BY R. Bridges ALSO PRESENT _____