

PUB. SEWER STATUS VERIFIED BY mlb / Rumba

4/20/04
9:30-10:00

4/30/04 All Day

Done in P.M.

ISSUE DATE: 4/16/04

**PERMIT
INDEXED**

P 520306

APPROVAL DATE: 4/30/04

A REPAIR

**ON-SITE SEWAGE DISPOSAL SYSTEM
HOWARD COUNTY HEALTH DEPARTMENT
BUREAU OF ENVIRONMENTAL HEALTH**

Hatfield's Equipment IS PERMITTED TO INSTALL ALTER

ADDRESS: 13785 Burntwoods Rd PHONE NUMBER: 301-854-6172

SUBDIVISION: Benson LOT NUMBER: 4

ADDRESS: 3513 Lakeway Drive PROPERTY OWNER: Theresa Coufal

SEPTIC TANK CAPACITY (GALLONS): Existing (2) 90'-100' Trenches

PUMP CHAMBER CAPACITY (GALLONS): N/A Inlet 5.5'

NUMBER OF BEDROOMS: 5 Bottom 10.0'

SQUARE FEET PER BEDROOM: 180 4.5' of Stone

LINEAR FEET OF TRENCH REQUIRED: 180'-200' Trenches 2' Wide

Pump and Fill Old Dry Wells


TRENCHES:	Trench to be _____ feet wide. Inlet _____ feet below original grade. Bottom maximum depth _____ feet below original grade. Effective area begins at _____ feet below original grade. _____ feet of stone below distribution pipe.
LOCATION:	
PURPOSE:	Existing septic system has failed. Call for inspection when ground is opened so sanitarian can recommend repair.

PLANS APPROVED: _____ DATE: _____

- NOTE: PERMIT VOID AFTER 2 YEARS
- NOTE: CONTRACTOR RESPONSIBLE FOR SCHEDULING A PRE-CONSTRUCTION INSPECTION FOR ALL INSTALLATIONS
- NOTE: WATERTIGHT SEPTIC TANKS REQUIRED
- NOTE: ALL PARTS OF SEPTIC SYSTEM SHALL BE 100 FEET FROM ANY WATER WELL
- NOTE: MANHOLE RISERS REQUIRED ON ALL SEPTIC TANKS AND PUMP CHAMBERS

NEITHER THE HOWARD COUNTY COUNCIL OR THE HEALTH DEPARTMENT IS RESPONSIBLE FOR THE SUCCESSFUL OPERATION OF ANY SYSTEM PERMITTED RESPONSIBLE FOR OBTAINING FINAL APPROVAL ON THIS PERMIT CALL 410-313-2640 FOR INSPECTION OF SEPTIC SYSTEM

P 520306

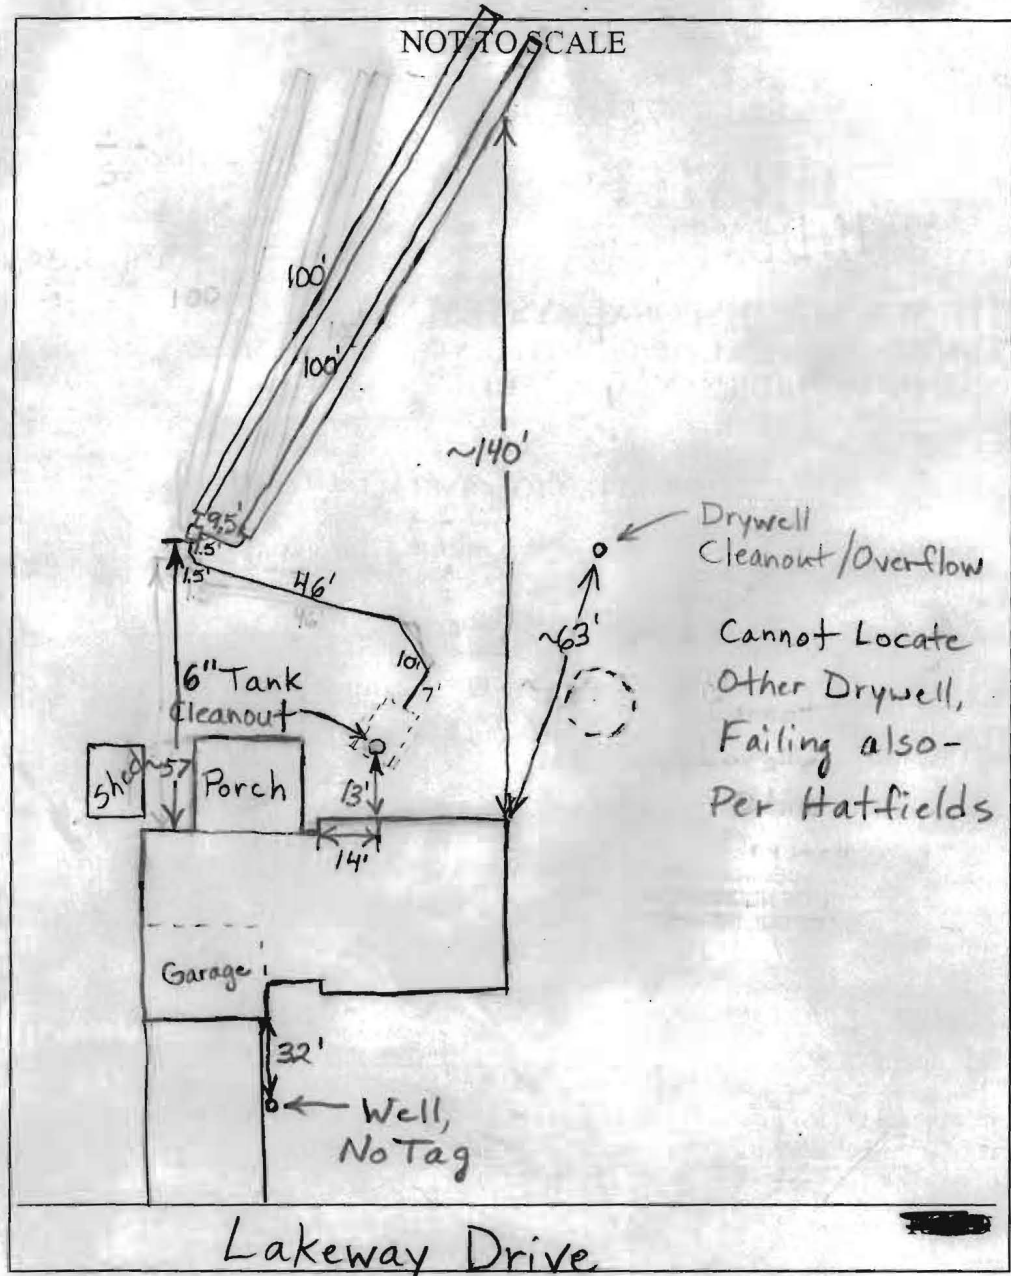

TRENCH/DRAINFIELD DATA		
WIDTH	INLET	BOTTOM
_____	_____	_____
NUMBER OF TRENCHES _____		
TOTAL LENGTH _____		
ABSORPTION AREA _____		
DISTRIBUTION BOX LEVEL _____		
DISTRIBUTION BOX BAFFLE _____		
DISTRIBUTION BOX PORT _____		

SEPTIC TANK DATA	
SEPTIC TANK 1 LEVEL _____	
CAPACITY _____	GAL
SEAM LOC _____	
TANK LID DEPTH _____	
BAFFLES _____	
BAFFLE FILTER _____	
MANHOLE LOC _____	
6" PORT LOC _____	
WATERTIGHT TEST _____	
SEPTIC TANK 2 LEVEL _____	
CAPACITY _____	GAL
SEAM LOC _____	
TANK LID DEPTH _____	
BAFFLES _____	
BAFFLE FILTER _____	
MANHOLE LOC _____	
6" PORT LOC _____	
WATERTIGHT TEST _____	

PRE-CONSTRUCTION 4/20/04 To install (2) 90'-100' trenches in the area of holes A+B (see the perc. test sheet). A new INSTALLATION distribution box will have to be installed. Pump out and fill in the two existing drywells. (BB)

4/30/04 Both drywells pumped out and filled in. First trench finished. Second trench almost done. O.K. to cover all work. (BB)

FINAL INSPECTOR B. Baber DATE OF APPROVAL 4/30/04