

3584 KATASHLEY CT

A 520408-4  
KINGSTON, LOT 6

# APPLICATION

A 13377

SEWAGE DISPOSAL TESTING

P \_\_\_\_\_

MARYLAND STATE DEPARTMENT OF HEALTH

HOWARD COUNTY

ELLICOTT CITY

DISTRICT 3

DATE 12-8-67

TO: THE COUNTY HEALTH OFFICER  
ELLICOTT CITY, MARYLAND

I, HEREBY, APPLY FOR THE NECESSARY TESTS IN ORDER TO CONSTRUCT (OR RECONSTRUCT) A SEWAGE DISPOSAL SYSTEM.

PROPERTY OWNER James W. King, Sr.

ADDRESS 304 Freetown Road PHONE 286-2757

PROPERTY LOCATION:

SUBDIVISION Kingston (J. W. King) LOT NO. 6 Area 2

ROAD AND DESCRIPTION Tridelphia Road  
Glenc, Maryland

OCCUPANT \_\_\_\_\_ PHONE \_\_\_\_\_

PERSON TO CONSTRUCT SYSTEM \_\_\_\_\_

ADDRESS \_\_\_\_\_ PHONE \_\_\_\_\_

SIZE OF LOT 285 x 160 1 Acres TYPE BLDG. 3  
NUMBER OF BEDROOMS

IF NOT SINGLE RESIDENCE DESCRIBE \_\_\_\_\_

SIGNATURE OF APPLICANT James W. King Sr.


APPROVED BY \_\_\_\_\_ FOR \_\_\_\_\_ DATE \_\_\_\_\_  
(KIND OF SYSTEM)

REJECTED BY \_\_\_\_\_ FOR \_\_\_\_\_ DATE \_\_\_\_\_  
(KIND OF SYSTEM)

HOLD PENDING FURTHER TESTS \_\_\_\_\_ DATE \_\_\_\_\_

REASONS FOR REJECTION OR HOLDING \_\_\_\_\_

## THIS IS NOT A PERMIT

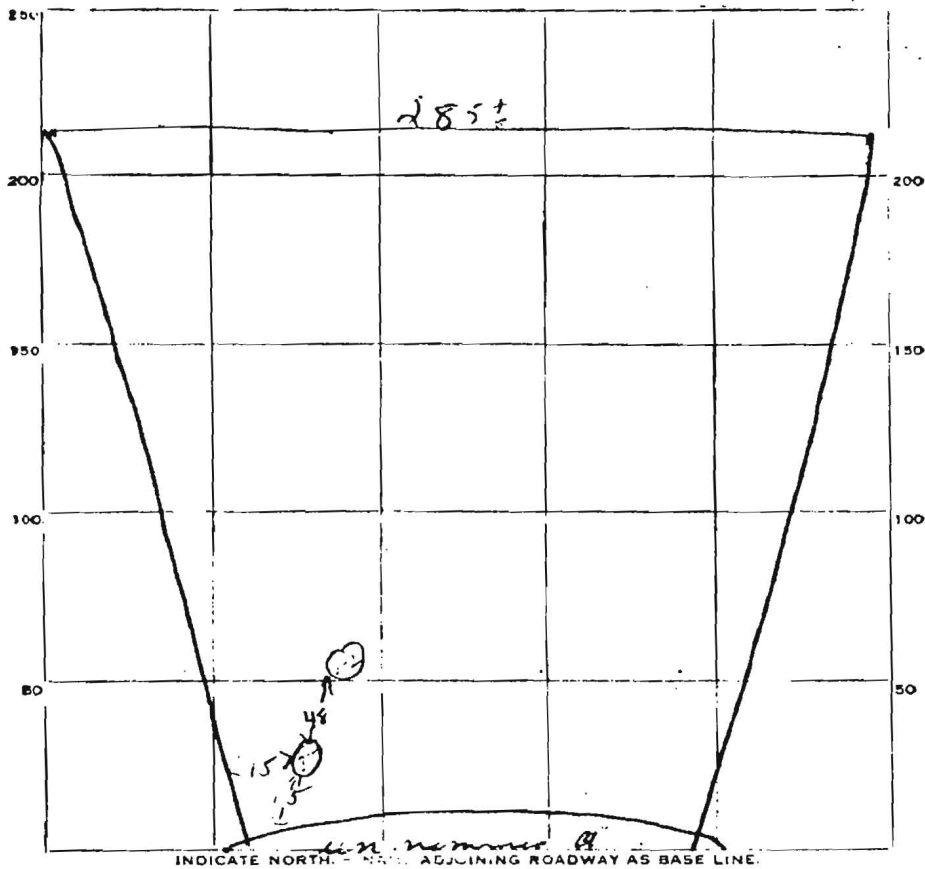

DATE	TEST NO.	DEP 4	PRE-WET		TEST - 1" DROP		TIME
			START	STOP	START	STOP	
4/14/59	1	4 ft	2 50	2 52	2 52	2 58	6 min
"	2	10 1/2	2 50	2 53	2 53	2 59	6 min
	3	4 ft	2 57	3 00	3 00	3 06	6 min
	4	9 1/2	2 57	3 59	2 59	3 01	3 min

$\frac{5.5}{12.70}$   
 5.25  
 4


SOIL AUGER FINDING \_\_\_\_\_

TESTED BY WLT

REMARKS under shells with 11' road cut

Lot 55

A13377

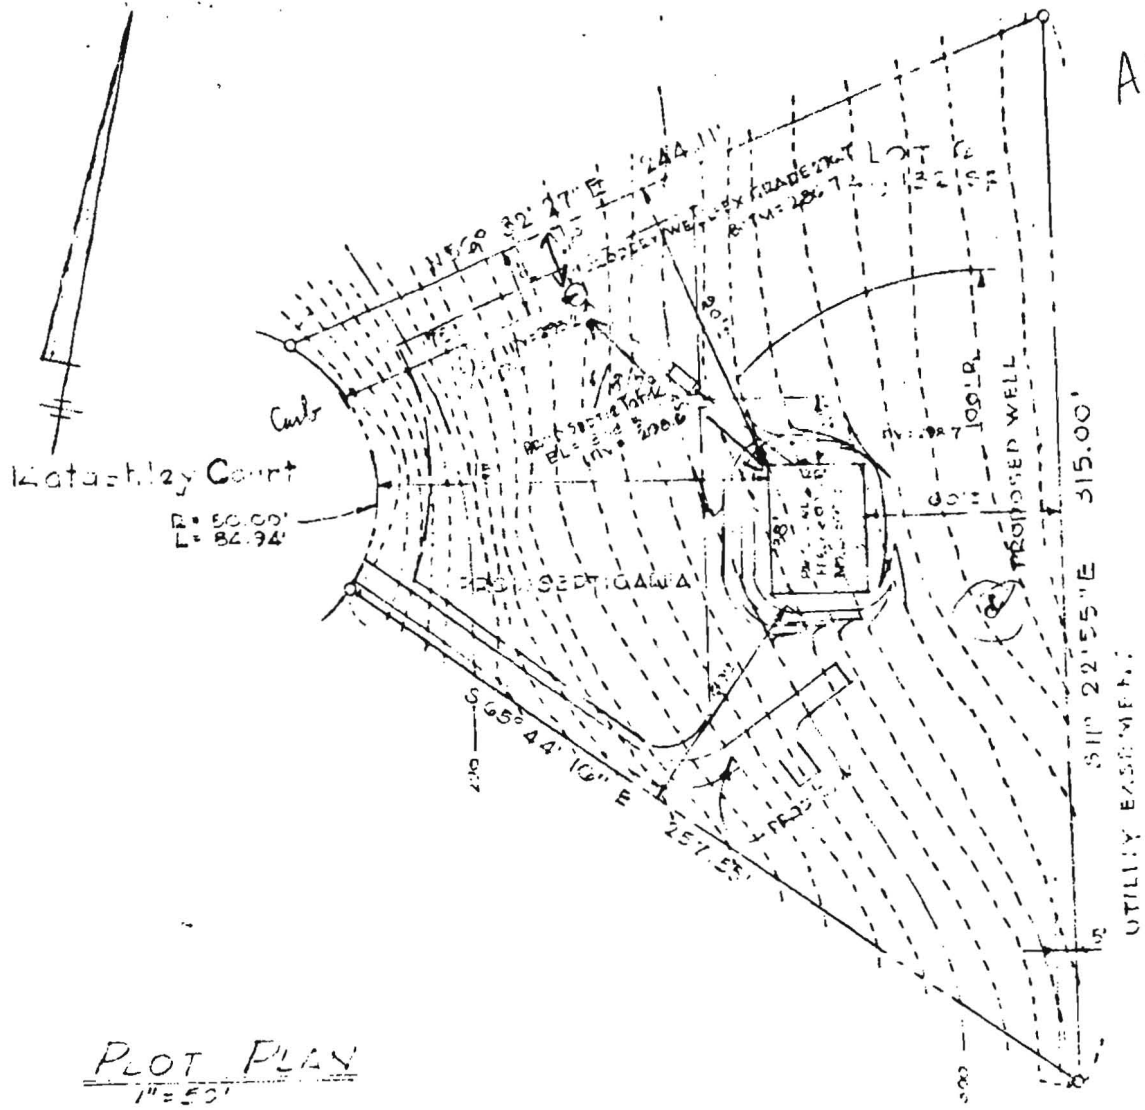


6' x 12' x 12'  
 13' x 12'  
 Hold  
 for septic  
 tank  
 per owner  
 in approximate  
 area no  
 C.B.D.  
 is concerned

PLOT PLAN  
 1" = 50'

MRS. WILLIAM A. CONWAY  
 LOT 2 SECT ON TWO LATACHLEY COURT  
 "WILMINGTON"  
 THIRD ELECTION DISTRICT - WARD 30 AND

I CERTIFY THE ABOVE MEASUREMENTS ARE TRUE AND CORRECT  
 SIGNED BY ME OR BY AN ASSISTANT ENGINEER

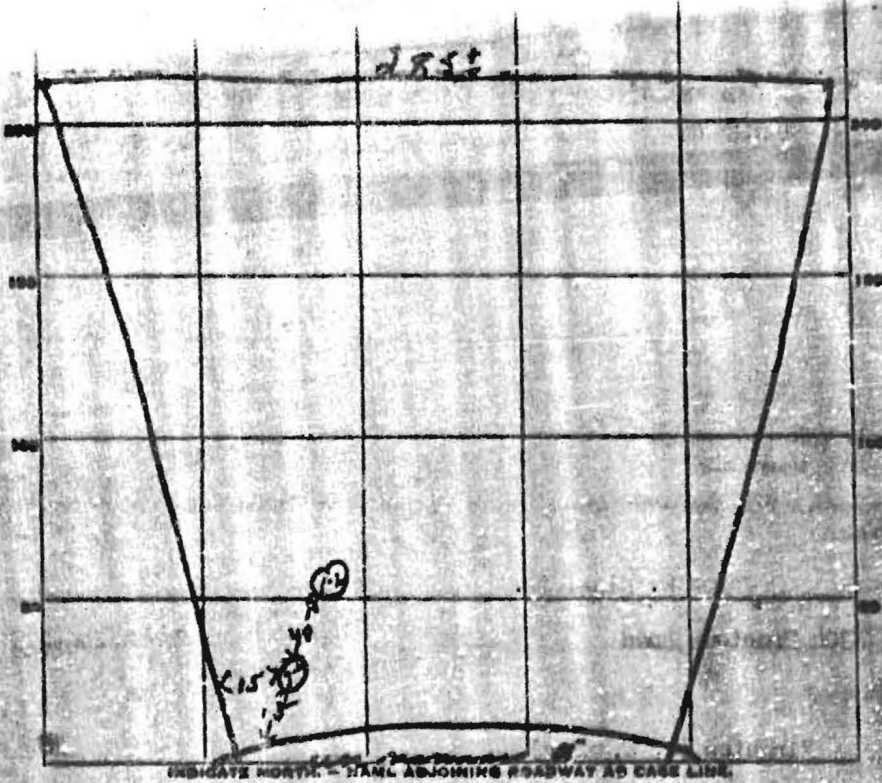

DATE	TEST NO.	DEPTH	PRE-WET		TEST - 1" DROP		TIME
			START	STOP	START	STOP	
7/19/64	1	4 ft	2 50	2 52	2 52	2 54	6 min
	2	10 1/2	2 53	2 53	2 53	2 53	6 min
	3	4 ft	2 57	2 58	2 58	2 58	6 min
	4	9 1/2	2 57	2 59	2 59	2 59	6 min

53  
52  
52  
4

SOIL AUGER FINDING

TESTED BY *[Signature]*

REMARKS *made shall be 1/3 max depth*

06105

SEWAGE DISPOSAL TESTING

P \_\_\_\_\_

MARYLAND STATE DEPARTMENT OF HEALTH

HOWARD COUNTY

ELLCOTT CITY

DISTRICT 3

DATE 12-8-67

TO: THE COUNTY HEALTH OFFICER  
ELLCOTT CITY, MARYLAND

I, HEREBY, APPLY FOR THE NECESSARY TESTS IN ORDER TO CONSTRUCT (OR RECONSTRUCT) A SEWAGE DISPOSAL SYSTEM.

PROPERTY OWNER JAMES W. KING, JR.

ADDRESS 306 Franklin Road PHONE 286-2757

PROPERTY LOCATION:

SUBDIVISION Kingston (J. W. King) LOT NO. 2

ROAD AND DESCRIPTION Tridelpia Road  
Glavels, Maryland

OCCUPANT \_\_\_\_\_ PHONE \_\_\_\_\_

PERSON TO CONSTRUCT SYSTEM \_\_\_\_\_

ADDRESS \_\_\_\_\_ PHONE \_\_\_\_\_

SIZE OF LOT 285 x 160 1 2 TYPE BLDG. 3 NUMBER OF RESIDENCES

IF NOT SINGLE RESIDENCE DESCRIBE \_\_\_\_\_

SIGNATURE OF APPLICANT James W. King, Jr.

APPROVED BY \_\_\_\_\_ FOR \_\_\_\_\_ DATE \_\_\_\_\_

REJECTED BY \_\_\_\_\_ FOR \_\_\_\_\_ DATE \_\_\_\_\_

HOLD PENDING FURTHER TESTS \_\_\_\_\_ DATE \_\_\_\_\_

REASONS FOR REJECTION OR HOLDING \_\_\_\_\_

**THIS IS NOT A PERMIT**