

APPROVED
 WALK-THRU BUILDING PERMIT
 BP# 82052991 A# B20408 B
 APP. SAN Rose DATE: 3/31/05
 DESC. OF WORK: garage
no plumbing



E mail: surveyassociates@erols.com

LOCATION
 MORTGAGE
 SURVEY

SURVEY ASSOCIATES OF MARYLAND

4905 SUDLEY RD

WEST RIVER MARYLAND 20778

TEL 410 266 7211

FAX 410 266 0918

FAX BALTIMORE 410 841 6150

FAX METRO DC 301 970 2514

BHOZ-84-53-3584 KATASHLEY C. FILLICOTT CITY HOW 5/11/02 ADVAN Case#2563



 

Fema Panel: 240044 0021B
Flood Zone: C
LOT 6 BLK A
SEC 2 KINGSTON
BOOK: 22
Folio: 42
Dist: 3
Co: HOWARD
MD
Scale 1"=30'

5/26/04
A13377
BP# 00148454

Based on age of exist system,
perc rates indicate sandy soils
Not adding additional rooms inside,
and septic system pumped Dec 2002,
Deck permit Approved (KN)

Large Lots: Boundaries on larger lots may not all be inspected.
Accuracy: Approximate average accuracy (SD of sideline distances) for small suburban lots is two feet, and for large lots and metes and bounds parcels varies from two feet to twenty feet. In case of doubt, we recommend a Boundary Survey.

LEGEND

Shed (unsurveyed)  Blacktop Drive 
Gravel Drive  Concrete 

This is an improvements Location Survey only, and must not be used for Boundary purposes. No Title Report furnished. No statement is made as to ownership of property or right or interest therein. Fences are approximate only and may not be shown. *Not to be used for construction purposes or permits of any kind whatsoever.*




E mail: surveyassociates@erols.com

LOCATION
MORTGAGE
SURVEY

SURVEY ASSOCIATES OF MARYLAND


4905 SUDLEY RD
WEST RIVER MARYLAND 20778
TEL 410 266 7211 FAX 410 266 0918
FAX BALTIMORE 410 841 6150
FAX METRO DC 301 970 2514

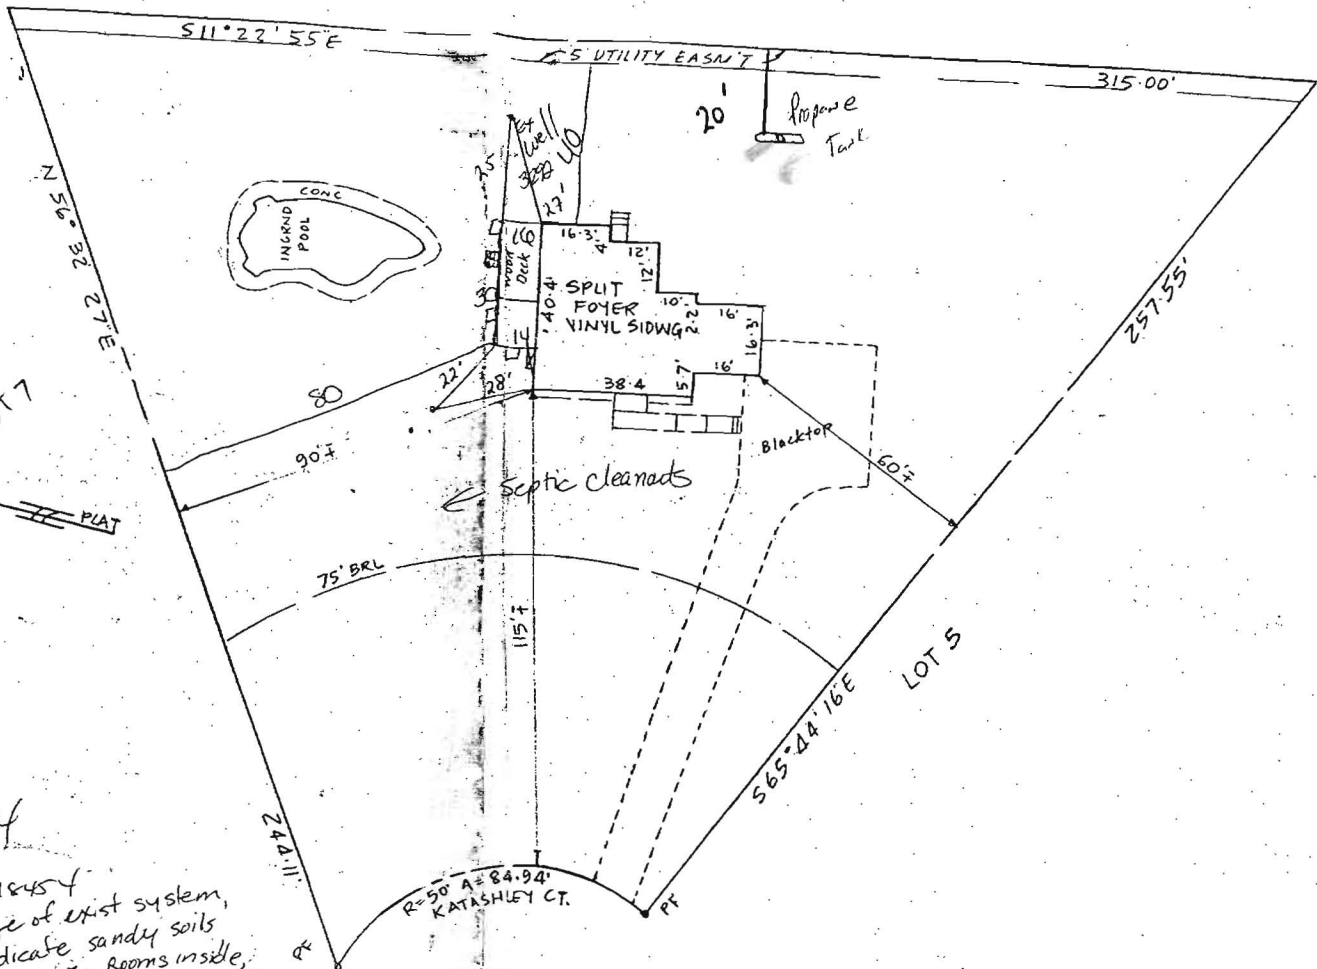

A13377

BH02-84-53 3584 KATASHLEY C. MELLICOTT CITY HOW 6/11/02 ADVAN Case#2563
 Fema Panel: 240044 0021B
 Flood Zone: C
 LOT 6 BLK A
 SEC 2 KINGSTON
 Book: 22
 Folio: 42
 Dist: 3
 Co: HOWARD
 MD
 Scale 1" = 30'

A13377

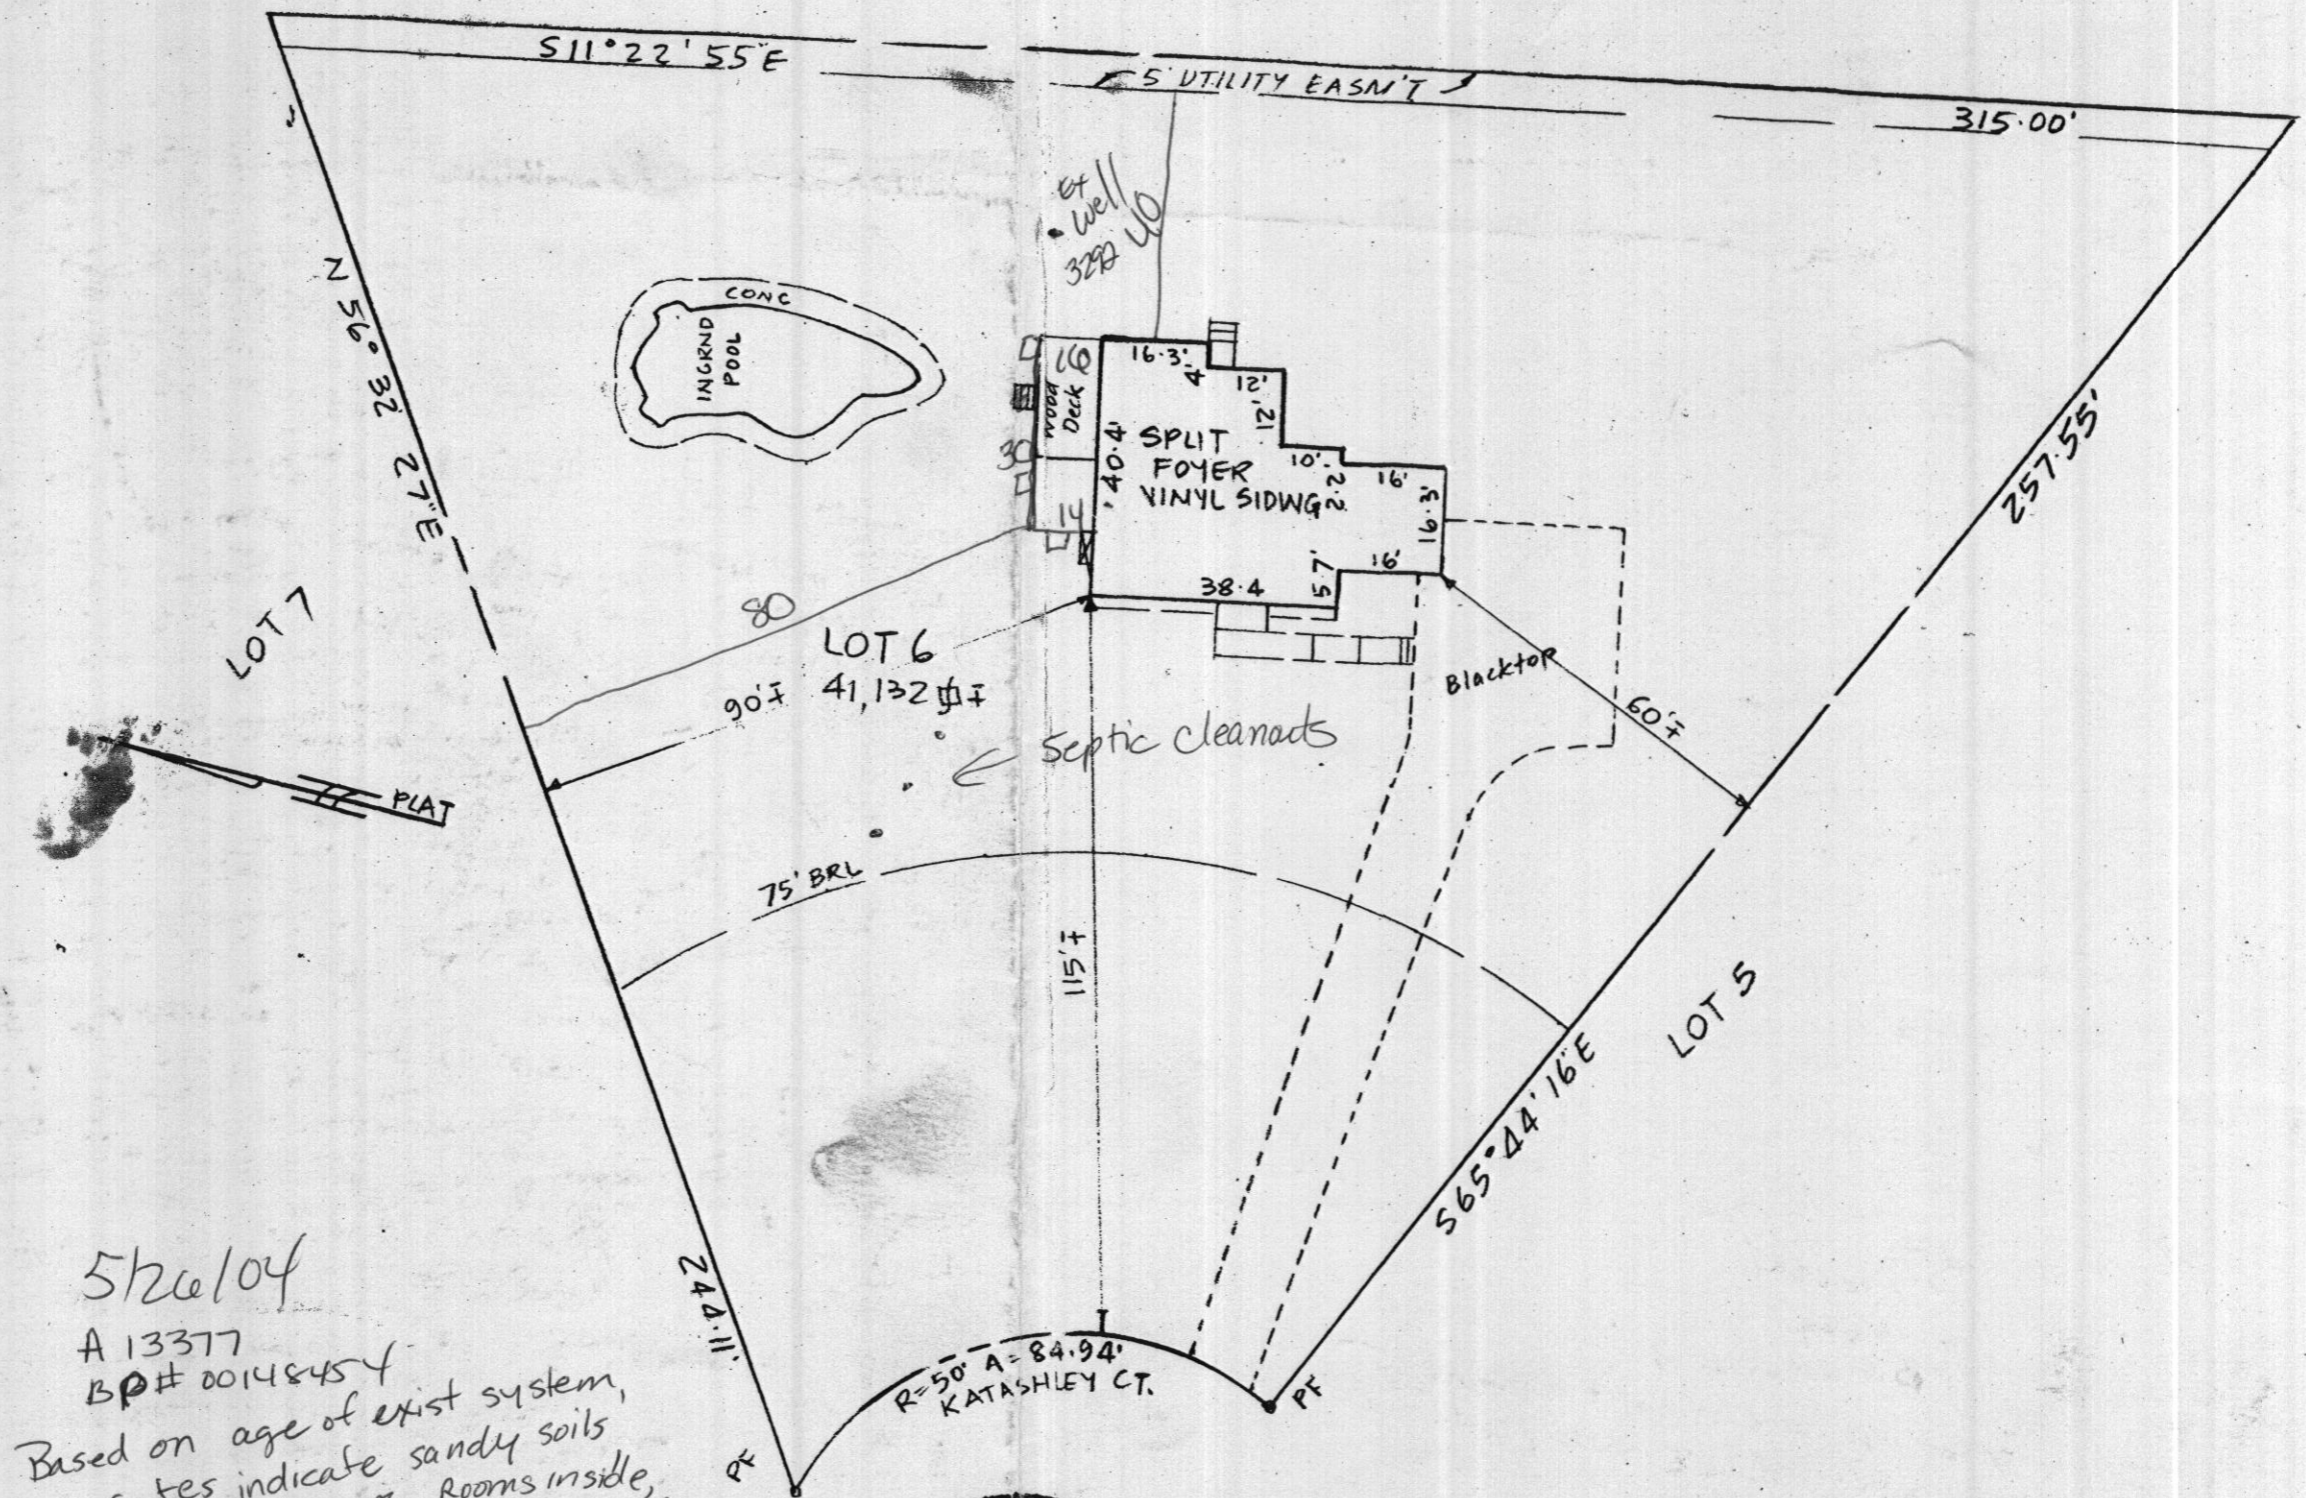

5/26/04
 A13377
 BP# 00148454
 Based on age of exist system,
 perc rates indicate sandy soils
 Not adding additional rooms inside
 and septic system pumped Dec 2002,
 Deck permit approved (KN)

Large Lots: Boundaries on larger lots may not all be inspected.
 Accuracy: Approximate average accuracy (SD of sideline distances) for small suburban lots is two feet, and for large lots and metes and bounds parcels varies from two feet to twenty feet. In case of doubt, we recommend a Boundary Survey.

LEGEND
 Shed (unsurveyed) Blacktop Drive
 Gravel Drive Concrete

This is an improvements Location Survey only, and must not be used for Boundary purposes. No Title Report furnished. No statement is made as to ownership of property or right or interest therein. Fences are approximate only and may not be shown. *Not to be used for construction purposes or permits of any kind whatsoever.*



E mail: surveyassociates@erols.com

LOCATION
 MORTGAGE
 SURVEY

SURVEY ASSOCIATES OF MARYLAND
 4905 SUDLEY RD
 WEST RIVER MARYLAND 20778
 TEL 410 266 7211 FAX 410 266 0918
 FAX BALTIMORE 410 841 6150
 FAX METRO DC 301 970 2514