

PERMIT

P. 22447

A. 20389

SEWAGE DISPOSAL SYSTEM

MARYLAND STATE DEPARTMENT OF HEALTH

HOWARD COUNTY

ELLICOTT CITY

DISTRICT 5th

DATE 11/5/75

INDEXED

THE SYSTEM UNDER THIS PERMIT IS ACCEPTABLE ONLY UNTIL PUBLIC FACILITIES BECOME AVAILABLE.

12/11/75
12/12/75
after 2 PM - final approval G.S.

Pat Lendrim _____ IS PERMITTED TO INSTALL ALTER _____

ADDRESS 14010 Forsythe Road, Sykesville, Maryland PHONE 442-2416

A SEWAGE DISPOSAL SYSTEM LOCATED AT _____

SUBDIVISION Riverside Estates ROAD 10840 Hunting Lane LOT 1, Block G

PROPERTY OWNER Residential Developers, Inc. Don and Carol Reynolds

ADDRESS P. O. Box 700, Seabrook, Md. 20801 Phone: 531-5225

SPECIFICATIONS 4 bedrooms

DRAIN FIELD _____ DEPTH _____ FEET, BOTTOM AREA _____ SQ. FT.

SEEPAGE PITS _____ ABSORBENT SIDE-WALL AREA _____ SQ. FT.

SEPTIC TANK CAPACITY 1250 GALLONS

FOR GARBAGE GRINDER, INCREASE DISPOSAL AREA 22% & TANK CAPACITY 50%.

OTHER TRENCHES - The sewage disposal area will consist of two trenches running parallel to the contour of the land, 10 ft. deep with 7 ft. of stone. The higher trench will be 40 ft. long and the lower one will be 35 ft. long. The higher trench will begin at a point 25 ft. off of the left property line as seen from the road and 85 ft. in from the rear property line. The lower trench will run parallel to the higher trench and 20 ft. away edge to edge. Two inspections will be required. All measurements for depth are from original grade. Manhole type cleanout to grade required on septic tank. NOTE: ALL PIPE FROM HOUSE TO DISPOSAL AREA MUST BE CAST IRON. PERMIT VOID AFTER THREE YEARS. NOTE: INSTALL STAND PIPE ON SEPTIC TANK. STAND PIPES MUST BE 6 INCHES IN DIAMETER. CAST IRON, CONCRETE OR TERRA COTTA ACCEPTED.

PLANS APPROVED BY Robert T. Moorefield DATE 4/9/75

FILL SEPTIC TANK AND DISTRIBUTION BOX WITH WATER BEFORE CALLING FOR AN INSPECTION. COVER NO WORK UNTIL INSPECTED AND APPROVED.


NEITHER THE HOWARD COUNTY COMMISSIONERS NOR THE HEALTH DEPARTMENT IS RESPONSIBLE FOR THE SUCCESSFUL OPERATION OF ANY SYSTEM.

ok to put dry well 25' from left side of house

BLDG. PERMIT SIGNED
RETURNED 10/23/91
Serial #44056
2-level deck

A 20389

20389

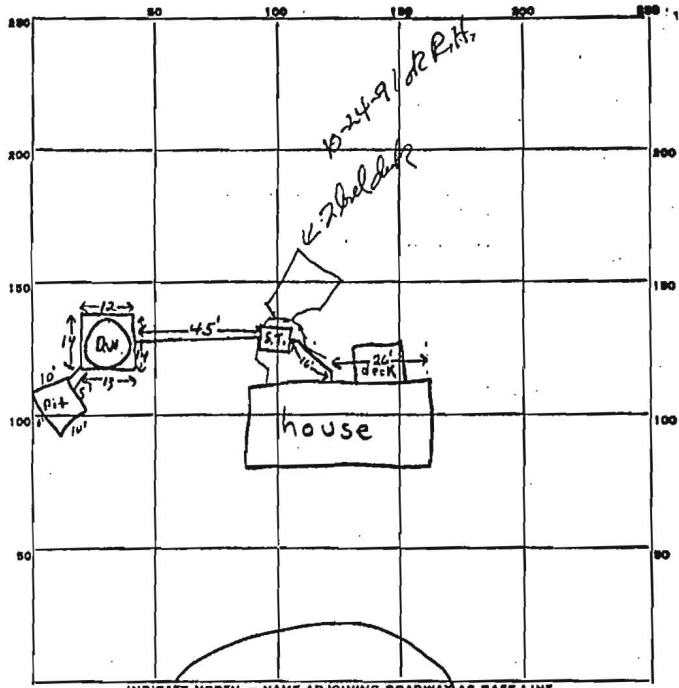

Revised St.
16

INDICATE NORTH. - NAME ADJOINING ROADWAY AS BASE LINE.
Hunting Lane

PERMIT CARD signed final cover all work S.T. | D.W

SEPTIC TANK, LEVEL CLEANOUTS

DISTRIBUTION BOX, LEVEL _____

TILE FIELD, DEPTH _____ FT. TRENCH WIDTH _____ FT.

GRAVEL DEPTH _____ IN. TOTAL LENGTH _____ FT.

NUMBER OF TRENCHES 1 TOTAL BOTTOM AREA 175 sq ft
Perimeter 10' x 5' x 10' x 5' = 6' deep

PERIMETER
SEEPAGE PITS, INSIDE DIAMETER 53 FT. DEPTH BELOW INLET 6.5 FT.

ABSORBENT AREA ±512 SQ. FT.

REMARKS 12/11/75 Still needs ~28-30 ft of trench @ 6' x 6 1/2' of gravel F.S.

12/12/75 Pit wording to make up extra needed @ O.K. F.S.

DATE SYSTEM APPROVED 12/12/75 INSPECTOR Fr. Skinner