

APPLICATION

sub # 17

19728

SEWAGE DISPOSAL TESTING

STATE OF MARYLAND - DEPARTMENT OF HEALTH AND MENTAL HYGIENE

HOWARD COUNTY HEALTH DEPARTMENT
ENVIRONMENTAL HEALTH SERVICES

P. O. BOX 476, ELLICOTT CITY, MARYLAND 21043
TELEPHONE: 468-2000, EXT. 386

DISTRICT

5th
2-25-74

DATE

*at the
system
and for
bill.*
@ Long well to house 16' of pipe effective
absorbent sidewall area of 3' x 3'
below inlet. Inlet to be 3'
grade and maximum depth.
per engineer's plan

1-3 bedrooms in golden
bedroom
below original
11' location

TO THE COUNTY HEALTH OFFICER
ELLICOTT CITY, MARYLAND

3' of dry well to be used and:

I, HEREBY, APPLY FOR THE NECESSARY TEST IN ORDER TO CONSTRUCT (OR RECONSTRUCT) A SEWAGE
DISPOSAL SYSTEM.

Oscar Schultz Inc.

0 5' sec. 7 in. pipe for pit
dry well & trench

PROPERTY OWNER *Apple Development Company, Inc.*

(2) 2 manholes at trench

ADDRESS *110 ...
Bor 145 ...
Sydney, Md. 21784*

PHONE *301/874-2835*

PROPERTY LOCATION *Highland Lake
Henry K. Gwings Property*

18 in.

SUBDIVISION _____ LOT NO. *lot 162-Phase 1*

ROAD AND DESCRIPTION *0640 ...
Crown Road ...*

SIZE OF LOT *33,000 sq ft*

TYPE BLDG.

3-4 B.R.

NUMBER OF BEDROOMS

IF NOT SINGLE RESIDENCE DESCRIBE _____

N/A

THE SYSTEM INSTALLED UNDER THIS APPLICATION IS ACCEPTABLE ONLY UNTIL PUBLIC
FACILITIES BECOME AVAILABLE.

SIGNATURE OF APPLICANT

Robert A. Kuhn

APPROVED BY

[Signature]

FOR

[Signature]

DATE

1/1

(KIND OF SYSTEM)

REJECTED BY _____

FOR _____

DATE _____


(KIND OF SYSTEM)

HOLD PENDING FURTHER TESTS _____

DATE _____

REASONS FOR REJECTION OR HOLDING _____

THIS IS NOT A PERMIT

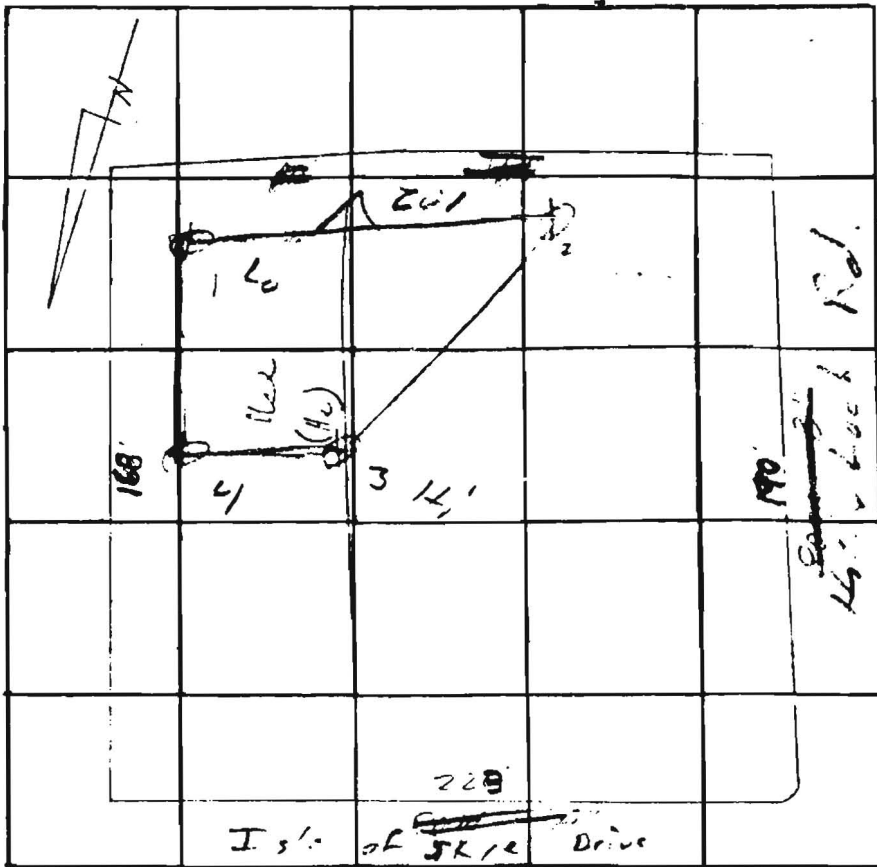

18
Lot
102
(near)

l = 11
3 ft

INDICATE NORTH - NAME ADJOINING ROADWAY AS BASE LINE

DATE	TEST NO.	DEPTH	PRE-WET		TEST DROP		TIME
			START	STOP	START	STOP	
4/4	1	3	1 48	1 50	1 55	1 57	1
	1A	11	1 51	1 53	1 57	1 59	3
	2	10	Vis				
4/4	3	3	1 56	1 58	1 58	2 00	11
	3A	11	1 58	1 59	2 02	2 09	11
	4	10	no	by	lower		

= 17
160 yft.

near to 3
7 min
July 5

REMARKS no dry from top down

TYPE OF SOIL R. M. K. T.