

LAYOUT \_\_\_\_\_ INSP 4 \_\_\_\_\_  
INSP 2 \_\_\_\_\_ INSP 5 \_\_\_\_\_  
INSP 3 \_\_\_\_\_ INSP 6 \_\_\_\_\_

ISSUE DATE: 11/22/05

APPROVAL DATE: 3/23/06

# PERMIT

## INDEXED

TAX ID #04-323696

P 523716

A 520785

**ON-SITE SEWAGE DISPOSAL SYSTEM  
HOWARD COUNTY HEALTH DEPARTMENT  
BUREAU OF ENVIRONMENTAL HEALTH**

G+S BUILDERS

IS PERMITTED TO INSTALL  ALTER

ADDRESS: 3517 FALLING GREEN RD PHONE NUMBER: 301-806-9086

SUBDIVISION: Mullinix Property LOT NUMBER: \_\_\_\_\_

ADDRESS: 1510 Long Corner Road PROPERTY OWNER: Jeffrey Schultz

SEPTIC TANK CAPACITY (GALLONS): 1500 OUTLET BAFFLE FILTER REQUIRED

PUMP CHAMBER CAPACITY (GALLONS) n/a COMPARTMENTED TANK REQUIRED

NUMBER OF BEDROOMS: 3

SQUARE FEET PER BEDROOM: 210

LINEAR FEET OF TRENCH REQUIRED: 130 HOUSE SERVED BY PUBLIC WATER


TRENCHES:	Trench to be 3.0 feet wide. Inlet 4.0 feet below original grade. Bottom maximum depth 7.0 feet below original grade. Effective area begins at 5.0 feet below original grade. 3.0 feet of stone below distribution pipe.
LOCATION:	Install the septic system exactly as shown on the approved building permit plan.
NOTES:	Aqua Safe to be installed per manufacturer's specifications. No more than three (3) bedrooms allowed for this lot.

PLANS APPROVED: Michael Davis Reviewed by: \_\_\_\_\_ DATE: 11/23/05

NOTES: PERMIT VOID AFTER 2 YEARS  
CONTRACTOR IS RESPONSIBLE FOR SCHEDULING A PRE-CONSTRUCTION INSPECTION FOR ALL INSTALLATIONS  
WATERTIGHT SEPTIC TANKS REQUIRED  
ALL PARTS OF SEPTIC SYSTEM SHALL BE 100 FEET FROM ANY WATER WELL UNLESS SPECIFICALLY AUTHORIZED  
MANHOLE RISERS REQUIRED ON ALL SEPTIC TANKS AND PUMP CHAMBERS UNLESS SPECIFICALLY AUTHORIZED  
CONTRACTOR RESPONSIBLE FOR COMPLIANCE WITH APPLICABLE REGULATIONS, GUIDELINES AND THE TERMS OF THIS PERMIT

**NEITHER THE HOWARD COUNTY COUNCIL NOR THE HEALTH DEPARTMENT IS  
RESPONSIBLE FOR THE SUCCESSFUL OPERATION OF ANY SYSTEM  
PERMITTEE RESPONSIBLE FOR OBTAINING FINAL APPROVAL ON THIS PERMIT  
ALL 410-313-1771 FOR INSPECTION OF SEPTIC SYSTEM**

NOT TO SCALE

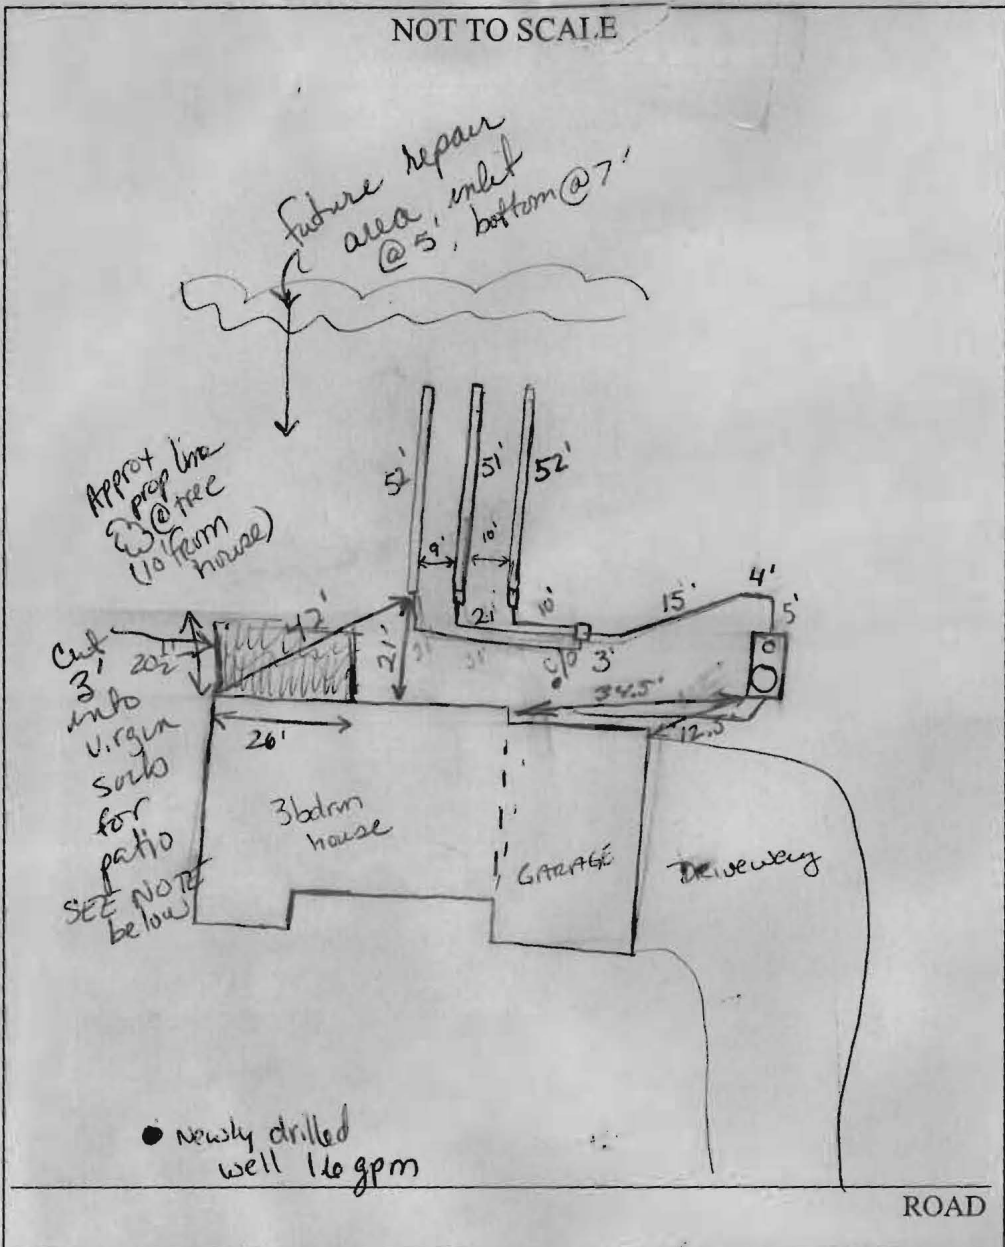

TRENCH/DRAINFIELD DATA		
WIDTH	INLET	BOTTOM
5'	4	7'
NUMBER OF TRENCHES		<del>190</del> 3
TOTAL LENGTH		155'
ABSORPTION AREA		
DISTRIBUTION BOX LEVEL		Levelers
DISTRIBUTION BOX BAFFLE		NO
DISTRIBUTION BOX PORT		No

SEPTIC TANK DATA	
SEPTIC TANK 1 LEVEL	Yes
CAPACITY	2000 GAL
SEAM LOC	Top
TANK LID DEPTH	3'
BAFFLES	MID BAFFLE IN Outlet
BAFFLE FILTER	
MANHOLE LOC	
6" PORT LOC	
WATERTIGHT TEST	—
SEPTIC TANK 2 LEVEL	
CAPACITY	_____ GAL
SEAM LOC	_____
TANK LID DEPTH	_____
BAFFLES	_____
BAFFLE FILTER	_____
MANHOLE LOC	_____
6" PORT LOC	_____
WATERTIGHT TEST	_____

PRE-CONSTRUCTION \_\_\_\_\_

INSTALLATION \_\_\_\_\_

12/23/05 OK to cover everything after the tank. Needs manhole cover and 6" cleanout. Also needs tied into house ok to use a long sweep w/ cleanout to turn into tank. Also asked Gil to have installed put hydraulic cement on middle wall where it cracked. (GAC)

12/27/05 Soils excavated for patio. cl explained how patio would need minimum 10' sep. distance but due to the cut

FINAL INSPECTOR David Hughes DATE OF APPROVAL 3/23/06


25' is more appropriate. Explained potential problems for bleedout. Concerned about future repair area - may require shorter trenches & micro-AST tank, or possibly lower inlet to 5' w/ bottom @ 7'

# WALL CHECK

PROPERTY OF JEFFERY AND KIRSTEN SCHULTZ

LIBER 3975 FOLIO 501 PARCEL 122 TAX MAP 6 GRID 10

*11/22/05  
Wall Check OK per  
Mike Davis  
GA*

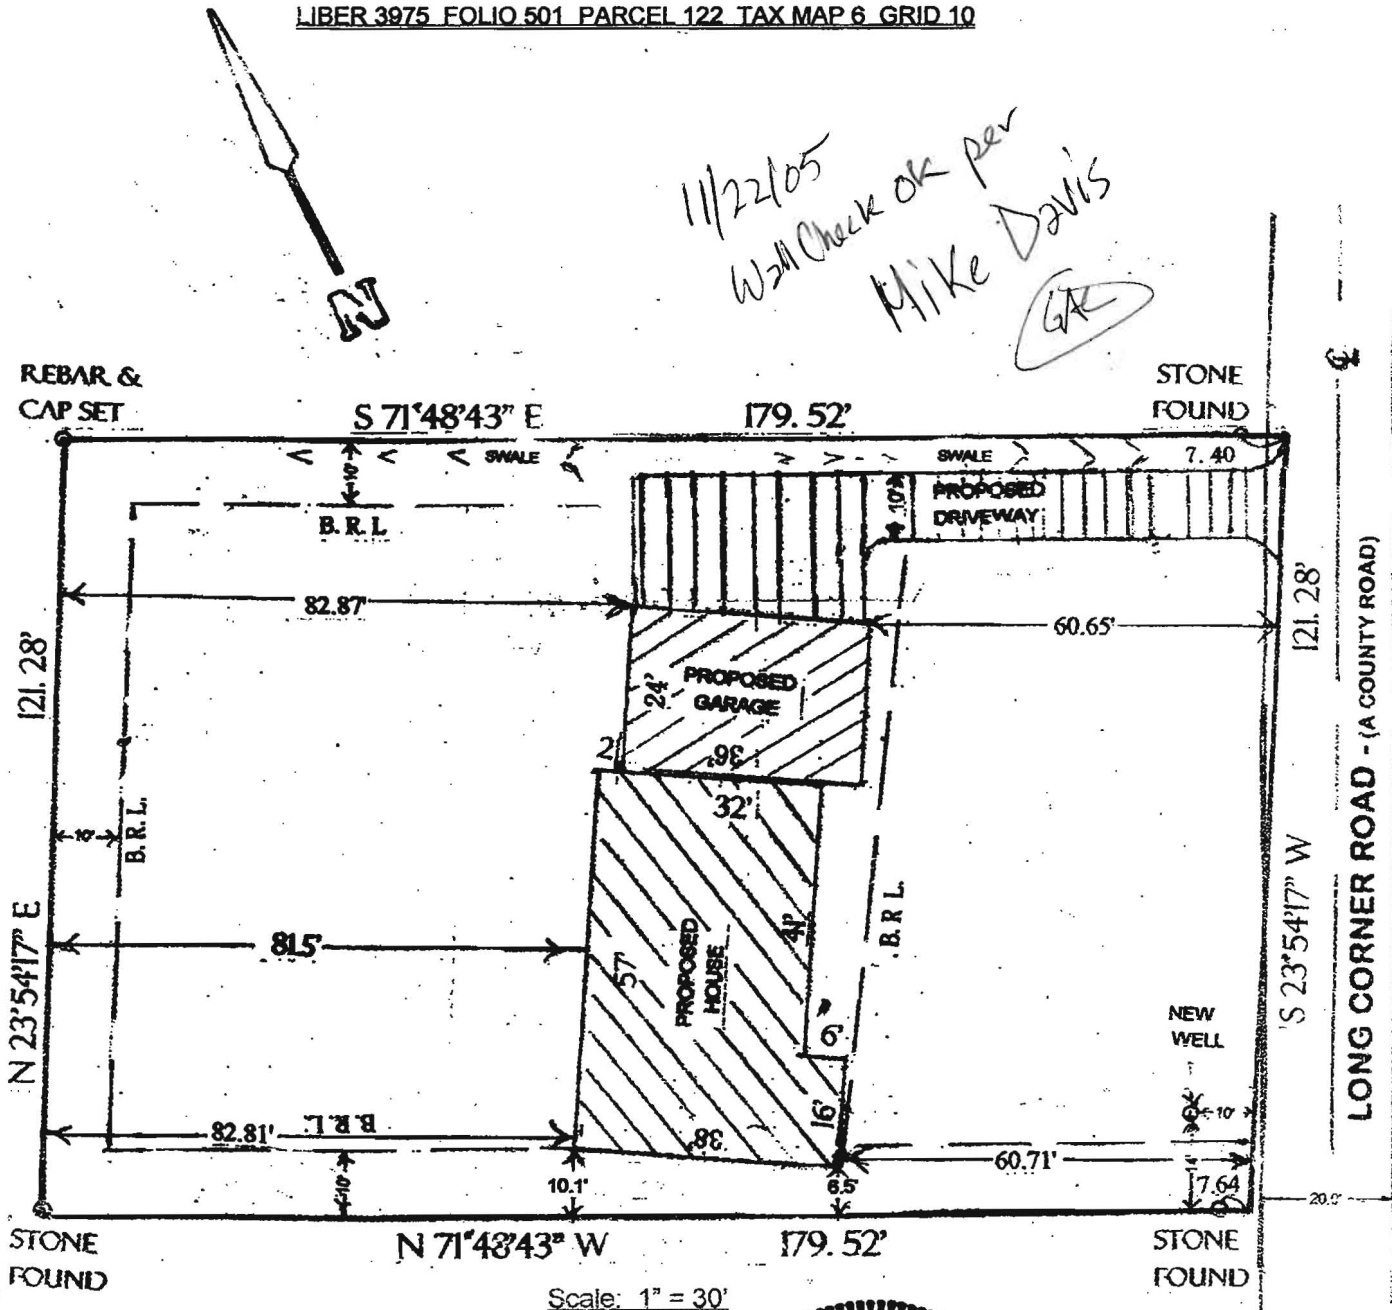


PROPERTY ADDRESS: 1510 LONG CORNER ROAD - MT. AIRY, HOWE COUNTY, MARYLAND ELECTION DISTRICT 4

### CERTIFICATE

I HERBY DECLARE THAT THE POSITION OF ALL THE VISIBLE EXISTING IMPROVEMENTS SHOWN ON THE ABOVE DESCRIBED PROPERTY HAVE BEEN ESTABLISHED BY PROPER FIELD METHODS. NO TITLE REPORT HAS BEEN FURNISHED. SUBJECT TO ANY AND ALL RESTRICTIONS AND EASEMENTS OF RECORD.

*Fred L. Skelton*  
FRED L. SKELTON

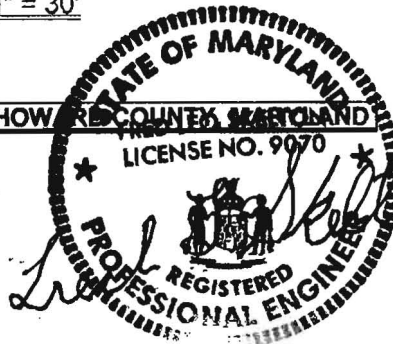


Fred L. Skelton, September, 2005  
3517 Falling Green Rd. Olney, Md. 20832  
Phone: (301) 924-5117 License # 9070

# WALL CHECK

PROPERTY OF JEFFERY AND KIRSTEN SCHULTZ

LIBER 3975 FOLIO 501 PARCEL 122 TAX MAP 6 GRID 10

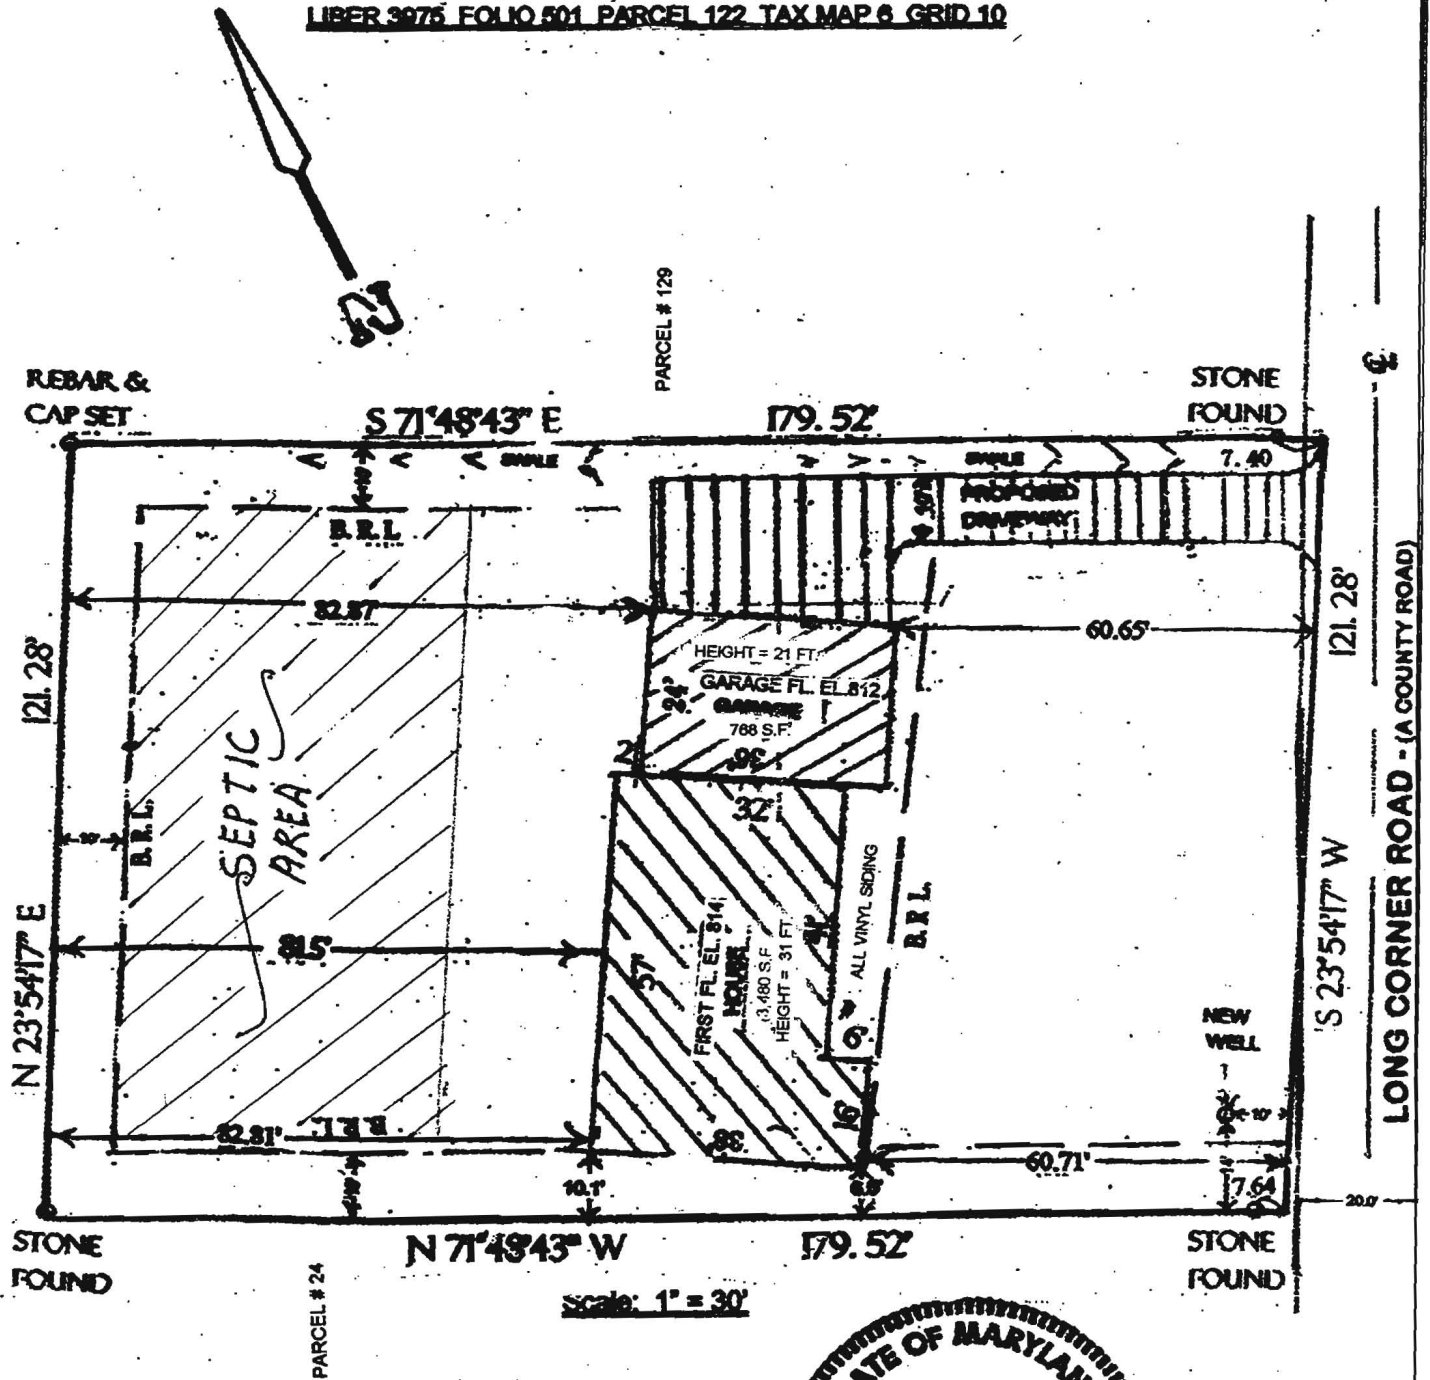


PROPERTY ADDRESS: 1610 LONG CORNER ROAD - MT. AIRY, HOWARD COUNTY, MARYLAND, ELECTION DISTRICT 4.

### CERTIFICATE

I HEREBY DECLARE THAT THE POSITION OF ALL THE VISIBLE EXISTING IMPROVEMENTS SHOWN ON THE ABOVE DESCRIBED PROPERTY HAVE BEEN ESTABLISHED BY PROPER FIELD METHODS. NO TITLE REPORT HAS BEEN FURNISHED. SUBJECT TO ANY AND ALL RESTRICTIONS AND EASEMENTS OF RECORD.

*Fred L Skelton*  
FRED L. SKELTON

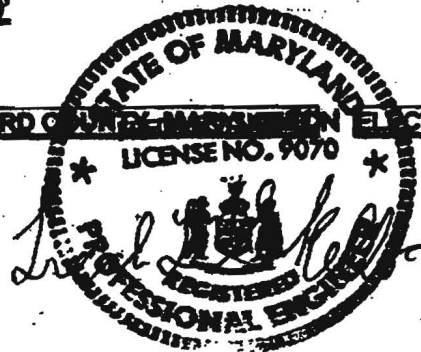

Fred L. Skelton, September, 2005  
3617 Falling Green Rd. Olney, Md. 20832  
Phone: (301) 924-5117 License # 9070