

PUB. SEWER STATUS VERIFIED BY _____

ISSUE DATE: 01/04/05

P 521640-A

APPROVAL DATE: 1/19/05

PERMIT
INDEXED

A REPAIR

02201399

ON-SITE SEWAGE DISPOSAL SYSTEM
HOWARD COUNTY HEALTH DEPARTMENT
BUREAU OF ENVIRONMENTAL HEALTH

Fyock Septic Service IS PERMITTED TO INSTALL ALTER

ADDRESS: PO Box 89, Glenelg, MD 21737 PHONE NUMBER: 410-531-2939

SUBDIVISION: _____ LOT NUMBER: _____

ADDRESS: 4705 Manor Lane PROPERTY OWNER: Dillion

SEPTIC TANK CAPACITY (GALLONS): 1500 (2-Comp)

PUMP CHAMBER CAPACITY (GALLONS): _____

NUMBER OF BEDROOMS: 3

SQUARE FEET PER BEDROOM: _____

LINEAR FEET OF TRENCH REQUIRED: 100'-115'

Inlet 5'
Bottom 9.5'
Trenches 2' wide

TRENCHES:	Trench to be <u>2</u> feet wide. Inlet feet below original grade. Bottom maximum depth feet below original grade. Effective area begins at feet below original grade. feet of stone below distribution pipe.
LOCATION:	
PURPOSE:	Existing septic system has failed. Call for inspection when ground is opened so sanitarian can recommend repair.

PLANS APPROVED: KN DATE: 12/29/05

- NOTE: PERMIT VOID AFTER 2 YEARS
- NOTE: CONTRACTOR RESPONSIBLE FOR SCHEDULING A PRE-CONSTRUCTION INSPECTION FOR ALL INSTALLATIONS
- NOTE: WATERTIGHT SEPTIC TANKS REQUIRED
- NOTE: ALL PARTS OF SEPTIC SYSTEM SHALL BE 100 FEET FROM ANY WATER WELL
- NOTE: MANHOLE RISERS REQUIRED ON ALL SEPTIC TANKS AND PUMP CHAMBERS


NEITHER THE HOWARD COUNTY COUNCIL OR THE HEALTH DEPARTMENT IS RESPONSIBLE FOR THE SUCCESSFUL OPERATION OF ANY SYSTEM PERMITTEE RESPONSIBLE FOR OBTAINING FINAL APPROVAL ON THIS PERMIT

BUILDING PERMIT SIGNED AND RETURNED

2105 B00150880-SHEP + WORKSHOP

521640-A

NOT TO SCALE

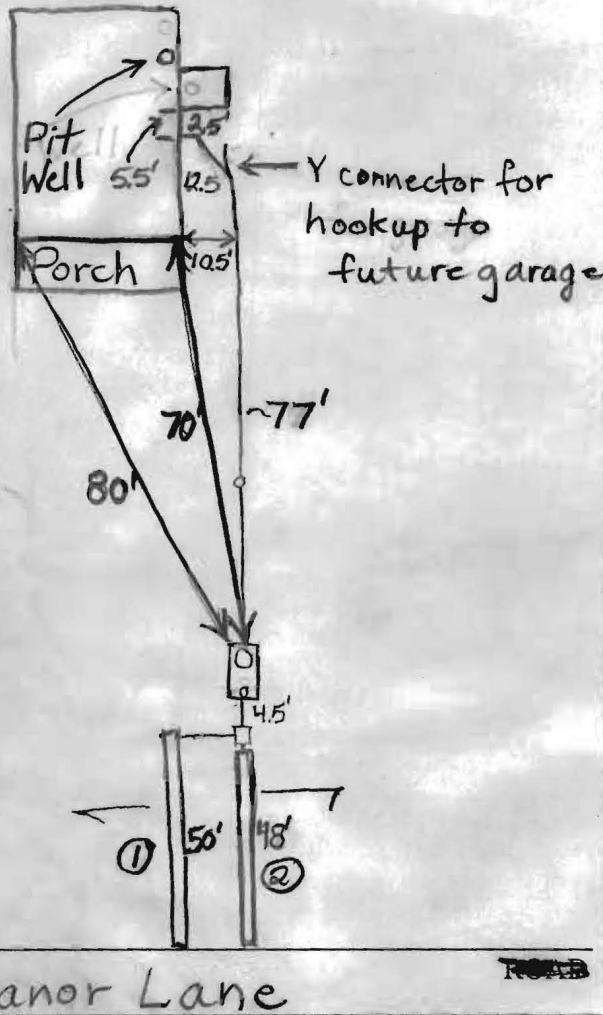

TRENCH/DRAINFIELD DATA		
WIDTH	INLET	BOTTOM
2'	5'	10'
NUMBER OF TRENCHES		2
TOTAL LENGTH		98'
ABSORPTION AREA		392' of sidewalk
DISTRIBUTION BOX LEVEL		Yes
DISTRIBUTION BOX BAFFLE		
DISTRIBUTION BOX PORT		No

SEPTIC TANK DATA		
SEPTIC TANK 1 LEVEL		✓
CAPACITY	1500	GAL
SEAM LOC	Top	
TANK LID DEPTH	2.5'	
BAFFLES	Yes	
BAFFLE FILTER	No	
MANHOLE LOC	Front	
6" PORT LOC	Rear	
WATERTIGHT TEST	No	
SEPTIC TANK 2 LEVEL		N/A
CAPACITY		GAL
SEAM LOC		
TANK LID DEPTH		
BAFFLES		
BAFFLE FILTER		
MANHOLE LOC		
6" PORT LOC		
WATERTIGHT TEST		

PRE-CONSTRUCTION 12/29/04 Install 2 trenches downhill of the perc test hole and near the driveway. Pump out and fill in the existing cesspool. Need 1500 gallon compartmented tank. Total trench length should be 100'-115'. BB

1/19/05 Robert installed trenches on top of small knoll instead of near driveway. Trench 1 is now somewhat uphill of neighbor's house. Don't know where neighbor's well is. However, the soil looked very good and still 200+ feet from neighbor's property line. Cesspool pumped out and filled in per Robert.

FINAL INSPECTOR B. Baker DATE OF APPROVAL 1/19/05